

104153565

POLK COUNTY CORNER RESTORATION FORM

SECTION 7 TOWNSHIP 10 S RANGE 4 W W.M. BLM ID 153565

DLC _____ CORNER County Line Monument

DATE 4/8/2011 CORNER RESTORATION FIELD BOOK 200-12 PAGE 3

PREVIOUS RENEWALS / SURVEYS, ETC. _____ CONDITION REPORT
 CS 2629, 11527, 15402 _____ X _____ RENEWED
 Benton Co. Survey 10157 (134); G10500005 _____ UNRECORDED
 _____ SURVEYED IN

MONUMENT AND ACCESSORIES FOUND (CONDITION AND SOURCE)

I found the 1 1/2" X 36" iron pipe cited as being on the County Line by BCS 10157 (134). The top of the iron pipe was bent but the bottom 18" was straight and true. I also found a typical concrete County Line guard post N73°E, 1.45' from the found iron pipe. The concrete post is 9" X 9" at the base and 7' X 7" at the top, it is 27" high and it is leaning 0.15' to the north. The post has "Polk", "Benton" and "Co Line" engraved on it. Also, a 3" brass cap is embedded in the top of the concrete post. The cap is stamped; "U.S. COAST & GEODETIC SURVEY AND STATE SURVEY; STATION No. 7214; ELEVATION 215 FEET; 1929, 1934, 1941; RESET 1943".

MONUMENT SET (PROCEDURES AND DESCRIPTION)

I removed said iron pipe and in its place set a 2" X 30" iron pipe with a 2 1/2" brass cap flush with the ground.

NEW ACCESSORIES


- A 6" X 6" post with a "Welcome to Benton County" bears N73°E, 14.5'
- The west edge of pavement of Hwy 99W is east, 24.3'
- I set a carsonite post 1' west of the monument
- There were no trees available to use as bearing trees.

State Plane Coordinate (ORGN 83/96 (2002) in Int'l Feet)
 N= 396012.69 ft
 E= 7494786.85 ft


NOTES

The state plane coordinates given for this point are the result of ties made during the survey for county project 1021, point #21. See project file for more information.

MONUMENT DETAIL

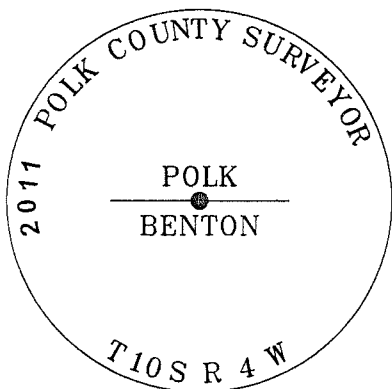

SKETCH

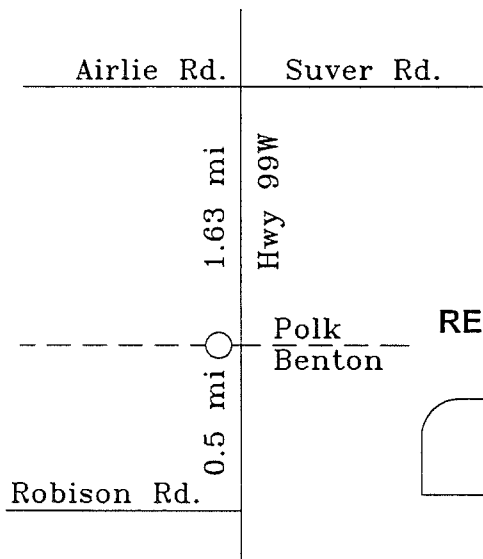

FIRM / AGENCY

Polk County Surveyors Office
 820 S.W. Ash St.
 Dallas, Oregon 97338
 (503) 623-9287

WITNESS Jim Killian, Roger Ray

RESTORATION NO.
 11883

REGISTERED
 PROFESSIONAL
 LAND SURVEYOR

ETB
 OREGON
 JANUARY 15 2002
 ERIC T BERRY
 61392