

106100220

10-6 30

ESTABLISHED CORNER FOR OREGON STATE BOARD OF FORESTRY

373

South one-sixteenth corner common to Sections 25 and 30, T. 10S., R. 6 and 7W., W.M., Benton County, Oregon

ESTABLISHED

Set 1 1/2" x 36" galvanized iron pipe with 3" bronze cap marked, "OREGON STATE BOARD OF FORESTRY S 1/16 S25 S30 1957 RE2311," 30 inches in ground, and from which a:


46" fir bears N61 1/2° W 36.4 ft.; scribed S 1/16 S25 BT RE2311

33" fir bears N38° E 53.0 ft.; scribed S 1/16 S30 BT.

Oregon State Board of Forestry metal location poster on 46" fir BT.
4" x 4" x 6' white painted cedar post 1.5 ft. NE of pipe.

Dated April 4, 1957

Established by D. C. Bagger under my direction.
D. C. Bagger, Engineer Aide

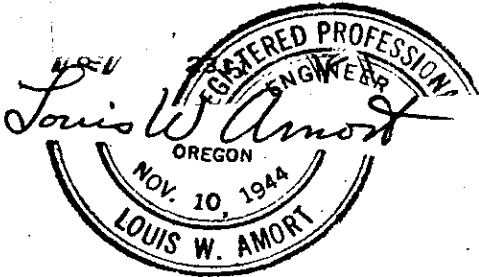

Present and witnessed by H. Baughn
B. Davis.