

107240500

DATE 01/13/2021TOWNSHIP 10 SOUTH, RANGE 7 WEST, WILLAMETTE MERIDIAN; SECTION 8 CORNER SOUTH 1/4
DONATION LAND CLAIM N/A CORNER N/A**COMMON CORNER(S):**

NORTH 1/4 CORNER SECTION 17

RECORDS (INFORMATION IN *BOLD ITALICS* IS COUNTY STAFFS' INTERPRETATION OF THE RECORD)

BASED ON EXTENSIVE RESEARCH AND RECOVERY OF EVIDENCE, THIS OFFICE HAS DETERMINED THAT MOST GENERAL LAND OFFICE SURVEYORS IN BENTON COUNTY BEFORE 1890 MEASURED TO THE FACE OF BEARING TREES.

- [01] GENERAL LAND OFFICE (GLO) NOTES BY DENNIS HATHORN, D.S., DATED DECEMBER 5, 1856. *SET POST FROM WHICH AN ALDER 6" DIA BEARS S85°W, 178 LINKS (117.48 FEET); ALDER 5" DIA BEARS N73°W, 133 LINKS (87.78 FEET).*
- [02] LOOSE LEAF FIELD NOTES FOR COUNTY ROAD NO. 17055, LABELED ROUTE #55, ROAD NO. 556, SEC 17, T10S, R7W, SKAGS ROAD, ALIGNMENT, BY W. C. GALLOWAY, C.S., NO DATE GIVEN. *SET 3/4" GALVANIZED PIPE, MOUND STONE, FROM AN ALDER 5" DIA (GLO BT) BEARS N73°W, 1.33 CHAINS (87.78 FEET). AN ALDER 28" DIA BEARS N47°E, 0.472 CHAINS (31.15 FEET); FIR 18" DIA BEARS N59-1/2°W, 0.517 CHAINS (34.12 FEET).*
- [03] BENTON COUNTY CORNER RESTORATION BOOK NO. 1, PAGE 200, BY W. C. GALLOWAY, C.S., DATED MAY 29, 1929. *SET 3/4" GALVANIZED PIPE AND MOUND OF STONE. AN ALDER 5" DIA (GLO BT) BEARS N73°W, 1.33 CHAINS (87.78 FEET), STANDING. ALDER 6" DIA (GLO BT) BEARS S85°W, 1.78 CHAINS (117.48 FEET), GONE. MARKED AN ALDER 28" DIA (CSBT) BEARS N47°E, 0.472 CHAINS (31.15 FEET); MARKED FIR 18" DIA BEARS N59-1/2°W, 0.517 CHAINS (34.12 FEET).*
- [04] BENTON COUNTY CORNER RESTORATION NO. 472, ALSO FILED AS POLK COUNTY CORNER RESTORATION NO. E-67. *TRANSCRIBED FROM RECORD [03] AND MAY CONTAIN ERRORS AND/OR OMISSIONS.*
- [05] BENTON COUNTY MAP NO. 10-7-00002 BY W. C. GALLOWAY, C.S., NO DATE GIVEN, ALSO FILED AS POLK COUNTY SURVEY NO. 5679. *3/4" GALVANIZED PIPE AND MOUND OF STONE. ALDER 5" DIA (GLO BT) BEARS N73°W, 1.33 CHAINS (87.78 FEET), STANDING. ALDER 28" DIA (CSBT) BEARS N47°E, 0.472 CHAINS (31.15 FEET); FIR 18" DIA BEARS N59-1/2°W, 0.517 CHAINS (34.12 FEET).*
- [06] BENTON COUNTY SURVEY NO. 1368 (OLD NO. 349) FIELD NOTES (FIELD BOOK 45, PAGE 21) BY W. C. GALLOWAY, C.S., DATED FEBRUARY 18, 1938. *CORNER NOT DESCRIBED.*
- [07] RESTORED CORNER FOR OREGON STATE BOARD OF FORESTRY, BY ARNOLD G. GIBSON, P.L.S., DATED APRIL 22, 1958. *FOUND 3/4" IRON PIPE IN STONE MOUND FROM WHICH AN ALDER 30" DIA (CSBT) BEARS N47°E, 47.2 LINKS (31.15 FEET), SCRIBES "CS BT" VISIBLE; FIR 36" DIA (CSBT) BEARS N59-1/2°W, 51.7 LINKS (34.12 FEET), FACE COVERED. SET 1-1/2" X 36" GALVANIZED IRON PIPE WITH 3" BRONZE CAP MARKED "OREGON STATE BOARD OF FORESTRY 1/4 S8 S17 1958 RS359", 32" IN GROUND OVER 3/4" PIPE, IN MOUND OF STONE, FROM WHICH FIR 36" DIA (CSBT) BEARS N59-1/2°W, 34.1 FEET, SCRIBED "BT"; ALDER 22" DIA BEARS S68°W, 78.4 FEET, SCRIBED "1/4 S17 BT RS359". SET 4" X 4" X 72" WHITE PAINTED CEDAR POST 1 FOOT SOUTHEAST OF PIPE.*
- [08] BENTON COUNTY CORNER RESTORATION NO. 472, ALSO FILED AS POLK COUNTY CORNER RESTORATION NO. E-67. *TRANSCRIBED FROM RECORD [07] AND MAY CONTAIN ERRORS AND/OR OMISSIONS.*
- [09] BENTON COUNTY SURVEY NO. 3515 BY ARNOLD G. GIBSON, P.L.S., DATED MAY, 1961. *CORNER NOT DESCRIBED.*
- [10] BENTON COUNTY SURVEY NO. 8833 BY JIM S. PETERSON, P.L.S., DATED MAY 3, 1994. *FOUND AN OSDF BRASS CAP IN MOUND OF STONE MARKED "T10S R7W 1/4 S8 S17 1958". FOUND FIR 54" DIA (CSBT) BEARS N59-1/2°W, 34.1 FEET, HEALED FACE; ROTTED ALDER REMAINS BEARS S68°W, 78.4 FEET; DEAD TOPPED ALDER 30" DIA (CSBT) BEARS N47°E, 0.472 CHAINS (31.15 FEET), BARK SCRIBING VISIBLE. SET ALDER 10" DIA BEARS S22°E, 15.2 FEET, MARKED "1/4 S17 BT" IN BARK; FIR 12" DIA BEARS S70°W, 45.9 FEET, MARKED "1/4 S17 BT". SET WHITE 4" X 4" POST 0.5 FEET NORTH.*

FIRM/AGENCY: BENTON COUNTY SURVEYOR'S OFFICE
ADDRESS: 360 S.W. AVERY AVE., CORVALLIS, OR 97333; PH. 541-766-6821
RESEARCH BY: DAVID L. MALONE, P.L.S.
DATA ENTRY BY: SAME

CORNER RESTORATION BOOK NO. 1

C.S. 134 cont.
By W.C. Galloway
Witnesses

Jos. C. Smith
John
Emile E. Lorkin
March 6, 1933.

$\frac{1}{4}$ Sec. Corner bet secs. 7 and 18 T. 10 S. R. 5 W. W. M.
Set a Stone 6"x8"x10"
Fir 12" N. 33° 40' W. .24 std. (N 32½° W. 24 by needle) Now 20" in dia.
Marked " 36" N. 8° 20' E. .680 (N. 9° 30' E. by needle) This tree is mhd c.s. 29 on S
" " 36" N. 71° E. .353 (N. 72° E by needle) This tree is marked c.s. 29 on N.
" Maple 10" S. 51° E. .280 (S. 50° E by needle) Sprout of orig. maple

W.C.
Dec. 1
Jan. 1
D.H.
P.P. &
July 18

Witnesses as above
March 7, 1933.

$\frac{1}{4}$ Sec. Corner bet. secs 17 and 18 T. 10-5
Set a $\frac{3}{4}$ " Galvanized pipe
Fir 5" S. 55° W. .33 std. Now about 18", Oak 12" N. 58° E. 30 down.
" 18" S. 48° E. .166

Witness
John W.
and D.
Dec. 1

C.S. 134 cont.
Witness as above
March 9, 1933.

Corner to Sections 7, 8, 17 and 18 T. 10-5
Set $\frac{1}{2}$ " Galvanized pipe Set from
Fir 15" N. 68° E. .174 Oak N. 68° E. 1.063 dead std.
" 11" S. 36° E. .440 " 30° S. 89° W. .65 " down.
" 34" S. 59° W. .166 " 26" N. 75° W. .74 " std.
" 10" N. 37½° W. .321

W.C.
Witness
E.E.
Dec

C.S. 134 cont.
by W.C. Galloway
Witness. E. E. Lorkin

$\frac{1}{4}$ Section Corner bet. Secs. 8 and 17, T 10-5
Set $\frac{3}{4}$ " Galv. pipe. stake near
Oak 16" N. 52° W. .67 down found two blazes, figures gone.
" 24" S. 36° E. 1.58 " blaze burned out
Mhd. fir 20" N. 52½° E. .172
" " 20" S. 23° W. .122
" " 24" N. 73½° W. .222

C.S. Co. Road 556
By W.C. Galloway
Witnesses
Harold Gellally
James Trapman
May 29, 1929.

$\frac{1}{4}$ Section Corner Between Secs. 8 & 17 T 10-7
Set $\frac{3}{4}$ " Galvanized pipe & mound of stone
An Alder 5" N. 73° W. 1.33 std. (Alder 6" S 85° W. 1.74 gone)
Mkd. " " 28° N. 47° E. .472 cts.
" fir 18" N. 59½° W. .517 "



C.S. Road Change
Witness
Emile E. Lorkin
1932

N.W. Corner of Elijah Liggett C1. 39 & 52 T. 12 S. R. 5 & 6 W.
Orig. Stone 6"x10"x24" trees gone
Oak 15" S. 65° E. 1.015
" 8" N. 38½° W. .476
¾" Pipe N. 1° 26' W. 1.577

C.S. # 27
F.M. Wilkes
Frank Burnap
Nov. 10, 1908

N.E. Corner of Eldridge Hartless C1. 51 T 12-6
Set $\frac{3}{4}$ " Pipe
Oak 30" S. 45° W. .16 std.
" 12" N. 60° W. .12

C.
W.C.
Wita

Emile
M.E.

C.
Witness

1/4-Section corner between sections 8 and 17, Twp. 10-7

472

Reestablishment by W. C. Galloway

4/22/58

May 29, 1929

Set 3/4" galvanized pipe and mound of stone

Alder 5" in diam bears N 73° W

1.33 chains

Alder 28" in diam bears N 47° E (now 30")

.472 chains

Fir 18" in diam bears N 59 1/2° W (now 36")

.517 chains

Witness E. E. Larkin

Reestablishment by Arnold G. Gibson

April 22, 1958

Set 1 1/2" x 36" iron pipe with 3" cap, 32" in ground over 3/4" pipe

Fir 36" (Orig. 18") N 59 1/2° W 34.1 ft., metal location poster

Alder 22" S 68° W 78.4 ft.

Set 4 x 4 x 72" cedar post 1 ft. SE of pipe

Witnesses David Steenson, C. Skog

FOR ADDITIONAL INFORMATION SEE THE T10S R7W FILE IN THE CORNER
RESTORATION FILE DRAWER (CJL 7/12/90).
CORRESPONDENCE

BENTON COUNTY RESTORATIONS

1/4-Section corner between sections 8 and 17, Twp. 10-7

Reestablishment by W. C. Galloway

4/22/58

May 29, 1928

Set 3/4" galvanized pipe and mound of stone

Alder 5" in diam bears N 73° W

1.33 chains

Alder 28" in diam bears N 47° E (now 30")

.472 chains

Fir 18" in diam bears N 59 1/2° W (now 36")

.517 chains

Witness E. E. Larkin

Reestablishment by Arnold G. Gibson

April 22, 1958

Set 1 1/2" x 36" iron pipe with 3" cap, 32" in ground over 3/4" pipe

Fir 36" (Orig. 18") N 59 1/2° W 34.1 ft., metal location poster

Alder 22" S 68° W 78.4 ft.

Set 4 x 4 x 72" cedar post 1 ft. SE of pipe

Witnesses David Steenson, C. Skog

BENTON COUNTY SURVEYORS OFFICE - CORNER RESTORATION

T 10S, R 7, W. B. & M., BENTON COUNTY


SECTION 9, 10

REPORTED BY Wiljo E. Green

TITLE PLO 563

DATE Dec. 1, 1968

CS 5834

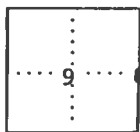

● OFFICIAL CORNER FOUND

○ CORNER SET

1/4 CORNER COMMON TO SEC. 9 AND 10

IS STONE, IRON ROD, IRON PIPE, BRASS CAP OR OTHER SIZE

LEGIBLE MARKS ON BEARING OBJECTS



KIND	Fir	Fir	
SIZE	48"	18"	
BEARING	S14 1/2° E	S89 1/2° W	
DISTANCE	108.0	46.0	
DISTANCE			
TAG POSTED		yes	

ADDITIONAL INFORMATION

Reestablished.

RESTORED CORNER FOR OREGON STATE BOARD OF FORESTRY

One quarter corner common to Sections 8 and 17,
T. 10S, R. 7W, W.M., Benton County, Oregon.

ORIGINAL

Post (now missing) from which a:

- 6" Alder bears S85W 178 lks.; now missing.
- 5" Alder bears N73W 133 lks.; now missing.

RESTORATION by W. C. Galloway May 29, 1929.

3/4" iron pipe in stone mound (found in place) from which a:

- 28" Alder bears N47E 47.2 lks.; now 30", scribes CS BT visible.
- 18" Fir bears N59 1/2 W 51.7 lks.; now 36", face covered.

RESTORED

Var. 21E

Set 1 1/2" x 36" galvanized iron pipe with 3" bronze cap marked "OREGON STATE BOARD OF FORESTRY 1/4 S8 S17 1958 RS359," 32 inches in ground over 3/4" pipe, in mound of stone, and from which a:


- 36" Fir (Orig. 18") bears N59 1/2 W 34.1 ft.; scribed BT.
- 22" Alder bears S68W 78.4 ft.; scribed 1/4 S17 BT RS359.

Set 4 x 4 x 72" white painted cedar post 1' SE of pipe.

Oregon State Board of Forestry metal location poster on 36" Fir BT.

Dated April 22, 1958

Restored by David Steenson under my direction.
David Steenson, Engineering Aide

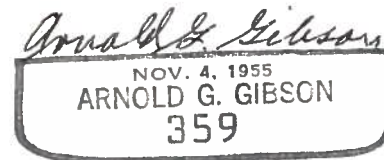

Present and witnessed by Clarence Skog