

C.S. 349

by W.C. Galloway  
Adrian Seits  
Geo. Grider and  
W.P. Lewis  
Feb. 19, 1938  
and 23, 1938

Corner to Sections 5, 6, 7 & 8 T 10 S. R. 7 W. W M  
Set a 1/4" pipe from original trees (Corner should have been about 4.00 chs. N. and 2.17 West)  
Found piece of fir limb, probably part of orig. stake. Pipe is 1/4", 5' long, 4' inground.  
A fir snag 70" in dia. bears S. 88° E. .56 chs. no marks. [snag  
" " green 14" " " " S. 15° E. .50 " broken over 4' snag. Tree on  
Burned snag 48" " " " S. 65° W. .54 " found BT & notch  
" " 50" " " " N. 20° W. .30 " no marks.

Witnesses  
as above

Feb. 25, 1938  
Snow on ground  
for entire  
survey.

1/4 Sec. Corner between secs. 7 & 8 T 10-7  
Set a 3/4" pipe from burned snag 50" N. 3° E. 2.50 chs.  
and stump hole S. 6° W. .62 "  
We tried to match trees north and west and east. A stake was set  
in the vicinity of this corner, but did not correspond to trees  
Creeks tally with these corners or nearly correct.  
We marked a fir 6" in dia. N 89° 20' E. 2.415 chs. to center  
" " " " 4" " S. 39° 30' W. 1.370 " " "

Witnesses as  
above

Feb. 23, 1938

1/4 sec. corner between secs. 5 & 8 T 10-7  
Found orig. fir for corner; drove nail on east side .018 E. of center.  
Found 1/4 S. on east side of corner tree.  
" " 1/4 S " fir 8" S. 55° E. .123  
" hole for " 10" N. 40° W. .03  
Marked fir 32" in dia. S. 77° E. .235 chs. mark on S. for measure  
We found lots of blazed trees along north line of the section.  
That is how I found this corner, it being so far from correct place.

Witnesses as  
above

Feb. 28, 1938

1/4 Sec. Corner between sections 8 & 9 T 10-7  
Set 1" shaft from B. fir 40" S. 75° W. 1.32 lks.  
and B. " 40" N. 60° E. 48 "  
Mkd. fir 22" in dia. S. 41° W. .279 chs. mark H.W. for measure.  
" " 48" " " N. 17° W. .631 " " S.W. " "

C.S. 272

by W.C.G.  
Witnesses  
Rudolph Stewart  
Frank Beltger.  
E. Albertson  
Jan. 12, 1938.

Corner to Sections 22, 23, 26 and 27 T 10-7  
Set Car. axle  
Fir 50" in dia. bears N. 60° E. .55 chs. spike S.E. for measure  
" (50) was 9" " " S. 1° E. 1.92 " " N. " "  
Mkd. fir 14" in " " S. 29° W. .220 " " E. center  
" " 11" " " N. 72° W. .083 " " S. "  
Stub of " N. 49° W. 1.42 "

1/4 Sec. Corner bet. Secs. 23 & 26 T 10-7

Set 3/4" Steel cam shaft  
Fir 40" in. dia. bears N. 69° E. .32 chs. to spike S. for measure  
" 30" " " " S. 53° W. .93 " " " S. " "

$\frac{1}{4}$ -Section corner between sections 5 and 8, Twp. 10-7

463

Reestablishment by W. C. Galloway

Feb. 23, 1938

Found original Fir for corner, drove nail on east side .018 chains E. of cen  
Found  $\frac{1}{4}$  S on east side of corner tree  
Found  $\frac{1}{4}$  S on Fir 8" in diam S 55° E .123 chains  
Found hole for Fir 10" in diam N 40° W .03 chains  
Fir 32" in diam bears S 77° E .235 chains  
Found lots of blazed trees along north line of the section. That is how I  
found this corner, it being so far from correct place.

BENTON COUNTY SURVEYORS OFFICE - CORNER RESTORATION

464


T. 10 S. R. 7 W. W. B. & M., BENTON COUNTY, OREGON

SECTION 5

REPORTED BY Miljo E. Green

TITLE Land Surveyor

DATE October 18, 1965

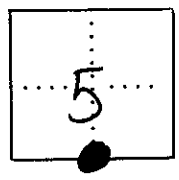

- OFFICIAL CORNER FOUND
- CORNER SET

1/4 CORNER COMMON TO SEC. 5 -- -- & 8  
 IS 3/4" x 48" iron rod IN CENTER OF 24" FIR STUB  
DESCRIBE

ADDITIONAL INFORMATION

Set 4" x 4" x 72" white painted cedar post  
 20 ft S.E. of corner pipe.

FND: 24" (6") FIR STUB BADLY DETERIORATED WITH PORTION OF  
 AN OLD FACE ON EAST SIDE, NO SCRIBES VISIBLE, OLD  
 P+E MARKS ON WEST SIDE

FND: 8" FIR BEARS S75°E 10LKS; NOW 28" STUMP, TWO  
 FACES AND SCRIBES BT VISIBLE (12.4 FEET, DISTANCE).

FND: 18" FIR STUMP, S17W 7.6 FT. WITH FACE AND SCRIBES  
 CS 349 VISIBLE.  
 (CJL 7/11/90)

OVER

LEGIBLE MARKS ON BEARING OBJECTS

	1/4S5	1/4S8		
	B.T.	B.T.		
	Rs 563			
KIND	Fir	Fir		
SIZE	7"	5"		
BEARING	N50°W	S35°E		
DISTANCE	27.2ft	6.4 ft		
BT TAG POSTED				

107240600

REWITNESSED CORNER FOR STATE OF OREGON--DEPARTMENT OF FORESTRY

347

38

One quarter corner common to Sections 5 and 8, T10S,  
R7W, W.M., Polk County, Oregon.

ORIGINAL

6" Fir (now 24" stub badly deteriorated with portion of an old face on East side, no scribes visible, old axe marks on West side, 3/4" x 48" iron rod in center of stub) from which an:

8" Fir bears S75E 10 lks.; now 28" stump, two faces and scribes BT visible (14.4 feet, distance).

10" Fir bears N40W 3 lks.; now missing.

Found an 18" Fir stump S17W 7.6 ft. with face and scribes CS349 visible.



SEE COR. REST.-NO.  
464 (CJL 7/11/90)

① REWITNESSED

7" Fir bears N50W 27.2 ft.; scribed 1/4 S 5 BT RS563.

5" Fir bears S35E 6.4 ft.; scribed 1/4 S 8 BT.


Set 4" x 4" x 72" white painted Cedar post 20 ft. SE of corner pipe. Oregon State Forestry Department metal location poster on 5" Fir BT.

Dated October 18, 1965.

Rewitnessed by



*Wiljo E. Green*

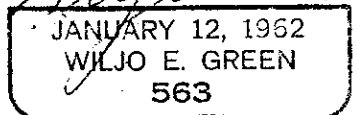

Present and witnessed by T. R. South

At the section corner common to Secs. 21, 22, 27 and 28, T. 7 S., R. 6 W., W.M.,

Polk County, Oregon