

107440300

DATE 09/08/2017TOWNSHIP 10 SOUTH, RANGE 7 WEST, WILLAMETTE MERIDIAN; SECTION 22 CORNER SOUTH 1/4
DONATION LAND CLAIM N/A CORNER N/ACOMMON CORNER(S):
NORTH 1/4 CORNER SECTION 27**RECORDS (INFORMATION IN BOLD /ITALICS IS COUNTY STAFFS' INTERPRETATION OF THE RECORD)**

BASED ON EXTENSIVE RESEARCH AND RECOVERY OF EVIDENCE, THIS OFFICE HAS DETERMINED THAT MOST GENERAL LAND OFFICE SURVEYORS IN BENTON COUNTY MEASURED TO THE FACE OF BEARING TREES.

- [01] GENERAL LAND OFFICE (GLO) NOTES BY DENNIS HATHORN, D.S., DATED AUGUST 26, 1856. SET POST FROM WHICH A FIR 50" DIA BEARS S51°W, 86 LINKS (56.76 FEET); A FIR 40" DIA BEARS N32°W, 170 LINKS (112.20 FEET).
- [02] BENTON COUNTY SURVEY NO. 1590 (OLD NO. 272) FIELD NOTES (FIELD BOOK 46, PAGE 73) BY W. C. GALLOWAY, C.S., DATED SEPTEMBER 29, 1942. SET CONCRETE POST 7" X 26". CEDAR 18" DIA BEARS S40°06'E, 1.812 CHAINS (119.59 FEET); FIR 8" DIA BEARS S87°20'W, 3.335 CHAINS (220.11 FEET).
- [03] BENTON COUNTY CORNER RESTORATION BOOK NO. 1, PAGE 232, BY W. C. GALLOWAY, C.S., DATED SEPTEMBER 29, 1942. SET A CONCRETE POST 7" X 7" X 26"; 1/2 WAY BETWEEN SECTION CORNERS. CEDAR 18" DIA (CSBT) BEARS S40°06'E, 1.812 CHAINS (119.59 FEET); FIR 8" DIA (CSBT) BEARS S87°20'W, 3.335 CHAINS (220.11 FEET) TO CENTER OF STRAIGHT PART.
- [04] BENTON COUNTY CORNER RESTORATION NO. 544. TRANSCRIBED FROM RECORD [03] AND MAY CONTAIN ERRORS AND/OR OMISSIONS.
- [05] BENTON COUNTY SURVEY NO. 1615 (OLD NO. 272) FIELD NOTES (FIELD BOOK 46, PAGE 79) BY W. C. GALLOWAY, C.S., DATED MARCH 18, 1943. CONCRETE POST.
- [06] BENTON COUNTY MAP NO. 10-7-00006, NO DATE OR DRAFTSMAN GIVEN. CONCRETE POST 7" X 26". CEDAR 18" DIA (CSBT) BEARS S40°06'E, 1.812 CHAINS (119.59 FEET); FIR 8" DIA (CSBT) BEARS S87°20'W, 3.335 CHAINS (220.11 FEET).
- [07] BENTON COUNTY MAP NO. 10-7-00011, NO DATE OR DRAFTSMAN GIVEN. CONCRETE POST 7" X 26". CEDAR 18" DIA (CSBT) BEARS S40°06'E, 1.812 CHAINS (119.59 FEET); FIR 8" DIA (CSBT) BEARS S87°20'W, 3.335 CHAINS (220.11 FEET) STRAIGHT PART.
- [08] BENTON COUNTY SURVEY NO. 3649 (NOTES AND MAP) BY ELBERT DRIVER, P.L.S., DATED APRIL 24, 1962. 7" X 26" CONCRETE POST FOUND IN PLACE FROM WHICH A CEDAR 24" DIA (CSBT) BEARS S40°06'E, 181.2 LINKS (119.59 FEET), FACE GROWN OVER; FIR 20" DIA (CSBT) BEARS S87°20'W, 333.5 LINKS (220.11 FEET), PORTION OF SCRIBES VISIBLE ON PARTLY GROWN OVER FACE. SET 4" X 4" X 72" WHITE PAINTED CEDAR POST 1.0 FEET NORTHEAST OF CONCRETE POST FROM WHICH A FIR 5" DIA BEARS S20°E, 27.7 FEET, SCRIBED "1/4 S27 BT RS559".
- [09] BENTON COUNTY CORNER RESTORATION NO. 544. TRANSCRIBED FROM RECORD [08] AND MAY CONTAIN ERRORS AND/OR OMISSIONS.
- [10] BENTON COUNTY CORNER RESTORATION NO. 3167 BY MALCOLM HIATT, STARKER FORESTS INC., DATED AUGUST 30, 1983. FOUND 7" X 26" CONCRETE POST. FOUND 4" X 4" X 72" WHITE PAINTED CEDAR POST 1.0 FEET NORTHEAST OF CONCRETE POST. FOUND FIR 14" DIA BEARS S20°E, 27.7 FEET, SCAR AND NO OTHER MARKS. PLACED A WHITE 5 FOOT FIBERGLASS POST 1.0 FEET SOUTHWEST OF CORNER.
- [11] BENTON COUNTY SURVEY NO. 8446 BY JIM S. PETERSON, P.L.S., DATED SEPTEMBER 6, 1990. FOUND 7" CONCRETE POST. CEDAR 36" DIA (CSBT) BEARS S40°E, 119.6 FEET, HEALED FACE; FIR 38" DIA (CSBT) BEARS S87°20'W, 220.1 FEET, HEALED FACE; FIR 22" DIA BEARS S20°E, 27.7 FEET, HEALED FACE.
- [12] BENTON COUNTY SURVEY NO. 9169 BY JIM S. PETERSON, P.L.S., DATED OCTOBER 16, 1996. FOUND 7" SQUARE CONCRETE POST. FOUND CEDAR 36" DIA (CSBT) BEARS S40°E, 119.6 FEET, HEALED FACE; FIR STUMP 38" DIA (CSBT) BEARS S87°20'W, 220.1 FEET, HEALED FACE; FIR 22" DIA BEARS S20°E, 27.7 FEET, HEALED FACE.

FIRM/AGENCY: BENTON COUNTY SURVEYOR'S OFFICE
 ADDRESS: 360 S.W. AVERY AVE., CORVALLIS, OR 97333; PH. 541-766-6821
 RESEARCH BY: DAVID L. MALONE, P.L.S.
 DATA ENTRY BY: SAME

232

BENTON COUNTY CORNER RESTORATION BOOK NO. 1

C.S. #
 by Witnesses
 Geo. Marks
 Armstrong & Son
 by W.C. Galloway, C.S.
 Sept. 29, 1942

1/4 Sec. Cor. bet. Secs. 22 and 27 T. 10 - 7
 Set a concrete post 7' x 7' x 26" 1/2 way bet. section corners.
 Cedar 18" in dia. bears S. 40° 06' E. 1.812
 Fir 8" " " S. 87° 20' W. 3.335 cks. to cen. of straight part.

1/4 Sec. Cor. bet. Secs. 25 and 26 T. 10 - 7
 Set a 1/2" galv. pipe 30" long from
 Fir 10" in dia. (now 66") bears S. 28° W. 85.8 ft = 130 cks. to spike N.
 " 7" " S. 52 1/2° E. 12.9' = 195 cks., blazed, and scribed

Corner to Secs. 23, 24, 25 & 26 T. 10 - 7
 Set a 1/2" galv. pipe 50" long from
 Fir 18" (now 66") in dia. bears N. 85° 40' E., N. 85° 51' E. 29' = 150 cks. to head of spike N. Witness
 " 40" (now 66") " " S. 75° 20' E., S. 78° 41' E. 47.52' = 72 " " " " N. Wells
 " 40" (now 66") " " S. 68° 30' W., S. 69° 50 1/2 W. 113' = 1712 " " " " N.
 " 10" (now 32") " " N. 80° W., N. 80° 57' W. 91.09' = 138 " " " " S.

C.S. # 316
 by W.C. Galloway
 Witnesses, Feb. 2, 1944
 Orvis Tandy
 Marvin Bennett

1/4 Sec. bet. Secs. 27 and 34, T. 11 S. R. 6 W.
 Set a car axle
 Oak 8" in dia. (now 22") bears N. 23° 20' E. 3.70 std. O.K.
 " 10" " (" 27") " S. 28° 10' W. 3.87 " "
 Mkd. " 11" " " N. 88° W. 1.076 cks.

1 March 4, 1944
 John Richard
 and Orvis Tandy
 Marvin Bennett

Corner to Secs. 26, 27, 34 & 35 T. 11 S. R. 6 W.
 Set a 1/2 of a buggy axle
 Oak 24" in diameter bears N. 18° W. 8.37 cks. Std. found letters
 " 15" " " N. 15° E. 6.20 " " good shape.
 Marked fir 3" " " N. 47 1/2° E. .145 "
 " 4" " " S. 38 1/2° W. .143 "
 " 4" " " S. 76 1/2° W. .501 "
 " 5" " " N. 12° W. .185 "

March 11, 1944
 Witnesses as above
 Orvis Tandy and
 E.E. McCormick

N.W. Corner of Geo. A. Wells D.L.C. # 46 T. 11 - 6
 Set a 1/2 of a buggy axle 1 1/2" x 50" bet. 2 rocks
 Oak 12" in dia. bears S. 61° E. 1.35 lying down cks.
 " 12" " " S. 45° W. .63 cks. nearly dead "
 Mkd. fir 14" " " S. 87 1/2° E. .144 "
 " 14" " " N. 57° W. .236 "

C.S. 316
 Mch. 11, 1944
 as above

S.W. Corner of Geo. A. Wells D.L.C. # 46 T. 11 - 6
 Set a 3/4" pipe 4' long 32" up. Driven in root, set from
 Oak 12" in dia. bears N. 7° 22' E. 1.73 std., green, found letters.
 " 12" " " N. 79° 10' W. 2.48 Stab 6' std.
 Mkd. fir 14" " " S. 77° E. 2.04 cks.
 " forked fir 18" " " S. 83 1/2° W. 3.40 " cen. of bottom.

3649

RESTORED CORNER FOR STATE OF OREGON--DEPARTMENT OF FORESTRY

One Quarter corner common to Sections 22 and 27, T10S,
R7W, W.M., Benton County, Oregon.

ORIGINAL

No evidence of original corner found.

RE-ESTABLISHED by W. C. Galloway, Sept. 30, 1942

7" x 26" concrete post (found in place) from which a:

18" Cedar bears S40° 06' E 181.2 lks.; now 24", face grown over.

8" Fir bears S87° 20' W 333.5 lks.; now 20", portion of scribes visible
on partly grown over face.

RESTORED

Var. 20°E


Set 4" x 4" x 72" white painted Cedar post 1.0' NE of concrete post from which a:

5" Fir bears S20°E 27.7 ft.; scribed 1/4 S27 BT RS559.

Oregon State Forestry Department metal location poster on 5" Fir BT.

Dated April 24, 1962

Restored by

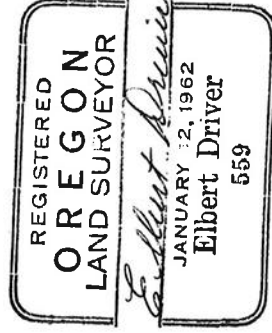

Present and witnessed by John Hollingsworth

544 622

1/4-Section corner between sections 22 and 27, Twp. 10-7

Reestablishment by W. C. Galloway

Sept. 29, 1942

Set a concrete post 7" x 7" x 26" 1/2 way between section corners

Cedar 18" in diam bears S 40° 06' E 1.812 chains

Fir 8" in diam bears S 87° 20' W 3.335 chains

Restored by Elbert Driver post

Found 7" x 26" concrete post

Cedar 18" S 40° 06' E 1.81. chains; now 24"

Fir 8" S 87° 20' W 3.335 chains; now 20"

Set 4" x 4" white post 1.0' NE of concrete post

Fir 5" S 20° E 27.7 ft.

Witnessed by John Hollingsworth

April 24, 1962

C.S. 3649

631


BENTON COUNTY SURVEYORS OFFICE · CORNER RESTORATION

167

T 10 S, R 7 W, W. B. & M., BENTON COUNTY, OREGON

REPORTED BY Malcolm Hiatt
 TITLE Employee, Starker Forests, Inc.
 DATE August 30, 1983

SECTION 22

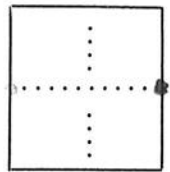

OFFICIAL CORNER FOUND

CORNER SET

$\frac{1}{4}$ CORNER COMMON TO SEC. 22 27 & 27
 IS 7" X 26" concrete post

DESCRIBE

ADDITIONAL INFORMATION
Found 4" x 4" x 72" white painted
Cedar post 1.0' NE of
concrete post
Found 5" Fir now 14" Fir S 20°E
27.7 ft. with O.S.F.D. metal location
poster
Placed a white 5 foot fiberglass
post 1.0' SW of corner
Painted "BT" with blue paint
on 5" Fir now 14" Fir

O.S.F.D. - Oregon State Forestry Dept. OVER

LEGIBLE MARKS ON BEARING OBJECTS

Red Paint and Scar (no other marks) Painted "BT"			
KIND <u>Fir</u>			
SIZE <u>5" now 14"</u>			
BEARING <u>S 20° E</u>			
DISTANCE <u>27.7 FT</u>			
BT TAG POSTED			

Sketch: Not to scale

