

107546565

POLK COUNTY CORNER RESTORATION FORM

SECTION 11 TOWNSHIP 10 S RANGE 7 W W.M. BLM ID 546565

DLC _____ CORNER County Line Monument

DATE 5/20/2011 CORNER RESTORATION FIELD BOOK 200-12 PAGE 19

PREVIOUS RENEWALS / SURVEYS, ETC.

CS 3251, 4512, 5718, 10701, 12872, 12908, 15402,
Benton County Survey BCS 10157 (134), 272, 1978,
7005, 8788

 RENEWED

UNRECORDED

SURVEYED IN

MONUMENT AND ACCESSORIES FOUND (CONDITION AND SOURCE)

I found a 1/2" X 35" iron pipe. Per BCS 6824 dated 1978, said iron pipe replaced a previous 1/2" iron pipe, of unknown origin, that was badly corroded. Said found iron pipe was N80°W, 0.64' from a typical County Line concrete post. The post is 2.5' high, 10" square at the base and 7" square at the top. The post is engraved "POLK", "BENTON" and "CO LINE". Although the origin of the original 1/2" iron pipe is unknown, it is typical of County Line Monuments located beside said Concrete Post. The iron pipe has been accepted as a County Line Monument by the Surveyor's Offices in both Polk County and Benton County.

MONUMENT SET (PROCEDURES AND DESCRIPTION)

I removed said iron pipe and in its place set a 2" X 30" iron pipe with a 2 1/2" brass cap up 3". I layed the old iron pipe next to the new monument.

NEW ACCESSORIES


- 17" fir; N72°W, 13.52' to nail, magnet and washer 1' up on right; scribed "PCO BT"; set a witness tag.
- Iron rod with cap flush; the cap is stamped "Benton County Surveyor"; N49° 08' 33"E, 39.96'; PCS 12872/BCS 8788
- 5/8" iron rod up 2"; S89° 35' 01"E, 53.01'; BCS 7005
- Set a carsonite post 2" west

State Plane Coordinate (ORGN 83/96 (2002) in Int'l Feet)
N= 398840.25 ft
E= 7420037.99 ft


NOTES

The state plane coordinates given for this point are the result of ties made during the survey for county project 1021, point #135.
See project file for more information.

MONUMENT DETAIL

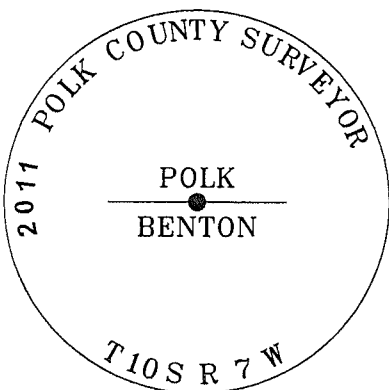

SKETCH

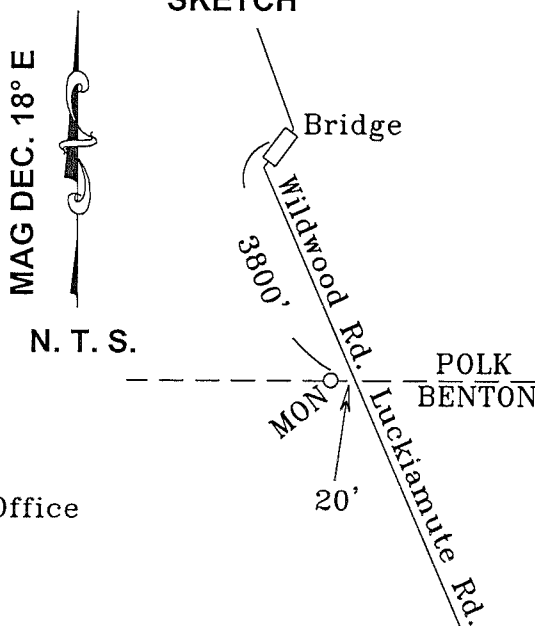

RESTORATION NO.

11899

REGISTERED
PROFESSIONAL
LAND SURVEYOR

OREGON
JANUARY 15 2002
ERIC T BERRY
61392

FIRM / AGENCY

Polk County Surveyors Office
820 S.W. Ash St.
Dallas, Oregon 97338
(503) 623-9287

WITNESS Jim Killian, Roger Ray