

107660540


BENTON COUNTY SURVEYORS OFFICE - CORNER RESTORATION

3277

T. 10 S, R. 7 W, W. B. & M., BENTON COUNTY, OREGON

SECTION 12

REPORTED BY Theodore Langton
TITLE Reg. Land Surveyor
DATE June 13, 1984

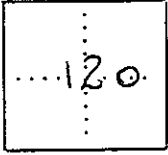

- OFFICIAL CORNER FOUND
- CORNER SET

1/16 CORNER COMMON TO SEC. 12
IS 5/8" x 30" rebar
DESCRIBE


ADDITIONAL INFORMATION

yellow cap on rebar stamped
"Northstar PLS 1823" white
Fiberglass fence post along-
side

OVER

LEGIBLE MARKS ON BEARING OBJECTS

	Set	Set		
	CE 1/6 S 1/2 BT	CE 1/6 S 1/2 BT		
KIND	D-Fir	maple		
SIZE	20"	4"		
BEARING	N59°E	N66°W		
DISTANCE	48.38'	17.47'		
BT TAG POSTED				

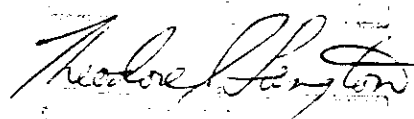THEODORE LANGTON

 THEODORE LANGTON
 1984