

CORNER FILE TRACKING

H:\Survey\Corners\Misc\Filetrac.doc

11/23/98

CORNER NUMBER
115400600

STEP	HISTORY(H)	RESTORATION(R2)
Form Prepared, DB	3/29/00	3/29/00
Field Inspection, DB	N/A	N/A
Form Checked, DB	4/12/00	4/12/00
Form Edited, DB	u	u
Form Signed, DB	u	u
Authorize Payment, DB	—	—
Archive Digital Files	5/2/00	5/2/00
Collect Documents	u	u
Scanned	5/5/00	5/5/00
Copy For Filming	5/2/00	5/2/00
Filed, DB	u	u
Finish index (count unit)	u	u
Filmed (Archived), DB		

(DB) = Entry needed in database (Access).

COMMENTS:

4/12/00 NEED TO INITIAL ✓

5/2/00 READY TO SCAN INTO A NEW FILE

4 | 3
9 | 10

CORNER HISTORY		T 11 S, R 5 W		SECTION 3 D.L.C.		CORNER SW CORNER		#
								400600
NO.	DATE	SOURCE	SURVEYOR	MONUMENTS AND ACCESSORIES			COMMENTS	
1	8/12/1852	DR16. 610	GEORGE W. HYDE	SET POST @ 4 BT'S, MEAS. TO FACE				1
2	7/1/1920	CS # 710	W.C. GALLOWAY	FND. 4 BT'S, SET STONE @ 4 NEW BT'S, FB 28/13				2
3	6/1/1921	OLD COR. REST. BK #1, Pg. 154	" "	" " " " " " " " " " (NO TIE ON ONE)				3
4	-	REST. 185	-	TRANS. COPY OF REC. [03] + MAY CONTAIN E+D				4
5	-	CS # 1203	WALTER W. LARSEN	1" PIPE @ 3 BT'S, FB 52/14				5
6	-	CS # 1305	" " "	NO DESCL., FB 51/1, 3+5				6
7	-	MAP No. 11-5-00005	BENTON COUNTY	STONE @ 4 BT'S (NO TIE ON ONE) + TIE TO RD.				7
8	-	MAP No. 11-5-DD006	" "	BL + TIE TO RD.				8
9	6/15/1949	CO. RD. No. 15037 NOTES RTE 27-B, OLD #4, 100	W.C. GALLOWAY	" " " " "				9
10	-	CS # 9041	OR. STATE BOARD OF FORESTRY	STONE @ 3 BT'S				10
							3/10/98	11
								12
								13
								14
1-15A
685

W. W. Larson
1921

in center of lane running E. and center of County Road
Oak 15" in dia. bears N. 25° E. .956 chs.
Fir 9" " " " N. 74° W. .466 "
Set 1" x 24" bolt West 30 feet.

C.S. 144 cont.

By W.C. Galloway C.S.

Witnesses

Geo. E. Linton

M.A. Schreiber

June 1920.

Duplicated

~~S.W. corner of ^{Dr.} Alford Henson D.L.C. #67 T. 12-6 ✓~~
~~3/4" rod~~

~~Set gun bbl. in rotten stump which was the corner tree.~~
~~Oak 28" N 12° 02' E. 1.179~~

~~Fir 15" in dia. bears S. 25 1/2° W. .584 chs. bearing from transit line~~
~~Oak 10" S. 51° 04' E. 0.185~~

~~Oak 15" " " S. 63° W. .108 "~~

1920 setting all out } 1951 reset from NE E by M.L. Boydein

✓ Corner to sections 3, 4, 9 & 10 T. 11 S. R. 5 W.

Set a Stone 6" X 10" X 10" All oaks found dead

Marked a Fir 20" in dia. bears N. 85° E. .247 chs.

" " Maple 9" " " " S. 32° E. .205 "

" " Fir 16" " " " S. 80° W. .240 "

" " Maple 10" " " " "

C.S. 287

W.C. Galloway C.S.
Geo. E. Linton and
D. W. Bath witnesses.
June 1, 1921.

Recorded

✓ Corner to Secs. 33, 34, 3 & 4. Tps. 12 & 13 S. R. 5 W.

Corner is a 3/4" pipe. Set by proportion and fences by F. M. Wilkes

A 1" pipe bears N. 0° 07' E. 5.687 chs.

A 1/2" " " N. 0° 07' E. 9.855 " See plat for other ties

C.S. 131A

Witnesses
J.O. Johns & J.H. Wilson Jr
Feb. 1912.

Recorded

✓ 1/4 sec. corner bet. Secs. 33 & 34 T. 12 S. R. 5 W.

Set 1" pipe for corner.

A 1" pipe bears N. 0° 07' E. 20.00 chs.

A 1/4" " " S. 0° 07' W. 30.183 "

C.S. 289
Set by F.M. Wilkes
Witnesses as above
Feb. 1912.

Corner to sections 3, 4, 9, and 10, Twp. 11 S. R. 5 W.

685

Reestablishment by W. C. Galloway

June 1, 1921

Set a stone 6" x 10" x 10", All oaks found dead.

Fir 20" in diam bears N 85° E

.247 chains

Maple 9" in diam bears S 32° E

.205 chains

Fir 16" in diam bears S 80° W

.240 chains

Maple 10" in diam bears S-----

Witnesses George E. Linton and D. W. Bath

DATE 03/29/2000TOWNSHIP 11 SOUTH, RANGE 05 WEST, WILLAMETTE MERIDIAN; SECTION 03 CORNER SOUTHWEST
DONATION LAND CLAIM N/A _____ CORNER _____**COMMON CORNER(S):**

THE SOUTHEAST CORNER OF SECTION 4.
THE NORTHEAST CORNER OF SECTION 9.
THE NORTHWEST CORNER OF SECTION 10.

RECORDS (INFORMATION IN *BOLD ITALICS* IS COUNTY STAFFS' INTERPRETATION OF THE RECORD)

- [01] ORIGINAL GLO SURVEY BY GEORGE W. HYDE, D.S., APPROVED AUGUST 12, 1852. *SET POST WITH 4 BEARING TREES, MEASURED TO THE FACE.*
- [02] COUNTY SURVEY NO. 710 NOTES (FIELD BOOK NO. 28, PAGE 13) BY W. C. GALLOWAY, C.S., DATED JULY 1, 1920. *FOUND 4 BEARING TREES, SET A STONE WITH 4 NEW BEARING TREES.*
- [03] OLD CORNER RESTORATION BOOK NO. 1, PAGE 154, BY W. C. GALLOWAY, DATED JUNE 1, 1921. *SAME INFORMATION AS RECORD [02] EXCEPT 1 NEW BEARING TREE IS NOT TIED.*
- [04] CORNER RESTORATION NO. 685. *THIS IS A TRANSCRIBED COPY OF RECORD [03] AND MAY CONTAIN ERRORS AND OMISSIONS.*
- [05] COUNTY SURVEY NO. 1203 NOTES (FIELD BOOK NO. 52, PAGE 14) BY WALTER W. LARSEN, D.C.S., NO DATE GIVEN. *1" PIPE WITH 3 BEARING TREES.*
- [06] COUNTY SURVEY NO. 1305 NOTES (FIELD BOOK NO. 51, PAGES 1, 3 AND 5) BY WALTER W. LARSEN, NO DATE GIVEN. *NO DESCRIPTION.*
- [07] MAP NO. 11-5-00005 BY BENTON COUNTY, NO DATE GIVEN. *STONE WITH 4 BEARING TREES (NO TIE TO ONE) AND TIE TO THE ROAD.*
- [08] MAP NO. 11-5-00006 BY BENTON COUNTY, NO DATE GIVEN. *BRASS CAP AND TIE TO THE ROAD.*
- [09] COUNTY ROAD NO. 15037 NOTES, ROUTE 37-B, OLD NO. 606, BY W. C. GALLOWAY, DATED JUNE 15, 1949. *SAME INFORMATION AS RECORD [08].*
- [10] COUNTY SURVEY NO. 9041, BY THE OREGON STATE BOARD OF FORESTRY, NO DATE GIVEN. *STONE WITH 3 BEARING TREES.*

COMMENTS/LOCATION/ETC:**NOTES:**

THIS IS A MICROSOFT WORD 97 DOCUMENT NAMED "15400600" CREATED FROM A BOILER PLATE DOCUMENT NAMED "HISTORY", WHICH HAS A STYLESHEET NAMED "CORNER" ATTACHED TO IT.

FIRM/AGENCY: BENTON COUNTY SURVEYOR'S OFFICE
ADDRESS: 360 S.W. AVERY AVE. CORVALLIS OR 97333; PH. 766-6821
RESEARCH BY: CURTIS J. LIESENFELT, P.L.S.
DATA ENTRY BY: SAME

BENTON COUNTY CORNER RESTORATION FORM, PAGE 1 OF 2, 115400600R2

SEE CORNER HISTORY FORM FOR RECORDS ETC.

CORNER RESTORATION FIELD BOOK NUMBER 19 PAGE(S) 04 DATE 03/21/2000
TOWNSHIP 11 SOUTH, RANGE 5 WEST, WILLAMETTE MERIDIAN; SECTION 03 CORNER SOUTHWEST
DONATION LAND CLAIM N/A CORNER _____
CONDITION REPORT _____; REFERENCED OUT XX; RENEWED _____; SURVEYED IN _____

LOCATION AND COMMENTS:

THE CORNER IS LOCATED ON A MODERATELY SLOPING, SOUTHERLY FACING, WOODED HILLSIDE. IT IS POOR FOR PREMARKING AND GPS CONTROL. IT IS ABOUT 250' NORTH-NORTHWESTERLY OF MILEPOST 1.32 ON SULFUR SPRINGS ROAD. MILEPOST 1.32 IS 1/4 MILE SOUTHEASTERLY FROM THE GATED FOREST ROADS AT THE LEWISBURG SADDLE AND 1.32 MILES WEST-NORTHWESTERLY OF LEWISBURG AVENUE.

MONUMENTS AND ACCESSORIES FOUND (CONDITION AND SOURCE):

FOUND: 3/4" INSIDE DIAMETER IRON PIPE WITH A 2 1/4" MCDONALD FOREST BRASS CAP, 14" ABOVE GROUND SURFACE, STAMPED AS SHOWN, FOR THE CORNER.
(BRASS CAP AS PER RECORDS [08] AND [09]).

FOUND: DOWNED 12" OAK IN THE VICINITY OF THE ORIGINAL NORTHWEST BEARING TREE.

FOUND: MOSTLY ROTTED REMAINS OF A 24" D. FIR STUMP, BEARS S 80°30'E~16.1'.
(20" FIR, N 85°E~16.30' AS PER RECORDS [02], [03] AND [07]).

FOUND: MOSTLY ROTTED REMAINS OF A DOWNED 16" D. FIR. SET A REBAR (SEE NOTES) STAMPED "WSW RP" IN THE CENTER OF THE BARK SHELL, BEARS S 75°50'W~16.06'.
(16" FIR, S 80°W~15.84' AS PER RECORDS [02], [03] AND [07]).

FOUND: MAPLE REMAINS IN THE VICINITY OF THE RECORD [02] NORTHWEST BEARING TREE.


FOUND: MOSTLY ROTTED REMAINS OF A 16" MAPLE WITH EVIDENCE OF A HEALED FACE, BEARS S 43°E~13.7'.
(9" MAPLE, S 32°E~13.53' AS PER RECORDS [02], [03] AND [07]).

THE REMAINING BEARING TREES WERE SEARCHED FOR WITHOUT SUCCESS.

MONUMENT SET (PROCEDURES AND DESCRIPTION):


USED THE MONUMENT AS RECOVERED FOR THE CORNER.

MONUMENT DETAIL

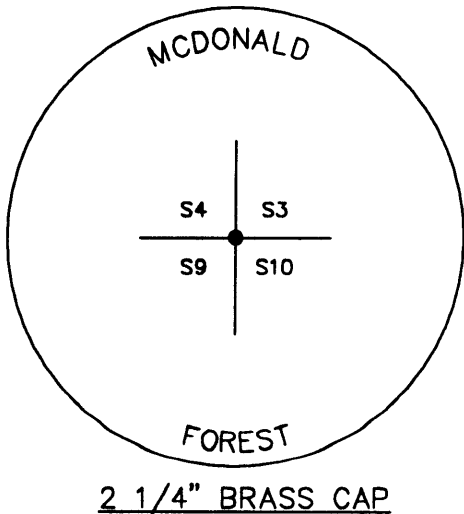

NOT TO SCALE
(F) = to face
(C) = to center

SKETCH

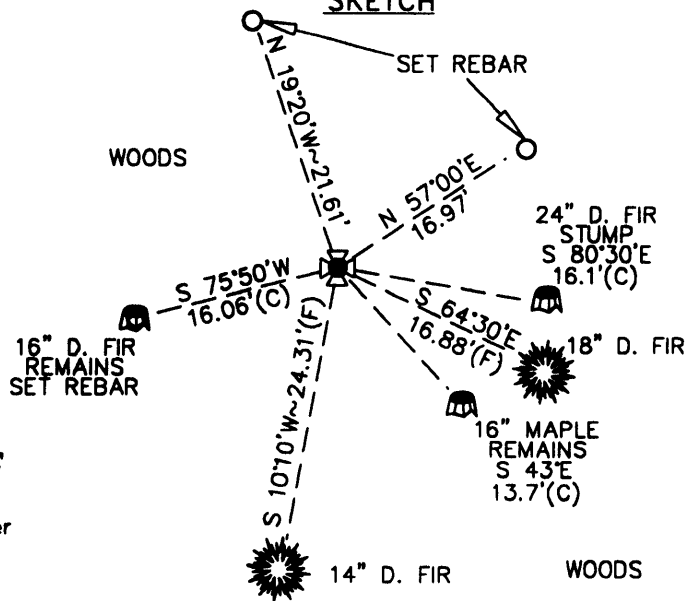

THE BEARINGS ARE MAGNETIC AND WERE OBSERVED WITH A 5 MINUTE STAFF COMPASS/TRANSIT.

NEW ACCESSORIES:

- SET: REBAR (SEE NOTES) 6" BELOW GROUND SURFACE, BEARS N 57°00'E~16.97'.
- A 18" D. FIR BEARS S 64°30'E~16.88' (17.8' TO SIDE CENTER) FACE SCRIBED "T11SR5ws10BT".
- A 14" D. FIR BEARS S 10°10'W~24.31' (25.0' TO SIDE CENTER) FACE SCRIBED "T11SR5ws9BT".
- SET: REBAR (SEE NOTES) 3" BELOW GROUND SURFACE, BEARS N 19°20'W~21.61'.
- SET: ORANGE FIBERGLASS "SURVEY MARKER" POST 1' SOUTHERLY.

NOTES:

COMPASS DECLINATION IS 20° EAST. ALL MEASURED DISTANCES AND BEARINGS ARE TO THE CENTER OF THE OBJECT, UNLESS OTHERWISE NOTED. ALL BEARING TREES ARE PAINTED AND HAVE A B.T. TAG ATTACHED, FACING THE CORNER UNLESS OTHERWISE NOTED. ALL NEW BEARING TREES HAVE A PLASTIC WASHER (STAMPED "BENTON COUNTY SURVEYOR CORNER RESTORATION") ATTACHED (BY ALUMINUM NAIL) TO THE FACE, BELOW THE "BT" FOR DISTANCE AND ANGLE MEASUREMENT UNLESS OTHERWISE NOTED. ALL SET REBAR ARE 5/8" X 30" AND HAVE A 1 3/4" RED PLASTIC CAP (MARKED "BENTON COUNTY SURVEYOR'S OFFICE") ATTACHED TO THE TOP.

THIS DOCUMENT WAS NAMED AND CREATED IN A MANNER SIMILAR TO THE HISTORY FORM. THE NAME OF THE BOILER PLATE IS "MONUMENT". THE SKETCH IS FROM AUTOCAD RELEASE 14.

THIS RESTORATION WAS PERFORMED AT THE DIRECTION AND APPROVAL OF THE BENTON COUNTY/DEPUTY COUNTY SURVEYOR. CS

FIRM/AGENCY: BENTON COUNTY SURVEYOR'S OFFICE
ADDRESS: 380 S.W. AVERY AVE. CORVALLIS OR 97333; PH. 766-6821
SURVEYOR: CURTIS J. LIESENFELT, P.L.S.
SURVEY CREW: DAVID M. DEAN, P.L.S.

**REGISTERED
PROFESSIONAL
LAND SURVEYOR**

Curtis J. Liesenfelt

**OREGON
JULY 17, 1986
CURTIS J. LIESENFELT
2213**

LICENSE RENEWAL 12/31/2000