

CORNER FILE TRACKING

H:\Survey\Corners\Misc\Filetrac.doc

11/23/98

CORNER NUMBER
116100200

STEP	HISTORY(H)	RESTORATION(1)
Form Prepared, DB	9/1/99	9/1/99
Field Inspection, DB	N/A	N/A
Form Checked, DB	9/10/99	9/10/99
Form Edited, DB	10/4/99	10/4/99
Form Signed, DB	—	"
Authorize Payment, DB	—	—
Archive Digital Files	10/13/99	10/13/99
Collect Documents	10/18/99	10/18/99
Scanned	10/19/99 / 1/24/00	10/19/99 / 1/24/00
Copy For Filming	10/18/99	10/18/99
Filed, DB	10/19/99	10/19/99
Finish index (count unit)	"	"
Filmed (Archived), DB		

(DB) = Entry needed in database (Access).

COMMENTS:

1/19/00 4 PAGES NEEDING TO BE RESCANED INTO A FILE (OVERWRITE THE OLD ONES)

CORNER FILE TRACKING

H:\Survey\Corners\Misc\Filetrac.doc

11/23/98

CORNER NUMBER
116100200

STEP	HISTORY(H)	RESTORATION(1)
Form Prepared, DB	9/1/99	9/1/99
Field Inspection, DB	N/A	N/A
Form Checked, DB	9/10/99	9/10/99
Form Edited, DB	10/4/99	10/4/99
Form Signed, DB	—	"
Authorize Payment, DB	—	—
Archive Digital Files	10/13/99	10/13/99
Collect Documents	10/18/99	10/18/99
Scanned	10/19/99	10/19/99
Copy For Filming	10/18/99	10/18/99
Filed, DB		
Finish index (count unit)		
Filmed (Archived), DB		

(DB) = Entry needed in database (Access).

COMMENTS:

7 6
25 30
36 31

CORNER HISTORY		T 11 S, R 6 W		SECTION 30 D.L.C.		CORNER SW CORNER		#
NO.	DATE	SOURCE	SURVEYOR	MONUMENTS AND ACCESSORIES		COMMENTS		
1	2/28/1855	ORIG. GLO	HARVEY GOROOM + JOSIAH PRESTON	SET POST @ 4 BT'S MEASURED TO THE FACE				1
								2
2	12/31/1927	S.P.R.R. - MAP V-4 B	SOUTHERN PACIFIC R.R.	NO DESL.				3
								4
3	9/25/1952	CS # 2425	MARTIN BEYERLEIN	FIND. DRIL. BT'S SET 1" ROD + TIED IN NEW TREE				5
								6
4	-	MAP NO. 11-6-00015	BENTON COUNTY	MONUMENT SET IN 1952				7
								8
5	2/1957	CS # 2530	J.W. HANNA	FIND 5/8" ROD + 2 BT'S (IN NOTES)		WHO SET THE ROD?		9
								10
6	-	MAP NO. 11-7-00012	BENTON COUNTY	5/8" ROD				11
								12
7	2/1979	CS # 7013	ARNOLD BRIGGS	FIND 3/4" ROD				13
								14
8	6/27/1997	BEN. CO. GIS/DEPT MAPPING PROJ	TYLER PARSONS	4 1" IRON ROD		TYLER FIND + TIED 1" ROD		15
								16
								17
								18
26

TP
LP

116 100 200

6/27/97

27

STA

HA

HA :

T115 R6W S30

9999.27

T115

R1W R6W

-2°06'37"

346190.16

525 530

K1

116 100 200 A

742882.74

536 531

2 D 0-00-00

197.76

Fd 1" IRON ROD

3

N 50° W

333.62

333.62

R 180-00-04

197.76

A 0-00-00

197.76

DOHC

3 D 703-03-09

333.620

R 23-03-10

333.620

A 203-03-08

333.620

346473.01

7427136.02

572°26'14"E ~ 197.76

197.76

203°03'08"

346413.36

7427324.58

DATE 08/30/1999TOWNSHIP 11 SOUTH, RANGE 6 WEST, WILLAMETTE MERIDIAN; SECTION 30 CORNER SOUTHWEST
DONATION LAND CLAIM N/A CORNER**COMMON CORNER(S):**

THE NORTHWEST CORNER OF SECTION 31 IN TOWNSHIP 11 SOUTH, RANGE 6 WEST.
THE SOUTHEAST CORNER OF SECTION 25 IN TOWNSHIP 11 SOUTH, RANGE 7 WEST.
THE NORTHEAST CORNER OF SECTION 36 IN TOWNSHIP 11 SOUTH, RANGE 7 WEST.

RECORDS (INFORMATION IN *BOLD ITALICS* IS COUNTY STAFF'S INTERPRETATION OF THE RECORD)

- [01] ORIGINAL GLO SURVEY BY HARVEY GORDON AND JOSIAH PRESTON, D.S., DATED FEBRUARY 28, 1855. *SET POST WITH 4 BEARING TREES, MEASURED TO THE FACE.*
- [02] SOUTHERN PACIFIC RAILROAD MAP BY SOUTHERN PACIFIC, DATED DECEMBER 13, 1927. *NO DESCRIPTION.*
- [03] COUNTY SURVEY NO. 2425 BY MARTIN BEYERLEIN, D.C.S., DATED SEPTEMBER 28, 1952. *FOUND ORIGINAL BEARING TREES, SET 1" ROD AND TIED 1 NEW TREE.*
- [04] MAP NO. 11-6-00015 BY BENTON COUNTY. *MONUMENT SET IN 1952.*
- [05] COUNTY SURVEY NO. 2880 BY J. W. HANNA, P.L.S., DATED FEBRUARY, 1957. *FOUND 5/8" ROD AND 2 BEARING TREES (NOTES).*
- [06] MAP NO. 11-7-00012 BY BENTON COUNTY, NO DATE GIVEN. *5/8" ROD.*
- [07] COUNTY SURVEY NO. 7013 BY ARNOLD BRUBAKER, P.L.S., DATED FEBRUARY, 1979. *FOUND 3/4" ROD.*
- [08] BENTON COUNTY GIS/DEA MAPPING PROJECT BY TYLER PARSONS, P.L.S., DATED JUNE 27, 1997. *FOUND 1" IRON ROD.*

COMMENTS/LOCATION/ETC:**NOTES:**

THIS IS A MICROSOFT WORD 97 DOCUMENT NAMED "16100200" CREATED FROM A BOILER PLATE DOCUMENT NAMED "HISTORY", WHICH HAS A STYLESHEET NAMED "CORNER" ATTACHED TO IT.

FIRM/AGENCY: BENTON COUNTY SURVEYOR'S OFFICE
ADDRESS: 360 S.W. AVERY AVE. CORVALLIS OR 97333; PH. 766-6821
RESEARCH BY: CURTIS J. LIESENFELT, P.L.S.
DATA ENTRY BY: SAME

BENTON COUNTY CORNER RESTORATION FORM, PAGE 1 OF 2, 116100200R1

SEE CORNER HISTORY FORM FOR RECORDS ETC.

CORNER RESTORATION FIELD BOOK NUMBER 17 PAGE(S) 57 DATE 08/11/1999
TOWNSHIP 11 SOUTH, RANGE 6 WEST, WILLAMETTE MERIDIAN; SECTION 30 CORNER SOUTHWEST
DONATION LAND CLAIM N/A CORNER _____
CONDITION REPORT _____; REFERENCED OUT _____; RENEWED XX; SURVEYED IN _____

LOCATION AND COMMENTS:

THE CORNER IS LOCATED ON A STEEP, NORTHERLY FACING, HEAVILY WOODED AND BRUSHY HILLSIDE, NEAR THE NORTHWEST CORNER OF A CLEARCUT. TO REACH FROM THE INTERSECTION OF HARRIS ROAD AND WREN ROAD, FOLLOW HARRIS ROAD 3.83 MILES TO A PRIVATE, GATED GRAVEL ROAD TO THE LEFT, JUST BEFORE CROSSING THE RAILROAD TRACKS. GO THROUGH THE GATE AND FOLLOW THE MAIN GRAVEL ROAD 0.63 MILES TO A 3-WAY INTERSECTION, GO STRAIGHT (MIDDLE FORK) OVER A RIDGE FOR 1100' TO AN OVERGROWN SKID ROAD TO THE RIGHT, FOLLOW THE SKID ROAD 500' TO THE END. THE CORNER IS DOWNHILL, ABOUT 350' NORTHWESTERLY. IT IS POOR FOR PREMARKING, BUT HAS BEEN TIED INTO RTK GPS CONTROL.

MONUMENTS AND ACCESSORIES FOUND (CONDITION AND SOURCE):

FOUND: 1" X 30.5" REBAR FOR THE CORNER. NO OTHER EVIDENCE OF ANY OTHER MONUMENTS WAS RECOVERED.
(1" ROD AS PER RECORDS [03] AND [08]).
(5/8" ROD AS PER RECORDS [05] AND [06]).
(3/4" ROD AS PER RECORD [07]).

FOUND: PARTLY ROTTED 18" OAK STUMP WITH THE BACKCAST "T" AND NOTCH VISIBLE, BEARS S 70°W~36.86'. SET PK NAIL AND BRASS WASHER IN THE NORTHWESTERLY BASE. THIS LINE IS THE BASIS OF BEARINGS FOR THIS RESTORATION.
(10" OAK, S 70°W~36.30' AS PER RECORD [01]).
(10" OAK, S 70°W~36.30' WITH SCRIBING AS PER RECORD [03]).

FOUND: 76" D. FIR WITH A BARK SCRIBED "B" AND CRUISER MARKS, BEARS S 2°E~15.48'. SET AN ALUMINUM NAIL AND PLASTIC WASHER IN THE WESTERLY BASE.
(72" FIR WITH CRUISER MARKS, S 7°E~15.96' AS PER RECORD [03]).
(5' FIR S 7°E AS PER RECORD [05]).


FOUND: PARTLY ROTTED 26" D. FIR STUMP IN THE VICINITY (N 62°30'W~45.8') OF THE ORIGINAL NORTHWEST BEARING TREE. CUT OPEN, BUT DID NOT FIND ANY MARKS. THIS TREE WAS ABOUT 65-70 YEARS OLD WHEN CUT DOWN.
(8" R. FIR, N 63°W~48.18' AS PER RECORD [01])
(ORIGINAL 8" FIR, N 63°W~48.18', STUMP ABOUT 30 YEARS AS PER RECORD [03]).

THE REMAINING RECORD PHYSICAL EVIDENCE WAS SEARCHED FOR WITHOUT SUCCESS. THERE HAS BEEN A LANDSLIDE IN PARTS OF THE NORTHWEST, SOUTHEAST AND THE ENTIRE NORTHEAST QUADRANT.

MONUMENT SET (PROCEDURES AND DESCRIPTION):


SET: 2" INSIDE DIAMETER BY 36" LONG GALVANIZED IRON PIPE WITH A 3 1/4" BENTON COUNTY BRASS DISC, STAMPED AS SHOWN, CENTERED OVER THE RECOVERED REBAR.

MONUMENT DETAIL

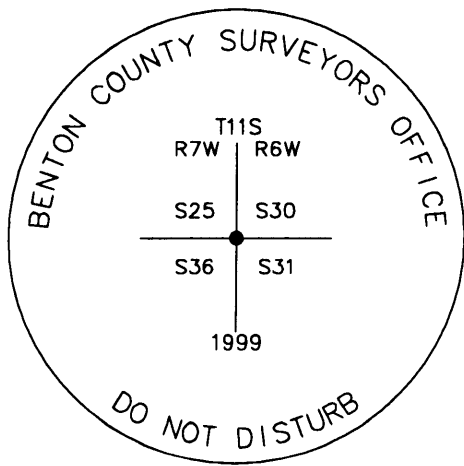

3 1/4" BRASS DISC

SKETCH

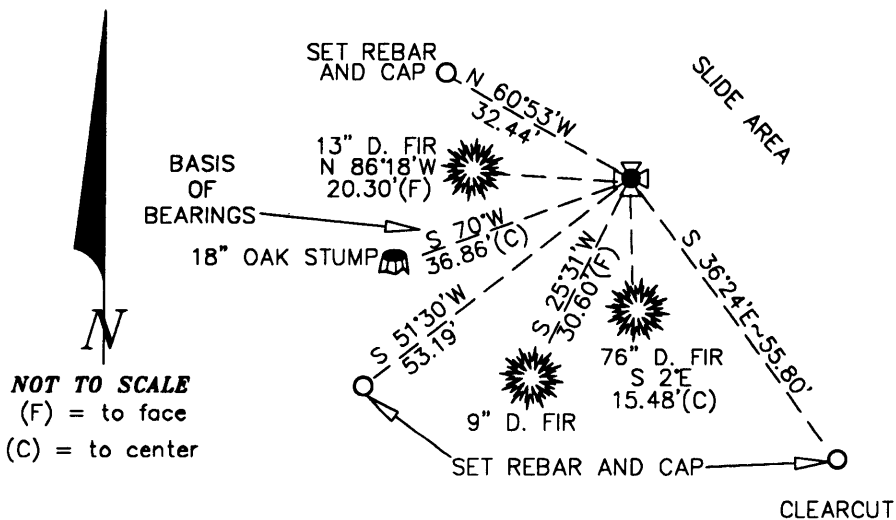

NEW ACCESSORIES:

- SET: REBAR (SEE NOTES) 4" BELOW GROUND SURFACE (BGS), BEARS N 60°53'W~32.44'.
- SET: REBAR (SEE NOTES) 6" BGS, BEARS S 36°24'E~55.80'.
- SET: REBAR (SEE NOTES) 6" BGS, BEARS S 51°30'W~53.19'.
- A 13" D. FIR BEARS N 86°18'W~20.30' (20.9" TO SIDE CENTER), FACE SCRIBED "T11SR7WS25BT".
- A 9" D. FIR BEARS S 25°31'W~30.60' (30.8" TO SIDE CENTER), FACE SCRIBED "T11SR7WS36BT".
- SET: ORANGE FIBERGLASS "SURVEY MARKER" POST 1' NORTHERLY.

NOTES:

COMPASS DECLINATION IS 20° EAST. ALL MEASURED DISTANCES AND BEARINGS ARE TO THE CENTER OF THE OBJECT, UNLESS OTHERWISE NOTED. ALL BEARING TREES ARE PAINTED AND HAVE A B.T. TAG ATTACHED, FACING THE CORNER UNLESS OTHERWISE NOTED. ALL NEW BEARING TREES HAVE A PLASTIC WASHER (STAMPED "BENTON COUNTY SURVEYOR CORNER RESTORATION") ATTACHED (BY ALUMINUM NAIL) TO THE FACE, BELOW THE "BT" FOR DISTANCE AND ANGLE MEASUREMENT UNLESS OTHERWISE NOTED. ALL SET REBAR ARE 5/8" X 30" AND HAVE A YELLOW PLASTIC CAP (STAMPED "BENTON COUNTY SURVEYOR") ATTACHED TO THE TOP.

THIS DOCUMENT WAS NAMED AND CREATED IN A MANNER SIMILAR TO THE HISTORY FORM. THE NAME OF THE BOILER PLATE IS "MONUMENT". THE SKETCH IS FROM AUTOCAD RELEASE 14.

THIS RESTORATION WAS PERFORMED AT THE DIRECTION AND APPROVAL OF THE BENTON COUNTY/DEPUTY COUNTY SURVEYOR. RW

FIRM/AGENCY: BENTON COUNTY SURVEYOR'S OFFICE
ADDRESS: 360 S.W. AVERY AVE. CORVALLIS OR 97333; PH. 766-6821
SURVEYOR: CURTIS J. LIESENFELT, P.L.S.
SURVEY CREW: RAY WILSON, C.S., JOSH RUDIGER, TECHNICIAN

**REGISTERED
PROFESSIONAL
LAND SURVEYOR**

Curtis J. Liesenfelt

OREGON
JULY 17, 1986
CURTIS J. LIESENFELT
2213

LICENSE RENEWAL 12/31/2000