

**117140700**

DATE 02/08/2021TOWNSHIP 11 SOUTH, RANGE 7 WEST, WILLAMETTE MERIDIAN; SECTION 6 CORNER NORTH 1/4  
DONATION LAND CLAIM N/A CORNER N/ACOMMON CORNER(S):**RECORDS (INFORMATION IN BOLD ITALICS IS COUNTY STAFFS' INTERPRETATION OF THE RECORD)**

BASED ON EXTENSIVE RESEARCH AND RECOVERY OF EVIDENCE, THIS OFFICE HAS DETERMINED THAT MOST GENERAL LAND OFFICE SURVEYORS IN BENTON COUNTY BEFORE 1890 MEASURED TO THE FACE OF BEARING TREES.

- [01] GENERAL LAND OFFICE (GLO) NOTES BY DENNIS HATHORN, D.S., DATED APRIL 26, 1855. *SET POST FROM WHICH A BURNT FIR 36" DIA BEARS N75°W, 77 LINKS (50.82 FEET); BURNT FIR 30" DIA BEARS S75°E, 91 LINKS (60.06 FEET).*
- [02] GENERAL LAND OFFICE (GLO) NOTES BY DENNIS HATHORN, D.S., DATED DECEMBER 5, 1856. *STANDARD 1/4 SECTION POST.*
- [03] BENTON COUNTY SURVEY NO. 706 (OLD NO. 286) FIELD NOTES (FIELD BOOK 27, PAGE 75) BY W. C. GALLOWAY, C.S., DATED MAY 26, 1920. *SET A FIR KNOT 4" X 4" X 18". BURNT FIR 30" DIA (GLO BT) BEARS S78°E, 0.91 CHAINS (60.06 FEET); BURNT FIR 36" DIA (GLO BT) BEARS N75°W, 0.77 CHAINS (50.82 FEET); FIR 15" DIA BEARS N15°20'E, 1.809 CHAINS (119.39 FEET); FIR 22" DIA BEARS N57°30'W, 1.272 CHAINS (83.95 FEET).*
- [04] BENTON COUNTY CORNER RESTORATION BOOK NO. 1, PAGE 144, BY UNKNOWN DRAFTSMAN, DATED MAY 26, 1920. *SET FIR KNOT 4" X 4" X 18". BURNT FIR 30" DIA (GLO BT) BEARS S78°E, 0.91 CHAINS (60.06 FEET), STANDING; BURNT FIR 36" DIA (GLO BT) BEARS N75°W, 0.77 CHAINS (50.82 FEET), STANDING; FIR 15" DIA (CSBT) BEARS N15°20'E, 1.809 CHAINS (119.39 FEET); FIR 22" DIA (CSBT) BEARS N57°30'E, 1.272 CHAINS (83.95 FEET).*
- [05] BENTON COUNTY CORNER RESTORATION NO. 1001. *TRANSCRIBED FROM RECORD [04] AND MAY CONTAIN ERRORS AND/OR OMISSIONS.*
- [06] BENTON COUNTY MAP NO. 11-7-00002 BY W. C. GALLOWAY, C.S., DATED MAY, 1920. *FIR KNOT. BURNT FIR 30" DIA (GLO BT) BEARS S78°E, 0.91 CHAINS (60.06 FEET), STANDING; BURNT FIR 36" DIA (GLO BT) BEARS N75°W, 0.77 CHAINS (50.82 FEET), STANDING; FIR 15" DIA (CSBT) BEARS N15°20'E, 1.809 CHAINS (119.39 FEET); FIR 22" DIA (CSBT) BEARS N57°30'W, 1.272 CHAINS (83.95 FEET).*
- [07] OREGON STATE HIGHWAY DEPARTMENT CONSTRUCTED LINE DRG. NO. 5B-7-13, LINCOLN CO. LINE TO BLODGETT, EDDYVILLE-BLODGETT HIGHWAY, BENTON COUNTY, BY UNKNOWN DRAFTSMAN, DATED OCTOBER, 1936, REVISED FEBRUARY, 1975. *FOUND BUT NOT DESCRIBED.*
- [08] BENTON COUNTY SURVEY NO. 2297 LOOSE LEAF NOTES BY MARTIN L. BEYERLEIN, D.C.S., DATED AUGUST 20, 1951. *FOUND SQUARE STAKE "CS" ON EAST SIDE. TREE 34" DIA (CSBT) BEARS N15°20'E, 1.806 CHAINS (119.20 FEET), STANDING GREEN; FIR 46" DIA (CSBT) BEARS N57°30'W, 1.274 CHAINS (84.08 FEET).*
- [09] BENTON COUNTY SURVEY NO. 2297 MAP BY CURTIS C. HANSON, C.S., DATED AUGUST 20, 1951. *FOUND STAKE. FIR 15" DIA (CSBT) BEARS N15°20'E, 1.806 CHAINS (119.20 FEET); FIR 40" DIA (CSBT) BEARS N57-1/2°W, 1.274 CHAINS (84.08 FEET).*
- [10] BENTON COUNTY SURVEY NO. 2306 BY MARTIN L. BEYERLEIN, D.C.S., DATED FEBRUARY 26, 1954. *FOUND FIR KNOT.*
- [11] BENTON COUNTY SURVEY NO. 5732 BY WILJO E. GREEN, P.L.S., DATED MARCH, 1973. *FOUND STANDARD 1/4 CORNER SECTION 6. OREGON STATE BOARD OF FORESTRY 1-1/2" X 36" GALVANIZED IRON PIPE WITH 3" BRONZE CAP, FIVE BEARING TREES. SET EAST 1/16 CORNER SECTION 31 ESTABLISHED ON 2ND STANDARD PARALLEL, OREGON STATE BOARD OF FORESTRY 1-1/2" X 36" GALVANIZED IRON PIPE WITH 3" BRONZE CAP, 33" IN GROUND, BEARS N89°26'58"E, 6.2 FEET, FROM WHICH A FIR 10" DIA BEARS N18°30'E, 13.0 FEET; FIR 10" DIA BEARS N54°E, 30.5 FEET, "RS563"; WHITE PAINTED CEDAR POST BEARS NORTHEAST 1.0 FEET.*
- [12] BENTON COUNTY CORNER RESTORATION NO. 3212, RESTORED CORNER FOR STATE OF OREGON DEPARTMENT OF FORESTRY BY WILJO E. GREEN, P.L.S., DATED JUNE 15, 1973. *FOUND FIR KNOT, PORTION OF SCRIBE VISIBLE AND AXE WORK, FROM WHICH A BADLY DECAYED FIR STUMP 30" DIA (GLO BT) BEARS S75°E, 91 LINKS (60.06 FEET), NO SCRIBES VISIBLE; BURNT FIR 36" DIA (GLO BT) BEARS N75°W, 77 LINKS (50.82 FEET), NOW MISSING, TAKEN OUT BY LOGGING ROAD; FIR 38" DIA (CSBT) BEARS N15°20'E, 180.9 LINKS (119.39 FEET), DID NOT OPEN FACE; FIR 52" DIA (CSBT) BEARS N57°30'W, 127.2 LINKS (83.95 FEET), DID NOT OPEN FACE. SET 1-1/2" X 36" GALVANIZED IRON PIPE WITH 3" BRONZE CAP MARKED "OREGON STATE BOARD OF FORESTRY 1/4 S6 SC 1973 RS563", 34" IN GROUND, IN PLACE OF FIR KNOT, AND FROM WHICH A FIR 17" DIA BEARS N85°W, 18.2 FEET TO FACE, SCRIBED "S31 RS563 BT"; FIR 19" DIA BEARS S4°W, 15.3 FEET TO FACE, SCRIBED "1/4 S6 SC BT"; FIR 16" DIA BEARS S57°30'W, 26.6 FEET TO FACE, SCRIBED "1/4 S6 SC BT". SET 4" X 4" X 72" WHITE PAINTED CEDAR POST 1.0 FEET NORTHEAST OF CORNER PIPE.*
- [13] BENTON COUNTY CORNER RESTORATION NO. 1004. *TRANSCRIBED FROM RECORD [12] AND MAY CONTAIN ERRORS AND/OR OMISSIONS.*

**FIRM/AGENCY:** BENTON COUNTY SURVEYOR'S OFFICE  
**ADDRESS:** 360 S.W. AVERY AVE., CORVALLIS, OR 97333; PH. 541-766-6821  
**RESEARCH BY:** DAVID L. MALONE, P.L.S.  
**DATA ENTRY BY:** SAME

117140700

3212

RESTORED CORNER FOR STATE OF OREGON--DEPARTMENT OF FORESTRY

*N 1/4 COR*

Standard one quarter corner for Section 6, Township 11 South, Range 7 West, W.M., Benton County, Oregon.

ORIGINAL

Post (now missing) from which a:

- 36" Burnt fir bears N75°W 77 lks.; now missing, taken out by logging road.
- 30" Burnt fir bears S75°E 91 lks.; found, badly decayed 30" fir stump, no scribes visible.

RESTORATION by W. C. Galloway 1920

Fir knot (found in place, portion of scribe visible, and axe work) from which a:

- 15" Fir bears N15°20'E 180.9 lks.; in place, now 38" fir, did not open face.
- 22" Fir bears N57°30'W 127.2 lks.; in place, now 52" fir, did not open face.

RESTORED

Set 1 1/2" x 36" galvanized iron pipe with 3" bronze cap marked "OREGON STATE BOARD OF FORESTRY 1/4 S6 SC 1973 RS563", 34 inches in ground, in place of fir knot, and from which a:


- 17" Fir bears N85°W 18.2 ft. to face; scribed S31 RS563 BT.
  - 19" Fir bears S04°W 15.3 ft. to face; scribed 1/4 S6 SC BT.
  - 16" Fir bears S57°30'W 26.6 ft. to face; scribed 1/4 S6 SC BT.
- Logging road bears West 49.0 ft., runs S42°W.

Set 4" x 4" x 72" white painted Cedar post 1.0 ft. NE of corner pipe. Oregon State Forestry Department metal location poster on 16" fir BT.

Dated June 15, 1973

Restored by *Mark E. Steele* under my direction.  
Mark E. Steele, Engineer

Present and witnessed by William M. Bonsanti  
William E. Seeley

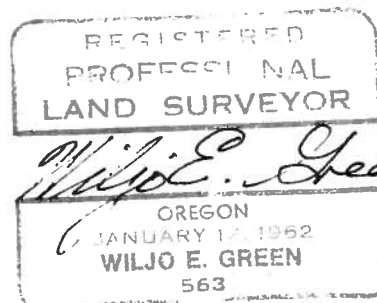

BENTON COUNTY SURVEYORS OFFICE - CORNER RESTORATION

1001

T 11 S, R 7 W, W. B. & M., BENTON COUNTY, OREGON


SECTION 6

REPORTED BY Wiljo Green

TITLE Pro. Land Surveyor

DATE 6-15-73

FOR ADDITIONAL INFORMATION SEE THE T11S RTW FILE IN THE CORNER RESTORATION CORRESPONDENCE FILE DRAWER (CJL 7/16/90).

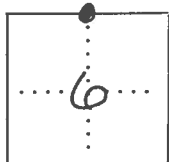

● OFFICIAL CORNER FOUND

○ CORNER SET

1/4 CORNER COMMON TO SEC. 6 & 31  
 IS 1 1/2" x 36" galvanized iron pipe  
DESCRIBE

ADDITIONAL INFORMATION

galv. iron pipe marking 1/4 corner has  
 3" bronze cap marked "OREGON  
 STATE BOARD OF FORESTRY # 1/4  
S6 1973 RS563"

Set 4" x 4" x 72" white painted cedar  
 post 1.0 ft N.E. of corner pipe.

Oregon State Forestry location poster on  
16" Fir BT.

OVER

LEGIBLE MARKS ON BEARING OBJECTS

	S 31 RS563 BT	1/4 S6 SC BT	1/4 S6 SC BT
KIND	Fir	Fir	Fir
SIZE	17"	19"	16"
BEARING	N85°W	S4°W	S57°30'W
DISTANCE	18.2'	15.3ft	26.6'
BT TAG POSTED			

C.S.

C.S. #137  
Continued  
Witness Lester Smith

S. W. Cor. Samuel Gage D. L. Co. # 57, T. 12 S. R. 5 W. 7. 7. 711.  
3/4" galv. pipe S. 89° 44' 71.  
1/4" inch pipe bears N. 0.17 E. 8.16

N. W. Corner Saul Gage D. L. Co. # 57, T. 12 S. R. 5 W. 7. 7. 711.  
3/4" galv. pipe  
1 pipe bears S. 37° 71

West E. N. E. Cor. of Thos. Harris D. L. Co. # 58, T. 12 S. R. 5 W.  
Set 2x bottle 14" under surface.  
Oak 30" x 48" bears N. 3° 30' E. 7.06 std.  
S. W. Oak 9000

Int. Cor. of Samuel Gage D. L. Co. # 57 T. 12 S. R. 5 W. 9. 9. 911.  
3/4" galv. iron pipe. Ash 15" S. 57° 10' W. .231

Apr. 12, 1920

C.S. #286  
Witness Ed. Strub  
S.M. Wood  
May 26, 1920

1/4 Sec. Cor on N. line of Sec. 6 T. 11. R. 7 W. W. M.  
Set fir knot 4x4x18" Fitts"  
Fir 15" in dia. bears N. 15° 20' E. 1.809 chs.  
Fir 22" " " " N 57° 30' E 1.272 "  
B " 30" " " " S. 78° E .91 " std.  
" " 36 " " " N 75° W .77 " "



1/4 Sec. Cor betw sees. 1+6 T. 11-7 and 8 W.  
Set pitch stk + iron rod  
B. snag 36" in dia. bears N 7° E .19 chs. std.  
Double willow 20" " " " N 63° 30' E .988 chs.  
Slump 30" N 39° E .537  
Fir 20" S. 78° E. 1.162  
Slump 25" N. 0° 10' W. .961

C.S. 207  
Witness S.M. Wood  
May 28, 1920

1/4 Sec. cor. betw sees. 5+8. T. 11-7 W.  
Set qt. bottle 12" under surface - set on line at dist. from creek  
Ash. 13" in dia. bears S. 69° 35' W 2.335 chs.  
Fir 30" " " " S. 40° 40' W. 3.099 "  
L Iron 5.0" H. 4' E. 6.50 chs.  
Dec. 1936 W.C.G.  
R.J. Stewart, Victor Phelan

C.S. 261 Cont.  
Witnesses  
M.C. Porter  
Lester Porter  
Jesse Porter  
Harry Richerick

1/4 Sec. cor. betw sees. 11+12 T. 13-5 W  
Set a 3/4"x40" gal. iron pipe. set on line half way bet. sec. cors.  
Oak 7" in dia. bears N 64° 40' E .613 chs.  
Double oak 18" " " " N 72° W .693 "

1/4 sec. cor. betw sees. 12+13 T. 13-5 W  
Set oak stake - brick bats on S. of stk. at fr. cor.  
No trees near.  
3/4" pipe on line 13.553 chs. W. of cor.

C.S. 306  
Witnesses  
W.C. Galloway  
W.W. Larson  
Oct. 23, 1920

Std. 1/4 Sec. cor. on N. of sec. 3 T. 14-5 W  
Set qt. bottle 15" under surface - proportional dist.  
3/4" pipe bears S 89° 53' E 20.06 chs.  
3/4" on S. line of County Road bears S 0° 17' E 41.293 chs.  
Township line runs straight from this cor. to 1/4" on N. of sec. 6

$\frac{1}{4}$ -Section corner on N. line of section 6, Twp. 11 S., R. 7 W. W. M. 1001

Reestablishment by ~~W. C. Galloway~~ \*

May 26, 1920

Set Fir knot 4" x 4" x 18"

Fir 15" in diam bears N 15° 20' E

1.809 chains

Fir 22" in diam bears N 57° 30' E

1.272 chains

B. Fir 30" in diam bears S 78° E

.91 chains(standing)

B. Fir 36" in diam bears N 75° W

.77 chains(standing)

Witnesses Ed. Strouts and S. M. Wood

\* BENTON COUNTY SURVEYOR'S OFFICE, SEE FIELD BOOK NO. 27, PAGES 74-75 AND OLD CORNER RESTORATION BOOK NO. 1, PAGE 144 (CJL 11/18/92).