

**117340100**

DATE 02/18/2020TOWNSHIP 11 SOUTH, RANGE 7 WEST, WILLAMETTE MERIDIAN; SECTION 33 CORNER SOUTH 1/4  
DONATION LAND CLAIM N/A CORNER N/A**COMMON CORNER(S):**

NORTH 1/4 CORNER OF SECTION 4, TOWNSHIP 12 SOUTH, RANGE 7 WEST

**RECORDS (INFORMATION IN *BOLD ITALICS* IS COUNTY STAFFS' INTERPRETATION OF THE RECORD)**

BASED ON EXTENSIVE RESEARCH AND RECOVERY OF EVIDENCE, THIS OFFICE HAS DETERMINED THAT MOST GENERAL LAND OFFICE SURVEYORS IN BENTON COUNTY BEFORE 1890 MEASURED TO THE FACE OF BEARING TREES.

- [01] GENERAL LAND OFFICE (GLO) NOTES BY DENNIS HATHORN, D.S., DATED JULY 7, 1856. *SET POST FROM WHICH A BURNT CEDAR 36" DIA BEARS N12°E, 36 LINKS (23.76 FEET); BURNT FIR 31" DIA BEARS S75°W, 24 LINKS (15.84 FEET).*
- [02] RESTORED CORNER FORM FOR OREGON STATE BOARD OF FORESTRY BY LOUIS W. AMORT, P.E., DATED JULY 13, 1959. *SET 1-1/2" X 36" GALVANIZED IRON PIPE WITH 3" BRONZE CAP MARKED "OREGON STATE BOARD OF FORESTRY 1/4 S33 S4 1959 RE2311", 32 INCHES IN GROUND, FROM WHICH A FIR SNAG 38" DIA (GLO BT) BEARS S75°W, 24 LINKS (15.84 FEET), SCRIBES "1/4S" VISIBLE; FIR 24" DIA BEARS S22°W, 31.1 FEET, SCRIBED "1/4 S4 BT RE2311"; FIR 37" DIA BEARS N58°W, 50.9 FEET, SCRIBED "1/4S 33 BT". METAL LOCATION POSTER ON FIR 45" DIA BEARS N26°E, 26.9 FEET. SET 4" X 4" X 72" WHITE PAINTED CEDAR POST 1 FOOT SOUTHEAST OF PIPE.*
- [03] BENTON COUNTY CORNER RESTORATION NO. 1147. *COPIED FROM RECORD [02] AND MAY CONTAIN ERRORS AND/OR OMISSIONS.*
- [04] BENTON COUNTY SURVEY NO. 3283 BY LOUIS W. AMORT, P.E., DATED AUGUST 6, 1959. *SET 1-1/2" G. I. P. WITH 3" BRONZE CAP. FIR 24" DIA BEARS S22°W, 31.1 FEET; FIR 37" DIA BEARS N58°W, 50.9 FEET.*
- [05] BENTON COUNTY SURVEY NO. 7435 BY JIM S. PETERSON, P.L.S., DATED AUGUST 6, 1982. *FOUND OREGON STATE BOARD OF FORESTRY BRASS CAP. ROTTED FIR STUB (GLO BT) BEARS S75°W, 16.0 FEET TO CHOPPED FACE; FIR 48" DIA BEARS S26°W, 29.2 FEET, HEALED FACE; FIR STUMP 40" DIA BEARS N58°W, 50.9 FEET, HEALED FACE.*
- [06] BENTON COUNTY CORNER RESTORATION NO. 3065 BY JIM S. PETERSON, P.L.S., DATED AUGUST 6, 1982. *TRANSCRIBED FROM RECORD [05] AND MAY CONTAIN ERRORS AND/OR OMISSIONS.*
- [07] BENTON COUNTY SURVEY NO. 7546, BY JIM S. PETERSON, P.L.S., DATED JULY 22, 1983. *FOUND OREGON STATE BOARD OF FORESTRY BRASS CAP.*
- [08] BENTON COUNTY SURVEY NO. 9819, BY JIM S. PETERSON, P.L.S., DATED SEPTEMBER 9, 1999. *FOUND 3" OSBF BRASS CAP (1959). FOUND ROTTED FIR STUMP (GLO BT) BEARS S75°W, 24 LINKS (15.84 FEET), NO MARKS VISIBLE; FIR STUMP 40" DIA BEARS N58°W, 50.9 FEET, HEALED FACE; FIR STUMP 48" DIA BEARS S26°W, 29.2 FEET, HEALED FACE. SET FIR 8" DIA BEARS S53°W, 19.5 FEET, MARKED "1/4 S4 BT"; FIR 10" DIA BEARS N18°W, 29.0 FEET, MARKED "1/4 S33 BT"; ALDER 16" DIA BEARS N80°E, 26.9 FEET, MARKED "1/4 S33 BT" IN BARK; ALDER 18" DIA BEARS S58°E, 40.4 FEET, MARKED "1/4 S4 BT" IN BARK.*
- [09] BENTON COUNTY SURVEY NO. 9937, BY JIM S. PETERSON, P.L.S., DATED SEPTEMBER 9, 1999. *COPY OF RECORD [08].*

**FIRM/AGENCY:** BENTON COUNTY SURVEYOR'S OFFICE  
**ADDRESS:** 360 S.W. AVERY AVE., CORVALLIS, OR 97333; PH. 541-766-6821  
**RESEARCH BY:** DAVID L. MALONE, P.L.S.  
**DATA ENTRY BY:** SAME AS ABOVE

RESTORED CORNER FOR OREGON STATE BOARD OF FORESTRY

One Quarter corner common to Sections 33 and 4,  
T. 11 and 12S, R7W, W.M., Benton County, Oregon.

ORIGINAL

Post (now missing) from which a:

36" Burnt Cedar bears N12°E 56 lks.; now missing.

30" Fir bears S75W 24 lks.; now 38" snag, scribes 1/4S visible.

RESTORED

Set 1 1/2" x 36" galvanized iron pipe with 3" bronze cap marked "OREGON STATE BOARD OF FORESTRY 1/4 S33 S4 1959 RE2311", 32 inches in ground, and from which a:

24" Fir bears S22°W 31.1 ft.; scribed 1/4 S4 BT RE2311.

37" Fir bears N58W 50.9 ft.; scribed 1/4S 33 BT.

Oregon State Board of Forestry metal location poster on 45" Fir N26E 26.9 ft.  
Set 4 x 4 x 72" white painted Cedar post 1 foot S.E. of pipe.

Dated July 13, 1959

Restored by C. Skog under my direction.  
C. Skog



Present and witnessed by H. Baughn

11-7-33  
and 12-7-4

RESTORED CORNER FOR OREGON STATE BOARD OF FORESTRY

1147

One Quarter corner common to Sections 33 and 4,  
T. 11 and 12S, R7W, W.M., Benton County, Oregon.

ORIGINAL

Post (now missing) from which a:

36" Burnt Cedar bears N12°E 56 lks.; now missing.  
30" Fir bears S75W 24 lks.; now 38" snag, scribes 1/4S visible.

RESTORED

Set 1 1/2" x 36" galvanized iron pipe with 3" bronze cap marked "OREGON STATE BOARD  
OF FORESTRY 1/4 S33 S4 1959 RE2311", 32 inches in ground, and from which a:

24" Fir bears S22°W 31.1 ft.; scribed 1/4 S4 BT RE2311.  
37" Fir bears N58W 50.9 ft.; scribed 1/4S 33 BT.


Oregon State Board of Forestry metal location poster on 45" Fir N26E 26.9 ft.  
Set 4 x 4 x 72" white painted Cedar post 1 foot S.E. of pipe.

Dated July 13, 1959

Restored by

C. Skog  
C. Skog

under my direction.

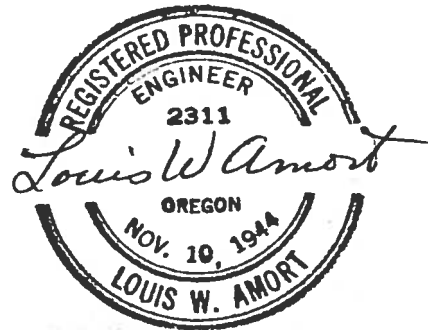

Present and witnessed by H. Baughn

BENTON COUNTY SURVEYORS OFFICE - CORNER RESTORATION

03065

T 11 S, R 7 W, W. B. & M., BENTON COUNTY, OREGON


REPORTED BY JIM PETERSON

SECTION 33

The information shown hereon was taken from  
the referenced county survey. Date: 7/31/90

TITLE L.S. 1084

DATE 8-6-1982

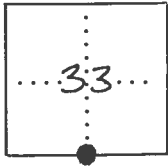

● OFFICIAL CORNER FOUND

○ CORNER SET

1/4 CORNER COMMON TO SEC. 33 & 4  
IS OREGON STATE BOARD OF FORESTRY  
DESCRIBE

ADDITIONAL INFORMATION

BRASS CAP.

SEE C.S. 7435

OVER

LEGIBLE MARKS ON BEARING OBJECTS

	CHOPPED FACE	HEALED FACE	HEALED FACE
KIND	<u>FOUND ROTTED FIR STUB</u>	<u>FOUND FIR</u>	<u>FOUND FIR STUMP</u>
SIZE	<u>—</u>	<u>48"</u>	<u>40"</u>
BEARING	<u>S. 75° W.</u>	<u>S. 26° W.</u>	<u>(N. 58° W.)</u>
DISTANCE	<u>16.0'</u>	<u>29.2'</u>	<u>(50.9')</u>
BT TAG POSTED			