

117340460

ESTABLISHED CORNERS FOR OREGON STATE BOARD OF FORESTRY

Center North one sixteenth corner for Section 16,
T11S, R7W, W.M., Benton County, Oregon.

1058

ESTABLISHED

Var. 20½E

Set 1½" x 36" galvanized iron pipe with 3" bronze cap marked "OREGON STATE
BOARD OF FORESTRY N 1/16 6C S16 1960 RS359", 30 inches in ground, on
North edge of bench, and from which a:

14" Fir bears S82½W 8.6 ft.; scribed CN 1/16 S16 BT RS359.
11" Fir bears S33½E 18.9 ft.; scribed CN 1/16 S16 BT.

Set 4 x 4 x 72" white painted Cedar post 1.1 ft. NE of pipe.
Oregon State Board of Forestry metal location poster on 11" Fir BT.

~~Center one quarter corner for Section 16, T11S, R7W, W.M.,
Benton County, Oregon.~~

~~ESTABLISHED~~

~~Var. 20½E~~

~~Set 1½" x 36" galvanized iron pipe with 3" bronze cap marked "OREGON STATE
BOARD OF FORESTRY C 1/4 S16 1960 RS359", 30 inches in ground, on East
edge of ridge top, and from which a:~~


~~12" Fir bears S80½E 5.5 ft.; scribed C 1/4 S16 BT.
16" Fir bears N22E 18.7 ft.; scribed C 1/4 S16 BT.~~

~~10" Fir bears N13½W 15.2 ft.; scribed RS359.~~

~~Set 4 x 4 x 72" white painted Cedar post 1.5 ft. SW of pipe.
Oregon State Board of Forestry metal location poster on 10" Fir N13½W
15.2 ft.~~

Dated June 17, 1960

Established by

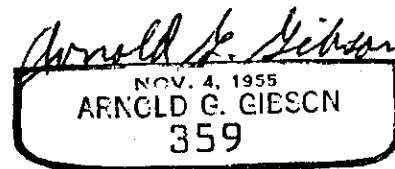

Present and witnessed by D. McConnell
R. Aaserude