

117340500

DATE 04/14/2021TOWNSHIP 11 SOUTH, RANGE 7 WEST, WILLAMETTE MERIDIAN; SECTION 9 CORNER SOUTH 1/4
DONATION LAND CLAIM N/A CORNER N/A**COMMON CORNER(S):**

NORTH 1/4 CORNER SECTION 16

RECORDS (INFORMATION IN *BOLD ITALICS* IS COUNTY STAFFS' INTERPRETATION OF THE RECORD)

BASED ON EXTENSIVE RESEARCH AND RECOVERY OF EVIDENCE, THIS OFFICE HAS DETERMINED THAT MOST GENERAL LAND OFFICE SURVEYORS IN BENTON COUNTY BEFORE 1890 MEASURED TO THE FACE OF BEARING TREES.

- [01] GENERAL LAND OFFICE (GLO) NOTES BY DENNIS HATHORN, D.S., DATED JULY 7, 1856. *SET POST FROM WHICH A FIR 24" DIA BEARS N1°W, 27 LINKS (17.82 FEET); FIR 24" DIA BEARS S65°W, 36 LINKS (23.76 FEET).*
- [02] BENTON COUNTY SURVEY NO. 497 (OLD NO. 199) FIELD NOTES (FIELD BOOK 18, PAGE 56) BY W. C. GALLOWAY, C.S., DATED FEBRUARY 15, 1915. *SET 1/2" IRON ROD. TWO STUMPS STANDING. FIR 10" DIA BEARS S80°E, 0.294 CHAINS (19.40 FEET); FIR 7" DIA BEARS S8°W, 0.162 CHAINS (10.69 FEET).*
- [03] BENTON COUNTY CORNER RESTORATION BOOK NO. 1, PAGE 90, BY W. C. GALLOWAY, C.S., DATED FEBRUARY 16, 1915. *SET 1/2" IRON ROD OR PART OF A RINGER. 2 STUMPS, LETTERS ON ONE. FIR 10" DIA (CSBT) BEARS S80°E, 0.294 CHAINS (19.40 FEET); FIR 7" DIA (CSBT) BEARS S8°W, 0.162 CHAINS (10.69 FEET).*
- [04] BENTON COUNTY CORNER RESTORATION NO. 1021. *TRANSCRIBED FROM RECORD [03] AND MAY CONTAIN ERRORS AND/OR OMISSIONS.*
- [05] BENTON COUNTY MAP NO. 11-7-00001 BY W. C. GALLOWAY, C.S., DATED FEBRUARY, 1915. *1/2" IRON ROD. FIR 10" DIA (CSBT) BEARS S80°E, 0.294 CHAINS (19.40 FEET); FIR 7" DIA (CSBT) BEARS S8°W, 0.162 CHAINS (10.69 FEET).*
- [06] BENTON COUNTY MAP NO. 11-7-00008 BY UNKNOWN DRAFTSMAN, NO DATE GIVEN. *1/2" IRON ROD. FIR 10" DIA (CSBT) BEARS S80°E, 0.294 CHAINS (19.40 FEET); FIR 7" DIA (CSBT) BEARS S8°W, 0.162 CHAINS (10.69 FEET).*
- [07] BENTON COUNTY BOOK OF ROAD HARDCOPIES PAGE 33, STATE HWY 180, ROUTE 49, ROAD NO. 521, DEVITT-SUMMIT SECTION OF BLODGETT-SUMMIT MARKET ROAD, BY UNKNOWN DRAFTSMAN, NO DATE GIVEN. *IRON ROD. FIR 10" DIA (CSBT) BEARS S80°E, 19.4 FEET; FIR 7" DIA (CSBT) BEARS S8°W, 10.7 FEET.*
- [08] OREGON STATE HIGHWAY DEPARTMENT CONSTRUCTED LINE DRG. NO. 5B-7-13, LINCOLN CO. LINE TO BLODGETT, EDDYVILLE-BLODGETT HIGHWAY, BENTON COUNTY, BY UNKNOWN DRAFTSMAN, DATED OCTOBER, 1936, REVISED FEBRUARY, 1975. *FOUND. CORNER NOT DESCRIBED.*
- [09] BENTON COUNTY BOOK OF ROAD HARDCOPIES PAGE 55, CO. RD. 17590, ROUTE 59, ROAD #579, BY UNKNOWN DRAFTSMAN, NO DATE GIVEN. *CORNER NOT DESCRIBED.*
- [10] BENTON COUNTY ROLL MAP CO. RD. 17590 BY W. C. GALLOWAY, C.S., DATED JANUARY 28, 1938. *1/2" IRON ROD.*
- [11] BENTON COUNTY SURVEY NO. 1520 BY BURT WILKES, D.C.S., DATED MARCH 20, 1941. *1/2" IRON PIN.*
- [12] BENTON COUNTY SURVEY NO. 2515 BY MARTIN L. BEYERLEIN, P.L.S., DATED SEPTEMBER 5, 1953. *FOUND 1/2" ROD. FOUND FIR STUMP 13" DIA (CSBT) BEARS S8°W, 0.162 CHAINS (10.69 FEET), SCRIBING IS PLAIN. FIR 10" DIA (CSBT) BEARS S80°E, 0.294 CHAINS (19.40 FEET) IS GONE, IN DIRT ROAD. MARKED ALDER 9" DIA BEARS N37-1/2°E, BY COMPASS (DEFLECTION 21°), 0.089 CHAINS (5.87 FEET), MARKED "CS 1/4S BT".*
- [13] BENTON COUNTY CORNER RESTORATION NO. 1021. *TRANSCRIBED FROM RECORD [12] AND MAY CONTAIN ERRORS AND/OR OMISSIONS.*
- [14] RESTORED CORNER FOR OREGON STATE BOARD OF FORESTRY BY ARNOLD G. GIBSON, P.L.S., DATED JUNE 18, 1957. *NO EVIDENCE OF ORIGINAL CORNER FOUND. 1/2" IRON ROD FOUND IN PLACE IN MIDDLE OF SKID ROAD FROM WHICH A FIR 10" DIA (CSBT) BEARS S80°E, 29 LINKS (19.14 FEET), NOW MISSING; FIR 7" DIA (CSBT) BEARS S8°W, 16 LINKS (10.56 FEET), NOW ROTTED STUB, SCRIBE "CS 199" REMAINING; ALDER 9" DIA BEARS N27-1/2°E, 9 LINKS (5.94 FEET), BARK SCRIBE "CS 1/4 S BT" VISIBLE. SET 1-1/2" X 36" GALVANIZED IRON PIPE WITH 3" BRONZE CAP MARKED "OREGON STATE BOARD OF FORESTRY 1/4 S9 S16 1957 RS 359" 8" UNDER GROUND, OVER 1/2" ROD, AND FROM WHICH A FIR 15" DIA BEARS S39°W, 33.1 FEET, SCRIBED "1/4S 16 BT RS 359". SET 4" X 4" X 72" WHITE PAINTED CEDAR POST 14.0 FEET EAST OF PIPE.*
- [15] BENTON COUNTY CORNER RESTORATION NO. 1021. *TRANSCRIBED FROM RECORD [14] AND MAY CONTAIN ERRORS AND/OR OMISSIONS.*
- [16] BENTON COUNTY SURVEY NO. 3392 BY ARNOLD G. GIBSON, P.L.S., DATED JULY, 1960. *1/4 CORNER FOUND.*
- [17] OREGON STATE HIGHWAY DEPARTMENT LOCATED LINE DRG. NO. 10C-44-19, DEVITT CREEK SECTION, EDDYVILLE-BLODGETT HIGHWAY, BENTON COUNTY, BY M.L.J., DATED JUNE, 1965. *FOUND BRASS CAP IN IRON PIPE.*
- [18] BENTON COUNTY SURVEY NO. 6172 BY VERLE C. MOORE, P.L.S., DATED JUNE 1, 1976. *FOUND 1-1/2" IRON PIPE WITH BRONZE CAP. FOUND FIR 15" DIA BEARS S39°W, 33.1 FEET.*

DATE 04/14/2021

- [19] BENTON COUNTY SURVEY NO. 6139 BY KENNETH M. WIGHTMAN, II, P.L.S., DATED AUGUST, 1976. *FOUND OREGON STATE BOARD OF FORESTRY BRASS CAP.*
- [20] BENTON COUNTY SURVEY NO. 6139A BY KENNETH M. WIGHTMAN, II, P.L.S., DATED SEPTEMBER 20, 1976. *FOUND OREGON STATE BOARD OF FORESTRY BRASS CAP.*
- [21] BENTON COUNTY SURVEY NO. 7491 BY JOHN D. HOWELL, P.L.S., DATED JANUARY 21, 1983. *FOUND 3" BRASS CAP SET BY OREGON STATE BOARD OF FORESTRY IN 1957.*
- [22] BENTON COUNTY CORNER RESTORATION NO. 3122. *TRANSCRIBED FROM RECORD [21] AND MAY CONTAIN ERRORS AND/OR OMISSIONS.*
- [23] OREGON STATE HIGHWAY DIVISION RIGHT OF WAY DRG NO. 1R-3-1536, CARTER CREEK (DEVITT CREEK BR. SEC.), EDDYVILLE-BLODGETT, BENTON COUNTY, BY UNKNOWN DRAFTSMAN, DATED JANUARY, 1987, REVISED AUGUST, 1987 AND SEPTEMBER, 1987. *FOUND BRASS CAP ON IRON PIPE "STATE FORESTRY 1957".*
- [24] BENTON COUNTY SURVEY NO. 8238 BY PAUL WILLIAM MEYERS, P.L.S., DATED FEBRUARY 21, 1989. *FOUND BRASS CAP ON IRON PIPE "STATE FORESTRY 1957".*
- [25] BENTON COUNTY SURVEY NO. 8367 BY JOHN D. HOWELL, P.L.S., DATED DECEMBER 15, 1989. *FOUND 3" BRASS CAP SET BY OREGON STATE BOARD OF FORESTRY IN 1957.*
- [26] BENTON COUNTY SURVEY NO. 9800 BY JIM S. PETERSON, P.L.S., DATED AUGUST 4, 2000. *FOUND 3" OREGON STATE BOARD OF FORESTRY BRASS CAP. FOUND ALDER 12" DIA BEARS N27-1/2°E, 9 LINKS (5.94 FEET), BARK SCRIBING VISIBLE; FIR STUMP 18" DIA BEARS S39°W, 33.1 FEET, NO MARKS VISIBLE.*

FIRM/AGENCY: BENTON COUNTY SURVEYOR'S OFFICE
ADDRESS: 360 S.W. AVERY AVE., CORVALLIS, OR 97333; PH. 541-766-6821
RESEARCH BY: DAVID L. MALONE, P.L.S.
DATA ENTRY BY: SAME

BENTON COUNTY SURVEYORS OFFICE - CORNER RESTORATION

03122

T. 11 S, R. 7 W, W. B. & M., BENTON COUNTY, OREGON


REPORTED BY JOHN HOWELL

SECTION 9

The information shown hereon was taken from
the referenced county survey. Date: 7/31/80

TITLE L.S. 1901

DATE 1-25-1983

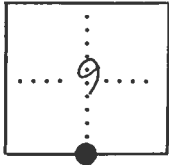

● OFFICIAL CORNER FOUND

○ CORNER SET

1/4 CORNER COMMON TO SEC. _____, _____, 9 & 16
IS 3" BRASS CAP SET BY ORE. STATE
DESCRIBE

ADDITIONAL INFORMATION
BOARD OF FORESTRY, 1957
SEE C.S. 7491

LEGIBLE MARKS ON BEARING OBJECTS

KIND			
SIZE			
BEARING			
DISTANCE			
BT TAG POSTED			

OVER

RESTORED CORNER FOR OREGON STATE BOARD OF FORESTRY

One Quarter corner common to Sections 9 and 16, T. 11S., R. 7W., W.M.,
Benton County, Oregon

ORIGINAL (No evidence of original corner found)

REESTABLISHED by C. S. Feb. 23, 1915.

1/2" iron rod (found in place in middle of skid road) from which a:

10" fir bears S.80°E. 29 lks.; now missing

7" fir bears S.80°W. 16 lks.; now rotted stub, scribe CS 199 remaining.

RESTORED BY C.S. ~~1955~~ ^{2515 DMD 2-14-00}

9" Alder N.27½°E. 9 lks. (bark scribe CS 1/4 S BT visible)

RESTORED

Var. 21°E.


Set 1½" x 36" galvanized iron pipe with 3" bronze cap marked "OREGON STATE
BOARD OF FORESTRY 1/4 S9 S16 1957 RS 359," 8 inches under ground, over
above 1/2" rod, and from which a:

15" fir bears S.39°W. 33.1 ft.; scribed 1/4S 16 BT RS 359

Oregon State Board of Forestry metal location poster on 9" Alder BT.
Set 4 x 4 x 72" white painted cedar post 14.0' E. of pipe.

Dated June 18, 1957

Restored by Elbert Driver under my direction.
Elbert Driver, Engineering Aide

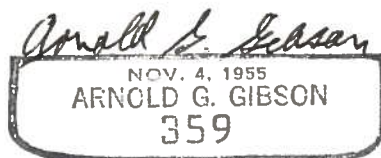

Present and witnessed by Clarence Skog
Don Bentz

BENTON COUNTY CORNER RESTORATION BOOK No. 1

C.S. #198 cont. SE cor. of Thos. H. Garrett D.L.C. # 72 T. 12 S. TR. 6 W.
 Set $\frac{3}{4}$ " iron pin 10" under surface in rock glass broken in hole
 Poplar 26" bears S. 49° 50' W. 1093 chs. not mtd.
 Locus 16" " N. 21° 50' W. 365 " " "
 Witnesses P. F. Smith, E. Koberstein W.H. & Jennie W.H. & Linnie Feb. 4, 1915.

Road #
 Jan-26, 1915

" NW corner of Thos. H. Garrett D.L.C. # 71 T. 12 S. TR. 6 W.
 Set $\frac{5}{8}$ " x 12" I pin
 Oak 24" bears S. 35° W. 350 chs. std.

"
 Jan 26, 1915

Witnesses as last above Feb. 3, 1915.

" Int. cor. on W. side of Robert Garrett D.L.C. # 71 T. 12 S. TR. 6 W.
 Set 1" galv. pipe orig. cor.
 Oak 12" bears N. 66° E. .65 chs. std.
 " 12" " S. 66° E. .91 " " "

Witnesses Ernest Koberstein P.F. Smith & Charles Wood Feb. 4, 1915.

C.S. #
 Feb. 18

" NW exterior cor. of Thos. H. Garrett D.L.C. # 71 T. 12 S. TR. 6 W.
 Set $\frac{3}{4}$ " galv. pipe stake pretty well rotted
 Oak 15" bears S. 55° E. 2.24 chs. std.
 " 36" bears N. 55° W. 1.31 chs. std.

Witnesses Peter Speedy; Geo. W. Soule Feb. 23, 1915.

" SW corner of Robert Garrett D.L.C. # 71 T. 12 S. TR. 6 W.
 Set $\frac{3}{4}$ " galv. pipe stake standing
 Fir 50" N. 15° E. .34 chs. is down.
 " 60" bears N. 28° W. .16 chs. std.

"
 Feb-19-20

Witnesses Peter Speedy Feb. 23, 1915.

" N.W. corner of Thos. J. Blair D.L.C. # 68 T. 12 S. TR. 6 W.
 Set $\frac{3}{4}$ " galv. pipe stake rotten at bottom
 Fir 36" bears N. 52° E. 1.93 chs.

Stone at $\frac{1}{4}$ cor. South .80 + $\frac{3}{4}$ " pipe at S.W. of C.L. 71 S. 33° 35' W. 2054 chs.

Witness Peter Speedy Feb. 23, 1915.

C.S. # 199 $\frac{1}{4}$ Sec. cor. between secs. 9 & 16 T. 11 S. TR. 7 W.
 Set $\frac{1}{2}$ " iron rod or part of a ringer 2 stumps letters on one.
 Fir 10" bears S. 80° E. .294 chs.
 " 7" " S. 80° W. .162 "

Witnesses Jasper Miller, W.D. Stevens, G.F. Hardison, J. Snyder, Feb. 16, 1915.

" $\frac{1}{4}$ Sec. cor. between secs. 9 & 10 T. 11 S. TR. 7 W.
 Set $\frac{3}{4}$ " bolt 2 stumps letters on one the other partly burnt
 Fir 7" bears N. 11° E. .460 chs.
 Ash 10" " N. 66° W. .252 "

Witnesses Jasper Miller W.D. Stevens, F. Barnhard & J. Snyder Feb. 17, 1915.



$\frac{1}{4}$ -Section corner between sections 9 and 16, Twp. 11 S R 7 W

1021

Reestablishment by W. C. Galloway

February 23, 1915

Set $\frac{1}{2}$ " iron rod or part of a ringer. Two stumps, letters on one.
Fir 10" in diam bears S 80° E .294 chains
Fir 7" in diam bears S 8° W .162 chains

Witnesses Jasper Miller, W. D. Stevens, O. F. Hardison, J. Sneyder, Fred Barnhard.

Martin L. Beyerlein

September 5, 1953

Found Fir 7" S. 8°W. 0.162 ch.--now 13" stump--scribing plain

Fir 10" S 80°E. 0.294 ch.--gone, in dirt road

Marked Alder 9" N 37 $\frac{1}{2}$ ° E 0.089 ch., "CS $\frac{1}{4}$ S. BT" (var. 21°)

Elbert Driver

June 13, 1957

Found $\frac{1}{2}$ " iron rod (in place in middle of skid road) from which a:

Fir 10" bears S.80°E. 29 lks.; now missing

Fir 7" bears S.8°W. 16 lks.; now rotted stub, scribe CS199 remaining

Alder 9" bears N.27 $\frac{1}{2}$ °E. 9 lks.; bark scribe CS 1/4 S BT visible

Set 1 $\frac{1}{2}$ " x 36" galv. iron pipe with 3" bronze cap marked "Oregon State Board of Forestry
1/4 S9 S16 1957 RS 359," 8" under ground, over above 1/2" rod, from which:

Fir 15" bears S.39°W. 33.1 ft.; scribed 1/4S 16 BT RS 359

Oregon State Board of Forestry metal location poster on 9" Alder BT

White-painted cedar post 4 x 4 x 72", 14.0' E. of pipe

Witnesses--Clarence Skog, Don Bentz