

117340560

BRUCE STARKER  
FORESTER  
POST OFFICE BOX 809  
7240 S.W. PHILOMATH BLVD.  
TELEPHONE 929-3877  
CORVALLIS, OREGON 97330

July 24, 1975

Mr. Dick Fail  
Benton County Surveyor  
360 S.W. Avery  
Corvallis, OR 97330

Dick:

Following are notes on restoration of a Forty corner which I hope you will file and index for the guidance of future surveyors:

N 1/16 on centerline of Section 9, T.11S., R.7W. W.M. for Marvin B. Clark of Devitt Creek, Blodgett, Oregon.

I found:

3/4" pipe set by W.C.G. per survey sheet 11-7,4,9 in place, No eye. His fir then 15" now 28" fir stump N79°E .123 ch. face plain. washing machine wringer roll alongside ~~pipe~~ SW of pipe.

I set new Bearing Trees:

Fir 25 inches S85-1/4°<sup>W</sup> 58.25 ft. mkd. #310/BT  
Fir 10 inches S22-1/4°E 38.2 ft. mkd. 310/BT  
witnessed by Stony A. Jackson who found corner with Lawrence B. Cook of Blodgett, Oregon.

cc: Marvin & Thelma Clark  
Peggy & Duane Lambert  
S.A. Jackson  
Note file

REGISTERED  
PROFESSIONAL  
LAND SURVEYOR

*Bruce Starker*

OREGON  
NOVEMBER 6, 1953  
BRUCE STARKER  
310

BENTON COUNTY SURVEYORS OFFICE - CORNER RESTORATION

1023


T 11S, R 7, W. B. & M., BENTON COUNTY

REPORTED BY Bruce Starker

SECTION 9

TITLE PLS 310

DATE July 24, 1975

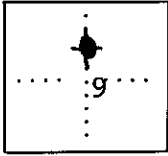

● OFFICIAL CORNER FOUND


○ CORNER SET

CN 1/16 CORNER COMMON TO SEC. 9 & \_\_\_\_\_

IS STONE, IRON ROD, IRON PIPE, BRASS CAP OR \_\_\_\_\_ SIZE 3/4" not reset

OTHER

LEGIBLE MARKS ON BEARING OBJECTS

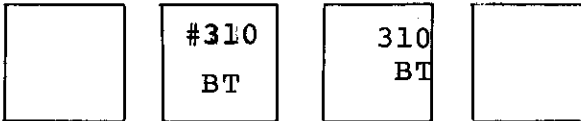

KIND	<u>Fir</u>	<u>Fir</u>	
SIZE	<u>25"</u>	<u>10"</u>	
BEARING	<u>S851/4 W</u>	<u>S221/4E</u>	
DISTANCE	<u>58.25'</u>	<u>38.2</u>	
DISTANCE			
TAG POSTED			

ADDITIONAL INFORMATION

Found 3/4" pipe set by WCG washing machine wringer roller along side to SW

Found Fir 28" stump N 79E .123 ch. face plain

Set new BT only