

117400100

DATE 03/16/2020TOWNSHIP 11 SOUTH, RANGE 7 WEST, WILLAMETTE MERIDIAN; SECTION 33 CORNER SOUTHEAST
DONATION LAND CLAIM N/A CORNER N/A**COMMON CORNER(S):**SOUTHWEST CORNER SECTION 34, TOWNSHIP 11 SOUTH, RANGE 7 WEST
NORTHWEST CORNER SECTION 3, TOWNSHIP 12 SOUTH, RANGE 7 WEST
NORTHEAST CORNER SECTION 4, TOWNSHIP 12 SOUTH, RANGE 7 WEST**RECORDS (INFORMATION IN *BOLD ITALICS* IS COUNTY STAFFS' INTERPRETATION OF THE RECORD)**

BASED ON EXTENSIVE RESEARCH AND RECOVERY OF EVIDENCE, THIS OFFICE HAS DETERMINED THAT MOST GENERAL LAND OFFICE SURVEYORS IN BENTON COUNTY BEFORE 1890 MEASURED TO THE FACE OF BEARING TREES.

- [01] GENERAL LAND OFFICE (GLO) NOTES BY DENNIS HATHORN, D.S., DATED JULY 7, 1856. SET POST FROM WHICH A FIR 20" DIA BEARS N2-1/2°E, 165 LINKS (108.90 FEET); FIR 15" DIA BEARS N12°W, 120 LINKS (79.20 FEET); FIR 40" DIA BEARS S60°E, 158 LINKS (104.28 FEET); MAPLE 20" DIA BEARS S40°W, 244 LINKS (161.04 FEET).
- [02] BENTON COUNTY SURVEY NO. 175 (OLD NO. 73) FIELD NOTES (FIELD BOOK 5, PAGE 53) BY W. C. GALLOWAY, D.C.S., NO DATE GIVEN. SET 3/4" PIPE. ORIGINAL CORNER. FIR 20" DIA (GLO BT) BEARS N2°30'E, 1.65 CHAINS (108.90 FEET), STANDING; FIR 40" DIA (GLO BT) BEARS S60°E, 1.54 CHAINS (101.64 FEET), STANDING; FIR 22" DIA BEARS S82°20'W, 0.636 CHAINS (41.98 FEET); FIR 24" DIA BEARS N16°45'W, 1.375 CHAINS (90.75 FEET).
- [03] BENTON COUNTY CORNER RESTORATION BOOK NO. 1, PAGE 10, BY W. C. GALLOWAY, D.C.S., DATED AUGUST 19, 1910. SET 3/4" PIPE. ORIGINAL CORNER. FIR 20" DIA (GLO BT) BEARS N2°30'E, 1.65 CHAINS (108.90 FEET), STANDING; FIR 40" DIA (GLO BT) BEARS S60°E, 1.04 CHAINS (68.64 FEET), STANDING; FIR 22" DIA (CSBT) BEARS S82°20'W, 0.636 CHAINS (41.98 FEET); FIR 24" DIA (CSBT) BEARS N15°15'W, 1.375 CHAINS (90.75 FEET).
- [04] BENTON COUNTY CORNER RESTORATION NO. 1603. TRANSCRIBED FROM RECORD [03] AND MAY CONTAIN ERRORS AND/OR OMISSIONS.
- [05] BENTON COUNTY SURVEY NO. 175 (OLD NO. 73), RECORD BOOK OF PLATS "SURVEY RECORDS" BOOK 3, PAGE 65 BY UNKNOWN DRAFTSMAN, NO DATE GIVEN. 3/4" PIPE.
- [06] BENTON COUNTY MAP NO. 11-7-00015 BY W. C. GALLOWAY, C.S., DATED JUNE, 1915. 3/4" PIPE. FIR 20" DIA (GLO BT) BEARS N2°30'E, 1.65 CHAINS (108.90 FEET), STANDING; FIR 40" DIA (GLO BT) BEARS S60°E, 1.04 CHAINS (68.64 FEET), STANDING; FIR 22" DIA (CSBT) BEARS S82°20'W, 0.636 CHAINS (41.98 FEET); FIR 24" DIA (CSBT) BEARS N15°15'W, 1.375 CHAINS (90.75 FEET).
- [07] BENTON COUNTY BOOK OF ROAD HARDCOPIES, PAGE 56, CO. RD. #17490 & 27491, ROUTE 49 & 49-01, ROAD NO. 580, BY UNKNOWN DRAFTSMAN, NO DATE GIVEN. 3/4" PIPE.
- [08] BENTON COUNTY MAP NO. 12-7-00002 BY W. C. GALLOWAY, C.S., DATED JUNE, 1936. 3/4" PIPE.
- [09] RESTORED CORNER FORM FOR OREGON STATE BOARD OF FORESTRY BY ARNOLD G. GIBSON, P.L.S., DATED APRIL 22, 1958. FIR 50" DIA (GLO BT) BEARS N2-1/2°E, 165 LINKS (108.90 FEET), FACE COVERED; FIR 62" DIA (GLO BT) BEARS S60°E, 158 LINKS (104.28 FEET), FACE COVERED. FOUND 3/4" PIPE FROM WHICH A FIR 34" DIA (CSBT) BEARS S82°20'W, 63.6 LINKS (41.98 FEET), PORTION OF SCRIBE VISIBLE; BROKEN OFF FIR STUMP (CSBT) BEARS N15°15'W, 137.5 LINKS (90.75 FEET), 2/3 GROWN OVER BY FIR 52" DIA. SET 1-1/2" X 36" GALVANIZED IRON PIPE WITH 3" BRONZE CAP MARKED "OREGON STATE BOARD OF FORESTRY T11S R7W S33 S34 S3 S4 T12S 1958 RS359", 33" IN GROUND, OVER 3/4" PIPE, FROM WHICH A FIR 60" DIA BEARS S70°E, 38.1 FEET, SCRIBED "T12S R7W S3 BT RS359"; FIR 38" DIA BEARS N65-1/2°E, 70.0 FEET, SCRIBED "T11S R7W S34 BT"; FIR 52" DIA BEARS N17°W, 89.3 FEET, SCRIBED "T11S R7W S33 BT". SET 4" X 4" X 72" WHITE PAINTED CEDAR POST 1.0 FOOT SOUTHWEST OF PIPE.
- [10] BENTON COUNTY CORNER RESTORATION NO. 1603. TRANSCRIBED FROM RECORD [03] AND MAY CONTAIN ERRORS AND/OR OMISSIONS.
- [11] BENTON COUNTY SURVEY NO. 3283 BY LOUIS W. AMORT, P.E., DATED AUGUST 6, 1959. SECTION CORNER FOUND.
- [12] BENTON COUNTY SURVEY NO. 7435 BY JIM S. PETERSON, P.L.S., DATED AUGUST 6, 1982. FOUND OREGON STATE BOARD OF FORESTRY BRASS CAP.
- [13] BENTON COUNTY CORNER RESTORATION NO. 3069. TRANSCRIBED FROM RECORD [11] AND MAY CONTAIN ERRORS AND/OR OMISSIONS.
- [14] BENTON COUNTY SURVEY NO. 9896 BY JIM S. PETERSON, P.L.S., DATED SEPTEMBER 9, 1999. FOUND OREGON STATE BOARD OF FORESTRY BRASS CAP. FOUND FIR 44" DIA (CSBT) BEARS S82°20'W, 0.636 CHAINS (41.98 FEET), HEALED FACE; FIR STUMP 60" DIA BEARS N17°W, 89.3 FEET, HEALED FACE; FIR STUMP 60" DIA BEARS S70°E, 38.1 FEET, HEALED FACE.

FIRM/AGENCY: BENTON COUNTY SURVEYOR'S OFFICE
ADDRESS: 360 S.W. AVERY AVE., CORVALLIS, OR 97333; PH. 541-766-6821
RESEARCH BY: DAVID L. MALONE, P.L.S.
DATA ENTRY BY: SAME

Survey #70
W.C. Callaway

S.W. cor. of Geo. L. Boone D.L.C. 42 Tp. 13-5.
Set stake orig. cor.
Oak 24" in dia. bears S. 28° E. 1.05' std.
" 15" " " " S. 89° W. 3.43' "
Witness J. F. Buchanan July 19, 1910.

Survey
W.C.

#72
W.C. G.

Sec. cor. to sec. 1, 2, 35+36 Tp. 14+15-5
Set 3/4" pipe
An oak 15" in dia. bears S. 75° E. 1.05' std.
" " 5" " " " S. 87° W. .36' "
Witness Geo. Birmingham + H. D. Bowman Aug. 5, 1910.

#73
W.C. G.

Sec. cor. to sec. 3, 4, 33+34 Tp. 11-7
Set 3/4" pipe orig. cor.
Fir 20" in dia. bears N. 2° 30' E. 1.65' std.
" 40" " " " S. 60° E. 1.04' " (1.58 ginner)
" 22" " " " S. 82° 20' W. .636'
" 24" " " " N. 15° 15' W. 1.375'

Witness F. M. Taylor + C. Scherer Aug. 19, 1910.

" V

1/4 sec. cor. between sec. 33+34 Tp. 11-7.
Set 3/4" pipe orig. cor. one stump
Fir 24" in dia. bears S. 56° 53' W. 1.716'
" 12" " " " N. 14° W. 1.403'

Witness F. M. Taylor + A. Taylor Aug. 22, 1910.

" V

Sec. cor. to sec. 27, 28, 33+34 Tp. 11-7.
Set 1" pipe orig. cor. snag S.E. std.
Fir 40" in dia. bears N. 68 1/2° E. 4.50' std. (4.90 ginner)
" 14" " " " S. 26° 7' E. .358'
" 36" " " " S. 2° W. 4.07' " (4.42")
" Snag 20" " " " N. 57° W. 2.35' "

Witness F. M. Taylor + A. Taylor Aug. 22, 1910.

" "

1/4 sec. cor. between sec. 27+34 Tp. 11-7.
Set stone orig. cor. found stump print near road.
Oak 18" in dia. bears N. 30° 3' E. 1.166'
Fir 30" " " " S. 89° E. 3.32' std. (3.22 ginner)

Witness F. M. + A. Taylor Aug. 23, 1910.

" V

1/4 sec. cor. between sec. 3+34 Tps. 11+12-7.
Set small stone under stake part of stump left.
Fir 30" in dia. bears S. 75° 02' E. .950'
" 24" " " " N. 7° E. .300' std.

Witness F. M. + A. Taylor Aug. 25, 1910.

#74
W.C. G.

Sec. cor. to sec. 1, 6, 31+36 or Tp. cor. Tps. 11+12-7+8.
Set stone orig. cor. 4 stumps found
Fir 10" in dia. bears N. 38° 40' E. 1.058'
" 12" " " " S. 77° 10' E. .705' slope measure
" 24" " " " S. 34° 6' W. 1.397'
" 19" " " " N. 5° 35' W. 1.429' " " 3' high above cor.
Witness Robert Schaffer, W.C. Siefanth + Ivan Taylor Aug. 30, 1910.

W.C.

W.C.

11-7 33

Section Corner to Sections 3, 4, 33, and 34, Twp. 11-7 and 12-7

Reestablishment by W. C. Galloway

August 19, 1910

1603

1358

Set 3/4" pipe original corner 4/22/58
 Fir 20" in diam bears N. 2° 30' E (now 50") 1.65 chains (standing)
 Fir 40" in diam bears S. 60° E (now 62") 1.04 chains (standing) 1.58 given)
 Fir 22" in diam bears S. 82° 20' W (now 34") .636 chains
 Fir 24" in diam bears N. 15° 15' W (stump) 1.375 chains

Witnesses F. M. Taylor and C. Schoker

Reestablishment by Arnold G. Gibson

April 22, 1958

Set 1 1/2" x 36" iron pipe with 3" cap, 33" in ground over 3/4" pipe
 Fir 60" S 70 E 38.1 ft.
 Fir 38" N 65 1/2 E 70.0 ft.
 Fir 52" N 17 W 89.3 ft.

1359

Set 4 x 4 x 72" cedar post 1.0 ft. SW of pipe
 Metal location poster on Fir 22" BT
 Witnesses David Steenson, C. Skog

FOR ADDITIONAL INFORMATION SEE THE THIS R7W FILE IN THE CORNER RESTORATION CORRESPONDENCE FILE DRAWER (CJL 7/17/90).

RESTORED CORNER FOR OREGON STATE BOARD OF FORESTRY

Section corner common to Sections 3, 4, 33 and 34,
T. 11 & 12S, R. 7W, W.M., Benton County, Oregon.

ORIGINAL

Post (now missing) from which a:

- 20" Fir bears N2½E 165 lks.; now 50", face covered.
- 15" Fir bears N12W 120 lks.; now missing.
- 40" Fir bears S60E 158 lks.; now 62", face covered.
- 20" Maple bears S40W 244 lks.; now missing.

RESTORATION by W. C. Galloway survey #73, Aug. 19, 1910

Set 3/4" pipe (found in place) from which a:

- 22" Fir bears S82° 20' W 63.6 lks.; now 34", portion of scribe visible.
- 24" Fir bears N15° 15' W 137.5 lks.; now broken off stump 2/3 grown over by a 52" Fir.

RESTORED

Set 1½" x 36" galvanized iron pipe with 3" bronze cap marked "OREGON STATE BOARD OF FORESTRY T11S R7W S33 S34 S3 S4 T12S 1958 RS359," 33 inches in ground, over 3/4" pipe, and from which a:


- 60" Fir bears S70E 38.1 ft.; scribed T12S R7W S3 BT RS359.
- 38" Fir bears N65½E 70.0 ft.; scribed T11S R7W S34 BT.
- 52" Fir bears N17W 89.3 ft.; scribed T11S R7W S33 BT.

Set 4 x 4 x 72" white painted Cedar post 1.0 ft. SW of pipe.

Oregon State Board of Forestry metal location poster on 22" Fir BT.

Dated April 22, 1958.

Restored by David Steenson under my direction.
David Steenson, Engineering Aide

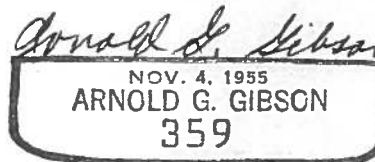

Present and witnessed by Clarence Skog

BENTON COUNTY SURVEYORS OFFICE - CORNER RESTORATION

03069

T 11 S, R 7 W, W. B. & M., BENTON COUNTY, OREGON


REPORTED BY JIM PETERSON

SECTION 33

The information shown hereon was taken from
the referenced county survey. Date: 7/31/90

TITLE L.S. 1084

DATE 8-6-1982

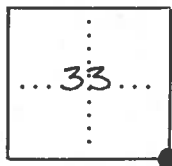

● OFFICIAL CORNER FOUND

○ CORNER SET

SEC CORNER COMMON TO SEC. 33 34 3 & 4
IS FOUND OREGON STATE BOARD OF
DESCRIBE

ADDITIONAL INFORMATION

FORESTRY BRASS CAP.

SEE C.S. 7435

LEGIBLE MARKS ON BEARING OBJECTS

KIND			
SIZE			
BEARING			
DISTANCE			
BT TAG POSTED			

OVER