

C 41 on N E corner S 1/4

then North on S 1/4 to run with the
line on West Boundary claim 41

40 10 Set temporary iron corner
80 18 found to be NW claim 41 Bearing to
the pole decayed I marked a
fir 30 in in diam brs S 17° W 74 lbs

then South on West Boundary claim 41
40 09 Set Iron Rock 6x7x10 14 in in ground Mark
1/2 C 41 S.E. from which a
fir 30 in in diam brs N 20° E 64 lbs

then East on N Boundary traverse line
Va 24°

11 50 Enter field
40 00 Marked 32 lbs N of N E corner C
Set Sand Rock 5x10x15 marked C 41 S.E.
Bearing true in good condition

then from N W Cor claim 45 2 in
East on South Boundary claim 41
21 00 S E Cor claim 41 Set Iron Rock 8x5
Marked C 41 S.E. found heavy tree in
good condition

RECORD BOOK OF SURVEYS
ANDREW PORTER
1889-1891

then North
80 20 N E Cor claim 41
then South on East Boundary PAGE 65

40 10 Set Iron Rock 5x10x24 for Cor

C.S. 140. S.E. corner Wm. W. Dow's Cl. 45 T145 R5W.
 = 1/4 cor. Set 3/4" pipe 12" under surface.
 Fence south .339 chains
 Telephone pole S.E. 476

S.E. cor. Hse. N76°24'E
 N.E. cor. Schul hse. S37°47'E
 W. comb barn S47°9'E
 S.E. cor. Hse. S79°22 1/2'W.
 Cor. fence S. of road S72°15'E 1206

N.E. cor. Wm. W. Dow's Cl. 45 T145 R5W.
 Set 1/4" pipe
 pipe south 7.33 chains

1/4 sec. cor. between sec's. 11+14 T145 R5W
 Set 1/2" pipe from which a
 1/2" pipe bears N89°48'E 7.58 chains

N.E. corner Joseph M. Lafferty Cl. 46 T145 R5W
 Set 1/2" pipe from which
 12" Oak post S47°W. 355 chains.
 N.W. corner House S36 1/2'E. 1.566 "
 Fence North .136 "

1/4 corner between sections 13+14 T14-5
 Set plow shear stake & stone (Bulldozed out
 by V. Volker)
 Fir 30" dia bears N78°E. 352 chains
 Pine 24" " " S. 1° E. 1.15 "
 " 30" " " N87°W. 1.28 "
 Reset a 3/4" rod with Model T transmission over ^{surf} No Trees

N.W. corner Geo. Coffee Cl. 68 T145 R5W
 Set pipe

N.E. corner Isaac Winkle Cl. 47 T. 135 R5W.
 Set 3/4" iron rod
 Corner post 14" in dia. bears S.W. .010 chs.
 Oak 14" in diameter bears south 2.958 "

Shanghai Bldg Co.
 at Derit
 W. M. Lamm

Shanghai Bldg Co.
 at Derit
 W. M. Lamm

1/4 cor betw. Secs. 2+11 T11S R7W. W.M.
 Set fir limb
 Fir 8" in dia. bears N38°E .16 chs.
 Fir 36" dia " " N15°W. 1.88 " std.

N.E. cor. Wesley Kelley Cl. 41 T 11S R7W. W.M.
 Set stone 6x10x14"
 Oak 30" in dia bears S38 1/2°W .51 chs. dist
 Fir 20" " " " N87°E .29 " "

N.W. cor. Wesley Kelley Cl. 41 T. 11S R7W. W.M.
 Set 1" pipe, 1" pipe E. 20' and 1" pipe W. 20'
 Stump bears S46 1/2°E. 1.77 chs.
 Post East .02 "
 Cor Post East .23 "

N. E. corner Wesley Kelley Cl 41, Twp. 11 S., R. 7 W. W. M.

Reestablishment by W. C. Galloway

Date 10-1-1925 1180

Set stone 6" x 10" x 14"

Oak 30" in diam bears S $38\frac{1}{2}^{\circ}$ W
Fir 20" in diam bears N 87° E

.51 chains
.29 chains

BENTON COUNTY CORNER RESTORATION FORM

3806

SECTION 11 TOWNSHIP 11 S RANGE 7 W DLC 41 (Wesley Kelley) CORNER NE
DATE 7-18-90 CORNER RESTORATION FIELD BOOK NUMBER PAGE

CORNER DESIGNATION:

NE corner of DLC 41, T11S, R7W
(Wesley Kelley)

DLC 41

- CONDITION REPORT ONLY
- REFERENCED OUT
- RENEWED
- SURVEYED IN

LOCATION AND COMMENTS:

Corner lies on gentle West slope, 300 ft. East of swale, and 50 ft. West of a new logging road.

PREVIOUS RENEWALS/SURVEYS, ETC:

- | | |
|---|---|
| 1857 - Original survey by E. A. Davis | 1889-1891 - Andrew Porter survey, page 65 |
| 1925 - Corner restoration 1180 by W.C. Galloway | Galloway Hard Copy 11-7-00006 |
| 1960 - C.S. 3455 by R.W. Hutchison | 1925 - C.S. 957 by W.C. Galloway |
| 1962 - C.S. 3644 by F. Lemke | |
| 1976 - C.S. 06197 by F. Wright | |
| 1979 - C.S. 6893 by D. Harms | |


MONUMENTS AND ACCESSORIES FOUND (CONDITION AND SOURCE):

Found 3/4" iron pipe as per C.S. 3455. Broken stone with markings found alongside.


BT's found:

- 1) 30" Oak Uproot, S38 1/2°W, 33.7 ft. (S38 1/2°W, 51 lks. - 1856) - No marks visible
- 2) 26" Fir Stump N87°E, 19.1 ft. to face (N87°E, 29 lks - 1925) Scribing visible
- *3) 24" Fir N52° 43'W, 10.70ft. (N52° 43'W, 15.9 lks - 1960) Healed face - Set BT tag
- *4) 26" Fir S31° 26'W, 55.90FT. (S31° 26'W, 84.7 lks - 1960) Healed face - Set BT tag

MONUMENT DETAIL

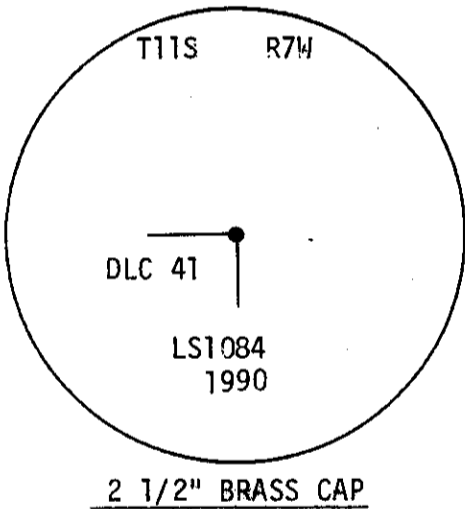

SKETCH

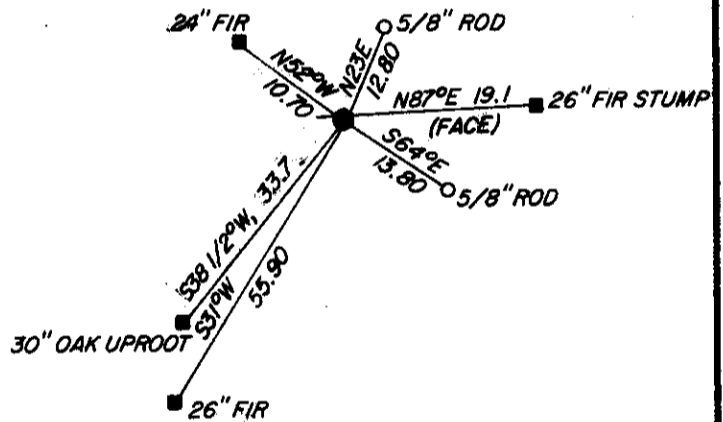

MONUMENT SET (PROCEDURES AND DESCRIPTION):

Set 2" X 30" galvanized iron pipe with 2 1/2" Brass cap stamped as shown. Brass cap is 0.5 ft. above ground. Buried found pipe and stone alongside brass cap.

NEW ACCESSORIES:

- Set 5/8" X 30" iron rod with plastic cap (LS 1084), N23°E, 12.80ft.
- Set 5/8" X 30" iron rod with plastic cap (LS 1084), S64°E, 13.80ft.
- Iron rods are set flush with ground.
- Set orange fiberglass "Survey Marker" post

NOTES:

*Set PK nail with stainless steel washer in side center of base of BT. BT distances are to side center of tree. Accessory bearings are determined using a hand compass (Decl.=20° East) except as noted.

FIRM/AGENCY: J. Peterson & Associates, Land Surveyors
 ADDRESS: 8155 NW Mitchel Drive
 PARTY CHIEF: Corvallis, Oregon 97330 Phone 757-1794
 CREW: Jim S Peterson - Joe B. Hinds
 WITNESS:

**REGISTERED
PROFESSIONAL
LAND SURVEYOR**



OREGON
JULY 31, 1976
JIM S. PETERSON
1084