


126200420



26 April, 1955

County Surveyor
Benton County
Corvallis, Ore.

Bruce Staker

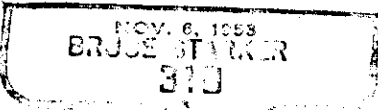

Dear Curtis:

There follows my notes on the re-marking of original corners in Benton county during the past month.

At the section corner common to 16-17-20-21 in T 12S, R6W.

17/6
SEE COR.
EST. NO.
393
(CJL 7/12/90)

Notes:
Stone 7x5x10"
pipe
F 12" N 89°E 2.7 (ch)
Alder 4" S 4° E 2.18 (ch)
F 18" S 26°W 2.42
Oak 8" N 7° W 1.46

Found:
in place
in place
probable tree bears N 87½° E
with face towards Cor.
not located
60" stump
down and rotted
Marked:
Fir 20" N 45°E 19.1 ft.
with bark scribe :
" #310 S 16 BT "

17/6
SEE COR.
EST. NO.
402
(CJL 7/17/90)

At the South 1/16th corner on the line common to Sections 17 and 18 in same Twp 12 S, R 6 W. W.M.

Notes:
Stone 8x8x8"
F 32" N 70° W 0.230
F 30" N 70° E 0.098

Now:
Not found;- in skid road,
presumed dozed out
Stump with face
uprooted stump with face
Marked:
Set 1½" pipe for corner
F 61" N 46°E 63.8 ft.
Bark scribed : "#310 1/16 BT".

11/7
SEE COR.
EST. NO.
008 (CJL 7/12/90)

At the quarter corner between Sections 7 and 18, T 11S, R 7 W:

Notes:
Fir 20" S 46° 40' W 0.945 (ch)
Stone and bolt

Now:
Stump with plain face
Stone in place, broken; bolt loose
on ground; replaced by me.
Marked:
Maple 18" N 35°E 29.9 ft.

10/7
SEE COR.
EST. NO.
53
(CJL 7/12/90)

At the corner of Section 25-26-35-36, T 10 S, R 7 W.

Notes:
Fir 30" N 20°E 5.14
Fir 30" S 80°E 1.02
Fir 40" S 1° W 1.64
Fir 15" N 89°W 1.81
Marked:
Fir 18" N 50°E 20.6 Ft.

Now:
rotten stump, no face left
" " " " "
" " " " "
Found: green, with face, 56"
Found: but no notes located
Fir faced, S 12° E, 50ft.
Fir faced S 50° W 156 ft.

BENTON COUNTY SURVEYORS OFFICE - CORNER RESTORATION


T 12 S, R 6 W, W. B. & M., BENTON COUNTY, OREGON

REPORTED BY BRUCE STARKER **1402**

SECTION 17

TITLE LAND SURVEYOR

DATE 26 April, 1955

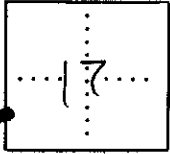

● OFFICIAL CORNER FOUND

○ CORNER SET

S 1/16 CORNER COMMON TO SEC. 17 & 18
IS 1 1/4" PIPE
DESCRIBE

ADDITIONAL INFORMATION

SEE THE T10S R7W FILE IN THE CORNER RESTORATION CORRESPONDENCE FILE DRAWER (CJL 7/17/90).

LEGIBLE MARKS ON BEARING OBJECTS

BARK SCRIBED
#310 1/4 BT

KIND FIR
SIZE 61"
BEARING N46°E
DISTANCE 63.8 FT.
BT TAG POSTED

OVER