

13-7-10

BENTON COUNTY SURVEYORS OFFICE - CORNER RESTORATION


2031

T. 13 S, R. 7 W, W. B. & M., BENTON COUNTY, OREGON

SECTION 15

The information shown hereon was taken from the referenced county survey. Date: 7/26/90

REPORTED BY Arnold Brubaker
TITLE Surveyor 992
DATE Feb. 19, 1976

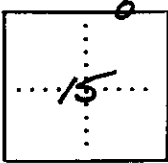

● OFFICIAL CORNER FOUND

○ CORNER SET

E 1/4 CORNER COMMON TO SEC. 10 & 15
IS 5/8" Iron Rod
DESCRIBE

LEGIBLE MARKS ON BEARING OBJECTS

XX

ADDITIONAL INFORMATION
Corner 70' North of E. of Creek.
5' dia. Snag N10°E 24'.

See C.S. #16037

KIND Maple
SIZE 3"
BEARING S46°W
DISTANCE 41.25'
BT TAG POSTED

OVER

OREGON CORNER RESTORATION FORM

Section 10 Township 13S Range 7W

County Benton Date 11/15/03

CORNER DESIGNATION

E 1/16 $\frac{10}{15}$

- Condition Report Only
- Not Found
- Renewed
- Unrecorded
- Surveyed In
- Referenced Out

Previous Renewals/Surveys, etc. CS # 6037


Monument(s) & Accessories Found: (Condition and Source)

5/8" Iron Rod 0.5 ft. above grade - CS # 6037

Rotten 5 ft. dia snag N14E 24.0 ft. to nail CS # 6037

Monument Detail

Sketch

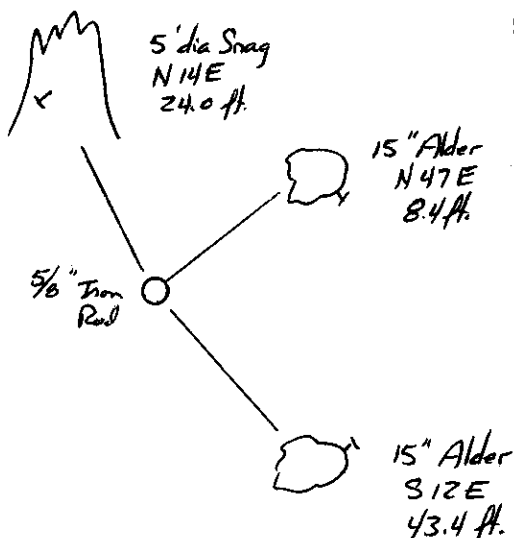

Monument Set (Procedures and Description)

New Accessories

15" Alder N47E 8.4 ft. to spike set side center
bank scribed "E 1/16 S10 BT" & tag

15" Alder S12E 43.4 ft. to spike set side center
bank scribed "E 1/16 S15 BT" & tag

Location & Comments

Surveyor's Seal

Compass Declination 20°E

Firm/Agency _____

D. Wellman Surveying
90686 Northrop Drive Address _____
Eugene, OR 97402

David Wellman Party Chief _____

Notes _____

Erin Heasterstone Witness _____

REGISTERED
PROFESSIONAL
LAND SURVEYOR

David H. Wellman
OREGON
JULY 1985
DAVID H. WELLMAN
2163

Renewal 6/30/04