

**138600340**

DATE 03/18/2021TOWNSHIP 13 SOUTH, RANGE 8 WEST, WILLAMETTE MERIDIAN; SECTION 23 CORNER EAST 1/4  
DONATION LAND CLAIM N/A CORNER N/A**COMMON CORNER(S):**

WEST 1/4 CORNER SECTION 24

**RECORDS (INFORMATION IN *BOLD ITALICS* IS COUNTY STAFFS' INTERPRETATION OF THE RECORD)**

BASED ON EXTENSIVE RESEARCH AND RECOVERY OF EVIDENCE, THIS OFFICE HAS DETERMINED THAT MOST GENERAL LAND OFFICE SURVEYORS IN BENTON COUNTY BEFORE 1890 MEASURED TO THE FACE OF BEARING TREES.

- [01] GENERAL LAND OFFICE (GLO) NOTES BY EDWARD F. SHARP, D.S., DATED SEPTEMBER 25, 1897. *SET AN ELDER POST 3 FEET LONG, 3" SQUARE, 24" IN THE GROUND, MARKED "1/4S" ON WEST FACE, FROM WHICH A DEAD FIR 48" DIA BEARS N39°W, 46 LINKS (30.36 FEET), MARKED "1/4SBT"; DEAD FIR 40" DIA BEARS S21°E, 68 LINKS (44.88 FEET), MARKED "1/4SBT".*
- [02] BUREAU OF LAND MANAGEMENT (BLM) NOTES BY JOSEPH S. GAWRON, CADASTRAL SURVEYOR, DATED NOVEMBER 16, 1960. *POINT FOR THE 1/4 SECTION CORNER AT PROPORTIONATE DISTANCE, THERE IS NO REMAINING EVIDENCE OF THE ORIGINAL CORNER. SET AN IRON POST, 28" LONG, 2-1/2" DIA, 24" IN THE GROUND, WITH BRASS CAP MARKED "1/4 S23 S24 T13S R8W 1960", FROM WHICH A FIR 12" DIA BEARS S57-1/2°E, 70 LINKS (46.20 FEET), MARKED "1/4 S24 BT"; FIR 14" DIA BEARS N44-1/2°W, 79 LINKS (52.14 FEET), MARKED "1/4 S23 BT".*
- [03] BUREAU OF LAND MANAGEMENT (BLM) NOTES BY FRANK A. TUERS AND ROBERT L. AARSETH, CADASTRAL SURVEYORS, DATED AUGUST 9, 1979. *THE 1/4 SECTION CORNER MONUMENTED WITH AN IRON POST, 2-1/2" DIA, FIRMLY SET, PROJECTING 18" ABOVE GROUND, WITH BRASS CAP MARKED "1/4 S23 S24 T13S R8W 1960", FROM WHICH A FIR 20" DIA (BLM BT) BEARS S57-1/2°E, 70 LINKS (46.20 FEET), WITH HEALED BLAZE; FIR 28" DIA BEARS N44-1/2°W, 79 LINKS (52.14 FEET), WITH HEALED BLAZE.*
- [04] BENTON COUNTY CORNER RESTORATION NO. 3377 (ON LANE COUNTY DEPARTMENT OF PUBLIC WORKS GOVERNMENT CORNER VISITATION FORM) BY M. HUNTER, FORESTER, DATED NOVEMBER 25, 1985. *BRASS CAP. TWO BEARING TREES WERE CUT AND CAPPED: A DOUG-FIR 28" DIA (BLM BT) BEARS N44-1/2°W, 52 FEET; DOUG-FIR 20" DIA (BLM BT) BEARS S57-1/2°E, 46 FEET.*

**FIRM/AGENCY:** BENTON COUNTY SURVEYOR'S OFFICE  
**ADDRESS:** 360 S.W. AVERY AVE., CORVALLIS, OR 97333; PH. 541-766-6821  
**RESEARCH BY:** DAVID L. MALONE, P.L.S.  
**DATA ENTRY BY:** SAME

### GOVERNMENT CORNER VISITATION

CORNER 1/4 Common to Secs. 23 + 24 T. 13S., R. 8W., W.M.

EVIDENCE BC

ACCESSORIES \_\_\_\_\_

NOTES AND OTHER INFORMATION Two BT's were cut and capped under the terms of the County Line Timber Sale, (TSO-066).

A Doug-fir, 28" DBH, N44 1/2° W 52'


A Doug-fir, 20" DBH, S57 1/2° E, 46'

BY: M. Hunter  
TITLE: Forester

FIRM: BZM Salem District  
DATE: 11/25/85

#### SKETCH

SECTION DIAGRAM GRID

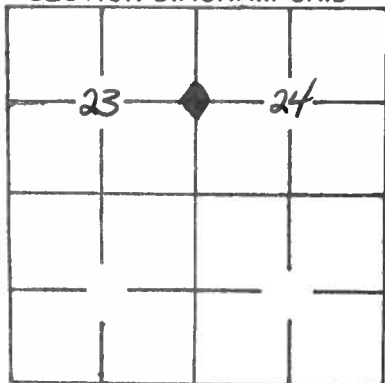

SEAL

