

CORNER FILE TRACKING

H:\Survey\Corners\Misc\Filetrac.doc

11/23/98

CORNER NUMBER
145500100

STEP	HISTORY(H1)	RESTORATION()
Form Prepared, DB	2/7/00	N/A
Field Inspection, DB	N/A	N/A
Form Checked, DB	2/7/00	N/A
Form Edited, DB	2/7/00	N/A
Form Signed, DB	N/A	N/A
Authorize Payment, DB	N/A	N/A
Archive Digital Files	2/8/00	-
Collect Documents	-	-
<i>ADD TO</i> Scanned	2/14/00	2/14/00
Copy For Filming	2/9/00	2/9/00
Filed, DB		
Finish index (count unit)		
Filmed (Archived), DB		

(DB) = Entry needed in database (Access).

COMMENTS:

2/9/00 READY TO ADD TO EXISTING FILE. THE FINISHED FILE SHOULD MATCH THIS BATCH OF HARD COPIES, EXCEPT FOR THE STICKY NOTES.

Corner to sections 2, 3, 34 and 35, Twp. 14 and 15 S., R. 5 W.

2197

Reestablishment by F. M. Wilkes

May 1909

Set 1" black pipe for corner, no trees near, pipe near fence.
Witness D. B. Farley

14-5
 34 | 35
 3 | 2
 15

CORNER HISTORY		T 14 S, R 5 W		SECTION 34 D.L.C.		CORNER SE CORNER		#
								500100
NO.	DATE	SOURCE	SURVEYOR	MONUMENTS AND ACCESSORIES		COMMENTS		
1	5/5/1853	ORIG. GLO	JAMES FREEMAN	SET POST @ 1 BT, MEAS. TO FALK + TRENCH				1
2	5/20/1909	CS#125 NOTES	F. MARION WILKES	SET 1" PIPE BY SINGLE PROP. (1 MI. W, 1/2 MI. E) FB 3/59				2 3
3	5/1909	OLD COR. REST. BK. NO. 1, Pg. 166	" " "	SET 1" PIPE				4 5
4	-	REST. 2197	-	TRANS. COPY OF REC [03] + MAY CONTAIN E+D				6 7
5	1910	CS#174 NOTES	W. C. GALLOWAY	1" PIPE, FB 5/51				8 9
6	"	CS#174 MAP	" "	"				10 11
7	-	MAP NO. 14-5-00026	BENTON COUNTY	"				12 13
8	-	MAP NO. 15-5-00001	" "	"				14 15
9	2/1919	MAP NO. 38-20-3	OP. ST. HWY. DEPT.	TIED, NO DESL.				16 17
10	12/1931	MAP NO. 48-6-8	" " " "	" " "				18 19
11	5/11/1944	MAP NO. 15-5-00002	W. C. GALLOWAY	" " "				20 21
12	6/8/1957	CS# 2975	RICHARD FALK	FND. 1" PIPE				22 23
13	12/1957	CS# 3012	WILLIAM C. THOMPSON	TIED, NO DESL.				24 25
14	10/5/1993	REST. 14550101A2	CURTIS J. LIENFELT	FND. + REF. 1" PIPE, DID NOT ACCEPT FOR THE COR.				26 27
15	7/1997	BEN. CO. GIS/MEA MAPPING PART.	RAY WILSON	FND. 1" PIPE, EST. ST. PLN. COORD. @ RTK/GPS				28 29
								30 31

Road fence down

Witness H. E. Wilbert.

Feb. 17, 1923.

1/4 sec. corner between secs. 9 & 10. T. 15-5
Set 1/2" galv. pipe also strap iron on North side and east iron 14" long
With hook, lying East with hook around pipe.

Gov. stumps check, as, Oak 20" N. 35° E. 1.64 chs.

" 20" N. 34° W. 1.29 "

Oak 12" marked C.S. BT. N. 31° 15' E. .684 "

" 12" " " " S. 77° 35' E. 1.013 "

To E. rail of R.R. N. 80° W. 1.312 "

Witness S. J. Galloway. Feb. 19, 1923.

C.S. 43
by F.M. Wilkes
May 1909

D.B. Farley witness

see page
48

Corner to sections 33 & 34 T. 14 S. R. 5 W. & 34 T 15-5.

Set 3"x4" heart oak stake

pipe on sec. line North 9.50 chs.

Corner to secs. 2, 3, 34 & 35 Tps. 14 & 15 S. R. 5 W.

Set 1" black pipe for cor. no trees near. pipe near fence.

1/4 sec. cor. between Secs. 2 & 3 T. 15-5

Set sand stone 16"x8"x8" At N. gate post at W. end of lane. 100' N. of W. end of barn.

Oak 12" in dia. bears S. 39° 30' W. .430 chs.

Ash 9" " " " N. 19° W. 4.493 "

(These marks
may be for
at ...)

C.S. 2-93
Road Survey

S.E. corner of Lewis Morris D.L.C. 70 T 10-4.

30 feet

Corner to sections 2, 3, 34 and 35, Twp. 14 and 15 S., R. 5 W.

Reestablishment by F. M. Wilkes

May 1909

2197

Set 1" black pipe for corner, no trees near, pipe near fence.
Witness D. B. Farley

TOWNSHIP 14 SOUTH, RANGE 5 WEST, WILLAMETTE MERIDIAN; SECTION 34 CORNER
DONATION LAND CLAIM _____ CORNER _____**COMMON CORNER(S):****UPDATES AND REVISIONS:****CORNER RECORDS (PREVIOUS ORIGINAL SURVEYS, ETC.)**

- [01] ORIGINAL GLO SURVEY BY JAMES FREEMAN DATED MAY 5, 1853.
- [02] COUNTY SURVEY NO. 125 BY F.M. WILKES DATED MAY 20, 1909 (FIELD BOOK NO. 3, PAGE 59).
- [03] OLD CORNER RESTORATION BOOK NO. 1 PAGE 166 BY F.M. WILKES DATED MAY OF 1909.
- [04] CORNER RESTORATION NO. 2197 BY F.M. WILKES DATED MAY OF 1909.
- [05] COUNTY SURVEY NO. 174 BY BENTON COUNTY SURVEYOR'S OFFICE DATED IN 1910.
- [06] MAP NO. 14-5-00026 BY BENTON COUNTY SURVEYOR'S OFFICE (NO DATED GIVEN).
- [07] MAP NO. 15-5-00001 BY BENTON COUNTY SURVEYOR'S OFFICE (NO DATED GIVEN).
- [08] O.S.H.D. MAP NO. 3B-20-3 BY OREGON STATE HIGHWAY DEPARTMENT DATED FEBRUARY OF 1919.
- [09] O.S.H.D. MAP NO. 4B-6-8 BY OREGON STATE HIGHWAY DEPARTMENT DATED DECEMBER OF 1931.
- [10] MAP NO. 15-5-00002 BY W.C. GALLOWAY DATED MAY 11, 1944.
- [11] COUNTY SURVEY NO. 2975 BY RICHARD FAIL DATED JUNE 8, 1957.
- [12] COUNTY SURVEY NO. 3012 BY WILLIAM C. THOMSON DATED DECEMBER OF 1957.

COMMENTS/LOCATION/ETC:

THE PURPOSE OF RESTORATION NO. 145500100R2 IS TO PERPETUATE THE POSITION CURRENTLY MONUMENTED WITH A 1" INSIDE DIAMETER IRON PIPE. SAID POSITION WAS APPARENTLY ESTABLISHED BY SINGLE PROPORTIONATE MEASUREMENT IN RECORD [02]. UNTIL THE PROPORTIONATE POSITION CAN BE VERIFIED, SAID PIPE SHOULD NOT BE IDENTIFIED AS THE SECTION CORNER.

RECORD [04] IS A TRANSCRIBED COPY OF RECORD [03] AND MAY CONTAIN ERRORS AND OMISSIONS.

NOTES:

THIS IS A MICROSOFT WORD (VERSION 5.0) DOCUMENT NAMED "45500100" CREATED FROM A BOILER PLATE DOCUMENT NAMED "HISTORY", WHICH HAS A STYLESHEET NAMED "CORNER" ATTACHED TO IT.

FIRM/AGENCY: BENTON COUNTY SURVEYOR'S OFFICE
ADDRESS: 360 S.W. AVERY AVE. CORVALLIS OR 97333; PH. 757-6821
RESEARCH BY: CURTIS J. LIESENFELT/MARK E. ANDERSON
DATA ENTRY BY: COLETTE MONACO

BENTON COUNTY CORNER RESTORATION FORM, PAGE 1 OF 1, 145500100R2

SEE CORNER HISTORY FORM FOR RECORDS ETC.

CORNER RESTORATION FIELD BOOK NUMBER 14 PAGE(S) 56 DATE 10/05/1993
TOWNSHIP 14 SOUTH, RANGE 1 WEST, WILLAMETTE MERIDIAN; SECTION 34 CORNER
DONATION LAND CLAIM _____ CORNER _____
CONDITION REPORT _____; REFERENCED OUT XX; RENEWED _____; SURVEYED IN _____

LOCATION AND COMMENTS:

THIS POSITION IS LOCATED 5 FEET NORTHERLY AT RIGHT ANGLES TO A CULTIVATED FARM FIELD, 187 FEET SOUTHERLY FROM THE HOUSE AT 24425 HWY 99W AND 162 FEET EASTERLY FROM WOODEN POWER POLE NO. 039901.

MONUMENTS AND ACCESSORIES FOUND (CONDITION AND SOURCE):

FOUND: 1" INSIDE DIAMETER IRON PIPE, 6" BELOW GROUND SURFACE FOR THE POSITION.

NO OTHER RECORD EVIDENCE WAS RECOVERED.

MONUMENT SET (PROCEDURES AND DESCRIPTION):

USED THE RECOVERED 1" PIPE FOR THE MONUMENT. THE PURPOSE OF THIS RESTORATION IS TO PERPETUATE THIS POSITION WHICH WAS APPARENTLY ESTABLISHED FOR THE SOUTHEAST CORNER OF SECTION 34.

NEW ACCESSORIES:

SET: REBAR (SEE NOTES), 6" BELOW GROUND SURFACE, BEARS N 45° 30' E 29.99 FEET.


SET: REBAR (SEE NOTES), 8" BELOW GROUND SURFACE, BEARS N 44° W 28.79 FEET.

SET: ORANGE FIBERGLASS "SURVEY MARKER" POST 1 FOOT NORTHERLY.

NO BRASS
CAP
WAS SET



SKETCH

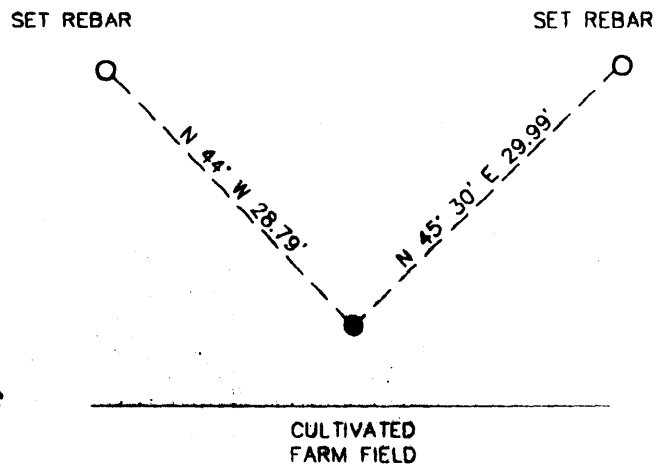

NOTES:

COMPASS DECLINATION IS 20° EAST. ALL MEASURED DISTANCES AND COMPASS BEARINGS ARE TO THE CENTER OF THE OBJECT, UNLESS OTHERWISE NOTED. ALL BEARING TREES ARE PAINTED AND HAVE A B.T. TAG ATTACHED, FACING THE CORNER UNLESS OTHERWISE NOTED. ALL NEW BEARING TREES HAVE A BRASS WASHER (STAMPED "BENTON COUNTY SURVEYOR") ATTACHED TO A SIDE CENTER UNLESS OTHERWISE NOTED. ALL LIVE BEARING TREES HAVE A PLASTIC WASHER (STAMPED "BENTON COUNTY SURVEYOR CORNER RESTORATION") ATTACHED TO THE BACK OF THE TREE OPPOSITE THE CORNER UNLESS OTHERWISE NOTED. ALL SET REBAR ARE 5/8" X 30" AND HAVE A YELLOW PLASTIC CAP (STAMPED "BENTON COUNTY SURVEYOR") ATTACHED TO THE TOP.

THIS DOCUMENT WAS NAMED AND CREATED IN A MANNER SIMILAR TO THE HISTORY FORM. THE NAME OF THE BOILER PLATE IS "MONUMENT". THE BORDER, STAMP AND SKETCH ARE FROM AUTOCAD RELEASE 12.

THIS RESTORATION WAS PERFORMED AT THE DIRECTION AND APPROVAL OF THE BENTON COUNTY/DEPUTY COUNTY SURVEYOR. 

FIRM/AGENCY: BENTON COUNTY SURVEYOR'S OFFICE
ADDRESS: 360 S.W. AVERY AVE. CORVALLIS OR 97333; PH. 757-6821
SURVEYOR: CURTIS J. LIESENFELT
SURVEY CREW: MARK E. ANDERSON

REGISTERED
PROFESSIONAL
LAND SURVEYOR
Curtis J. Liesenfelt
OREGON
JULY 17, 1986
CURTIS J. LIESENFELT
2213
LICENSE EXPIRES 12/31/1994

DATE 02/07/2000TOWNSHIP 14 SOUTH, RANGE 05 WEST, WILLAMETTE MERIDIAN; SECTION 34 CORNER SOUTHEAST
DONATION LAND CLAIM N/A CORNER _____**COMMON CORNER(S):**

THE SOUTHWEST CORNER OF SECTION 35.

THE NORTHWEST CORNER OF SECTION 2 IN TOWNSHIP 15 SOUTH, RANGE 5 WEST.

THE NORTHEAST CORNER OF SECTION 3 IN TOWNSHIP 15 SOUTH, RANGE 5 WEST.

RECORDS (INFORMATION IN BOLD ITALICS IS COUNTY STAFFS' INTERPRETATION OF THE RECORD)

- [01] ORIGINAL GLO SURVEY BY JAMES FREEMAN, D.S., DATED MAY 5, 1853. *SET A POST WITH 1 BEARING TREE, MEASURED TO THE FACE AND A TRENCH.*
- [02] COUNTY SURVEY NO. 125 NOTES (FIELD BOOK NO. 3, PAGE 59) BY F. MARION WILKES, C.S., DATED MAY 20, 1909. *SET 1" PIPE. SEE COMMENTS FOR MORE INFORMATION.*
- [03] OLD CORNER RESTORATION BOOK NO. 1, PAGE 166, BY F. MARION WILKES, DATED MAY, 1909. *SET 1" PIPE.*
- [04] CORNER RESTORATION NO. 2197. *THIS IS A TRANSCRIBED COPY OF RECORD [03] AND MAY CONTAIN ERRORS AND OMISSIONS.*
- [05] COUNTY SURVEY NO. 174 NOTES (FIELD BOOK NO. 5, PAGE 51) BY W. C. GALLOWAY, C.S., DATED 1910. *1" PIPE.*
- [06] COUNTY SURVEY NO. 174 MAP, BY W. C. GALLOWAY, DATED 1910. *1" PIPE.*
- [07] MAP NO. 14-5-00026 BY BENTON COUNTY, NO DATE GIVEN. *1" PIPE.*
- [08] MAP NO. 15-5-00001 BY BENTON COUNTY, NO DATE GIVEN. *1" PIPE.*
- [09] MAP NO. 3B-20-3 BY THE OREGON STATE HIGHWAY DEPARTMENT, DATED FEBRUARY, 1919. *TIED, NOT DESCRIBED.*
- [10] MAP NO. 4B-6-8 BY THE OREGON STATE HIGHWAY DEPARTMENT, DATED DECEMBER, 1931. *TIED, NOT DESCRIBED.*
- [11] MAP NO. 15-5-00002 BY W. C. GALLOWAY, DATED MAY 11, 1944. *TIED, NOT DESCRIBED.*
- [12] COUNTY SURVEY NO. 2975 BY RICHARD FAIL, P.L.S., DATED JUNE 8, 1957. *FOUND 1" PIPE.*
- [13] COUNTY SURVEY NO. 3012 BY WILLIAM C. THOMSON, P.L.S., DATED DECEMBER, 1957. *TIED, NO DESCRIPTION.*
- [14] CORNER RESTORATION NO. 145500100R2, BY CURTIS J. LIESENFELT, P.L.S., DATED OCTOBER 5, 1993. *FOUND AND REFERENCED 1" PIPE. SEE COMMENTS FOR MORE INFORMATION.*
- [15] BENTON COUNTY GIS/DEA MAPPING PROJECT, BY RAY WILSON, D.C.S., DATED JULY, 1997. *FOUND 1" PIPE, ESTABLISHED STATE PLANE COORDINATES WITH RTK/GPS CONTROL.*

COMMENTS/LOCATION/ETC:

THE SURVEYOR OF RECORD [02] ESTABLISHED THE PIPE BY SINGLE PROPORTIONATE MEASUREMENT, USING CONTROL 1 MILE WEST AND 1/2 MILE EAST.

RECORD [14] DID NOT ACCEPT THE PIPE FOR THE CORNER BECAUSE THERE HAD BEEN NO INDEPENDENT VERIFICATION THAT THE PROPORTIONING WAS DONE CORRECTLY.

NOTES:

THIS IS A MICROSOFT WORD 97 DOCUMENT NAMED "45500100" CREATED FROM A BOILER PLATE DOCUMENT NAMED "HISTORY", WHICH HAS A STYLESHEET NAMED "CORNER" ATTACHED TO IT.

FIRM/AGENCY: BENTON COUNTY SURVEYOR'S OFFICE
ADDRESS: 360 S.W. AVERY AVE. CORVALLIS OR 97333; PH. 766-6821
RESEARCH BY: CURTIS J. LIESENFELT, P.L.S.
DATA ENTRY BY: SAME