

157640600

CORNER HISTORY		T 15 S, R 7 W		SECTION 1 D.L.C.	CORNER 5 1/4 CORNER	# 640600
NO.	DATE	SOURCE	SURVEYOR	MONUMENTS AND ACCESSORIES	COMMENTS	
1	7/18/1898	GLO	EDWARD F. SHARP	SET YEW STAKE 2 BT'S	YEW STAKE MARKED	2
2	5/5/1942	GLO	NORMAN O. PRICE OSKAR T. DAVENBERG	FOUND YEW STAKE, 2 BT'S, SET BC	BURIED YEW STAKE	3
						4
						5
						6
7-DBR  
5-AZ

NO CS  
NO CR  
NO HC

## CORNER FILE TRACKING

F:\Survey\Corners\Misc\Filetrac.doc

8/1/97

157640600

STEP	HISTORY	RESTORATION
FORM PREPARED	✓	✓
FORM CHECKED	✓	✓
FORM EDITED	✓	✓
FORM SIGNED	—	✓
ARCHIVE DIGITAL FILES	8/13/97	8/13/97
COLLECT DOCUMENTS	✓	✓
COPY FOR FILMING	✓	✓
FILMED	8/19/97	8/19/97
SCANNED		
INDEXED		
UPDATE DATABASE		
FILED		

NOTE: COULD NOT FIND 57640600.DOC

DATE 6/11/96

TOWNSHIP 15 SOUTH, RANGE 7 WEST, WILLAMETTE MERIDIAN; SECTION 1 CORNER S 1/4  
DONATION LAND CLAIM \_\_\_\_\_ CORNER \_\_\_\_\_

**COMMON CORNER(S):**

THE NORTH QUARTER CORNER OF SECTION 12.

**UPDATES AND REVISIONS:**

**CORNER RECORDS (PREVIOUS RENEWALS, SURVEYS, ETC.)**

- [01] ORIGINAL GLO SURVEY BY EDWARD F. SHARP DATED JULY 18, 1898. *SET YEW STAKE WITH 2 BEARING TREES.*
- [02] GLO SURVEY BY NORMAN D. PRICE AND OSKAR T. DAUELSBERG DATED MAY 5, 1942. *FOUND YEW STAKE, 2 BEARING TREES, SET BRASS CAP. BURIED YEW STAKE.*

**COMMENTS/LOCATION/ETC:**

**NOTES:**

THIS IS A MICROSOFT WORD (VERSION 5.0) DOCUMENT NAMED "57640600" CREATED FROM A BOILER PLATE DOCUMENT NAMED "HISTORY", WHICH HAS A STYLESHEET NAMED "CORNER" ATTACHED TO IT.  
INFORMATION IN BOLD ITALICS IS COUNTY STAFFS' INTERPRETATION OF THE RECORD.

**FIRM/AGENCY:** BENTON COUNTY SURVEYOR'S OFFICE  
**ADDRESS:** 360 S.W. AVERY AVE. CORVALLIS OR 97333; PH. 757-6821  
**RESEARCH BY:** CURTIS J. LIESENFELT/MARK E. ANDERSON  
**DATA ENTRY BY:** ROSE LINDGREN

SEE CORNER HISTORY FORM FOR RECORDS ETC.

CORNER RESTORATION FIELD BOOK NUMBER 16 PAGE(S) 41 DATE 6/6/1996  
 TOWNSHIP 15 SOUTH, RANGE 7 WEST, WILLAMETTE MERIDIAN; SECTION 1 CORNER S 1/4  
 DONATION LAND CLAIM \_\_\_\_\_ CORNER \_\_\_\_\_  
 CONDITION REPORT \_\_\_\_\_; REFERENCED OUT \_\_\_\_\_; RENEWED XX; SURVEYED IN \_\_\_\_\_

**LOCATION AND COMMENTS:**

THE CORNER IS LOCATED ON A HEAVILY WOODED, MODERATELY SLOPING, SOUTHWESTERLY FACING RIDGE APPROXIMATELY 100 FEET SOUTHWESTERLY FROM AN OLD LOG ROAD ACCESSIBLE WITH SMALL OFF ROAD VEHICLES. TO REACH FOLLOW THE LOGGING ROADS AS SHOWN ON THE GLENBROOK QUADRANGLE MAP. THIS CORNER IS UNSUITABLE FOR PRE-MARKING AND GPS CONTROL.

**MONUMENTS AND ACCESSORIES FOUND (CONDITION AND SOURCE):**



FOUND: GLO BRASS CAP MONUMENT WITH THE TOP 2 FEET BENT SOUTHWESTERLY FOR THE CORNER. THE BRASS CAP WAS STAMPED "1/4 S1 S12 1940" (IRON POST WITH BRASS CAP AS PER RECORD [02]).  
 FOUND: 3" X 4" X 10" PIECE OF YEW NEAR THE BASE OF SAID GLO MONUMENT (3" X 3" X 36" YEW POST AS PER RECORD [01], BURIED AT BASE AS PER RECORD [02]).  
 FOUND: MOSTLY ROTTED 22" D. FIR STUMP BEARS N 42° 25' W 40.8 FEET (12", N 42° W 40.26 FEET, FACE MEASUREMENT AS PER RECORD [01], 22" AS PER RECORD [02]). SET A BEARING TREE TAG ON TOP OF SAID STUMP.  
 NO OTHER RECORD EVIDENCE WAS RECOVERED.

**MONUMENT SET (PROCEDURES AND DESCRIPTION):**

SET: 2" INSIDE DIAMETER X 36" LONG IRON PIPE WITH A 3 1/4" BENTON COUNTY BRASS CAP, STAMPED AS SHOWN, IN THE SAME HORIZONTAL POSITION AS THE RECOVERED STRAIGHT BASE OF SAID GLO MONUMENT, BURIED SAID PIECE OF YEW AND GLO MONUMENT AROUND THE BASE OF THE 2" PIPE.

**NEW ACCESSORIES:**

SET: 5/8" REBAR (SEE NOTES), BEARS N 15° 00' E 15.92 FEET.  
 18" D. FIR BEARS S 62° 20' E 26.70', FACED AND SCRIBED "1/4 S12 BT". SET A 5 1/2" SPIKE AND BRASS WASHER IN NORTHERLY BASE.  
 SET: 5/8" REBAR (SEE NOTES). BEARS S 31° 25' E 25.05 FEET.  
 18" D. FIR BEARS S 70° W 4.68', FACED AND SCRIBED "1/4 S 12 BT". SET A 5 1/2" SPIKE AND BRASS WASHER IN SOUTHERLY BASE.  
 SET: 5/8" REBAR (SEE NOTES), BEARS N 67° 55' W 23.65 FEET.  
 SET: ORANGE FIBERGLASS "SURVEY MARKER" POST 1 FOOT SOUTHWESTERLY.  
 SET: LOCATION TAG ON THE 6" TRUNK OF TRIPLE ALDER ON THE NORTHWESTERLY SIDE OF AN OLD LOGGING ROAD, THE CORNER BEARS S 60° W 103 FEET.

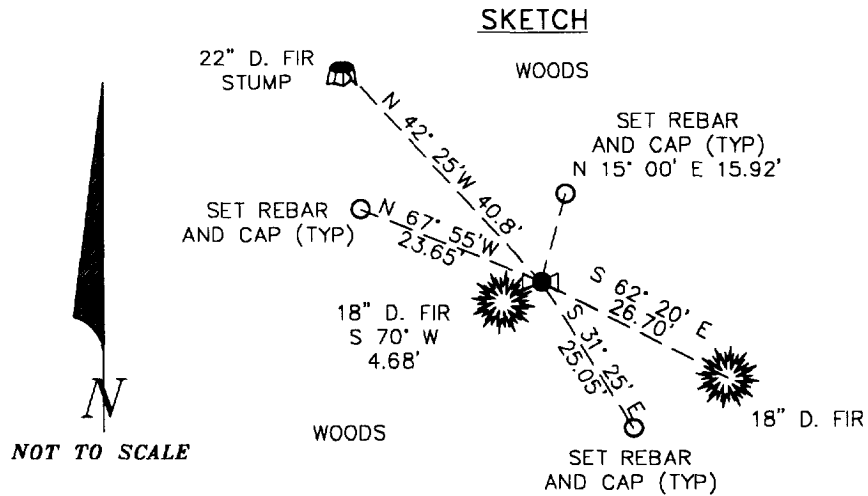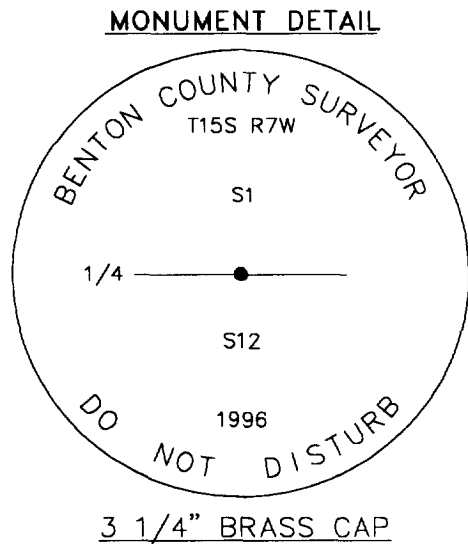

**NOTES:**

COMPASS DECLINATION IS 20° EAST. ALL MEASURED DISTANCES AND COMPASS BEARINGS ARE TO THE CENTER OF THE OBJECT, UNLESS OTHERWISE NOTED. ALL BEARING TREES ARE PAINTED AND HAVE A B.T. TAG ATTACHED, FACING THE CORNER UNLESS OTHERWISE NOTED. ALL NEW BEARING TREES HAVE A BRASS WASHER (STAMPED "BENTON COUNTY SURVEYOR") ATTACHED TO A SIDE CENTER UNLESS OTHERWISE NOTED. ALL LIVE BEARING TREES HAVE A PLASTIC WASHER (STAMPED "BENTON COUNTY SURVEYOR CORNER RESTORATION") ATTACHED TO THE BACK OF THE TREE OPPOSITE THE CORNER UNLESS OTHERWISE NOTED. ALL SET REBAR ARE 5/8" X 30" AND HAVE A YELLOW PLASTIC CAP (STAMPED "BENTON COUNTY SURVEYOR") ATTACHED TO THE TOP.

THIS DOCUMENT WAS NAMED AND CREATED IN A MANNER SIMILAR TO THE HISTORY FORM. THE NAME OF THE BOILER PLATE IS "MONUMENT". THE BORDER, STAMP AND SKETCH ARE FROM AUTOCAD RELEASE 12.

THIS RESTORATION WAS PERFORMED AT THE DIRECTION AND APPROVAL OF THE BENTON COUNTY/DEPUTY COUNTY SURVEYOR. RW

**FIRM/AGENCY:** BENTON COUNTY SURVEYOR'S OFFICE  
**ADDRESS:** 360 S.W. AVERY AVE. CORVALLIS OR 97333; PH. 757-6821  
**SURVEYOR:** CURTIS J. LIESENFELT  
**SURVEY CREW:** MARK E. ANDERSON  
**WITNESS(ES):**

REGISTERED  
 PROFESSIONAL  
 LAND SURVEYOR

*Curtis J. Liesenfelt*

OREGON  
 JULY 17, 1986  
 CURTIS J. LIESENFELT  
 2213

LICENSE RENEWAL 12/31/1996