


COUNTY SURVEY No 277

SCALE 1"=100'

W.C. Galloway CS
Feb. 1943

10-3
SW 31
/4
00002

Close Line
Sine 130.88

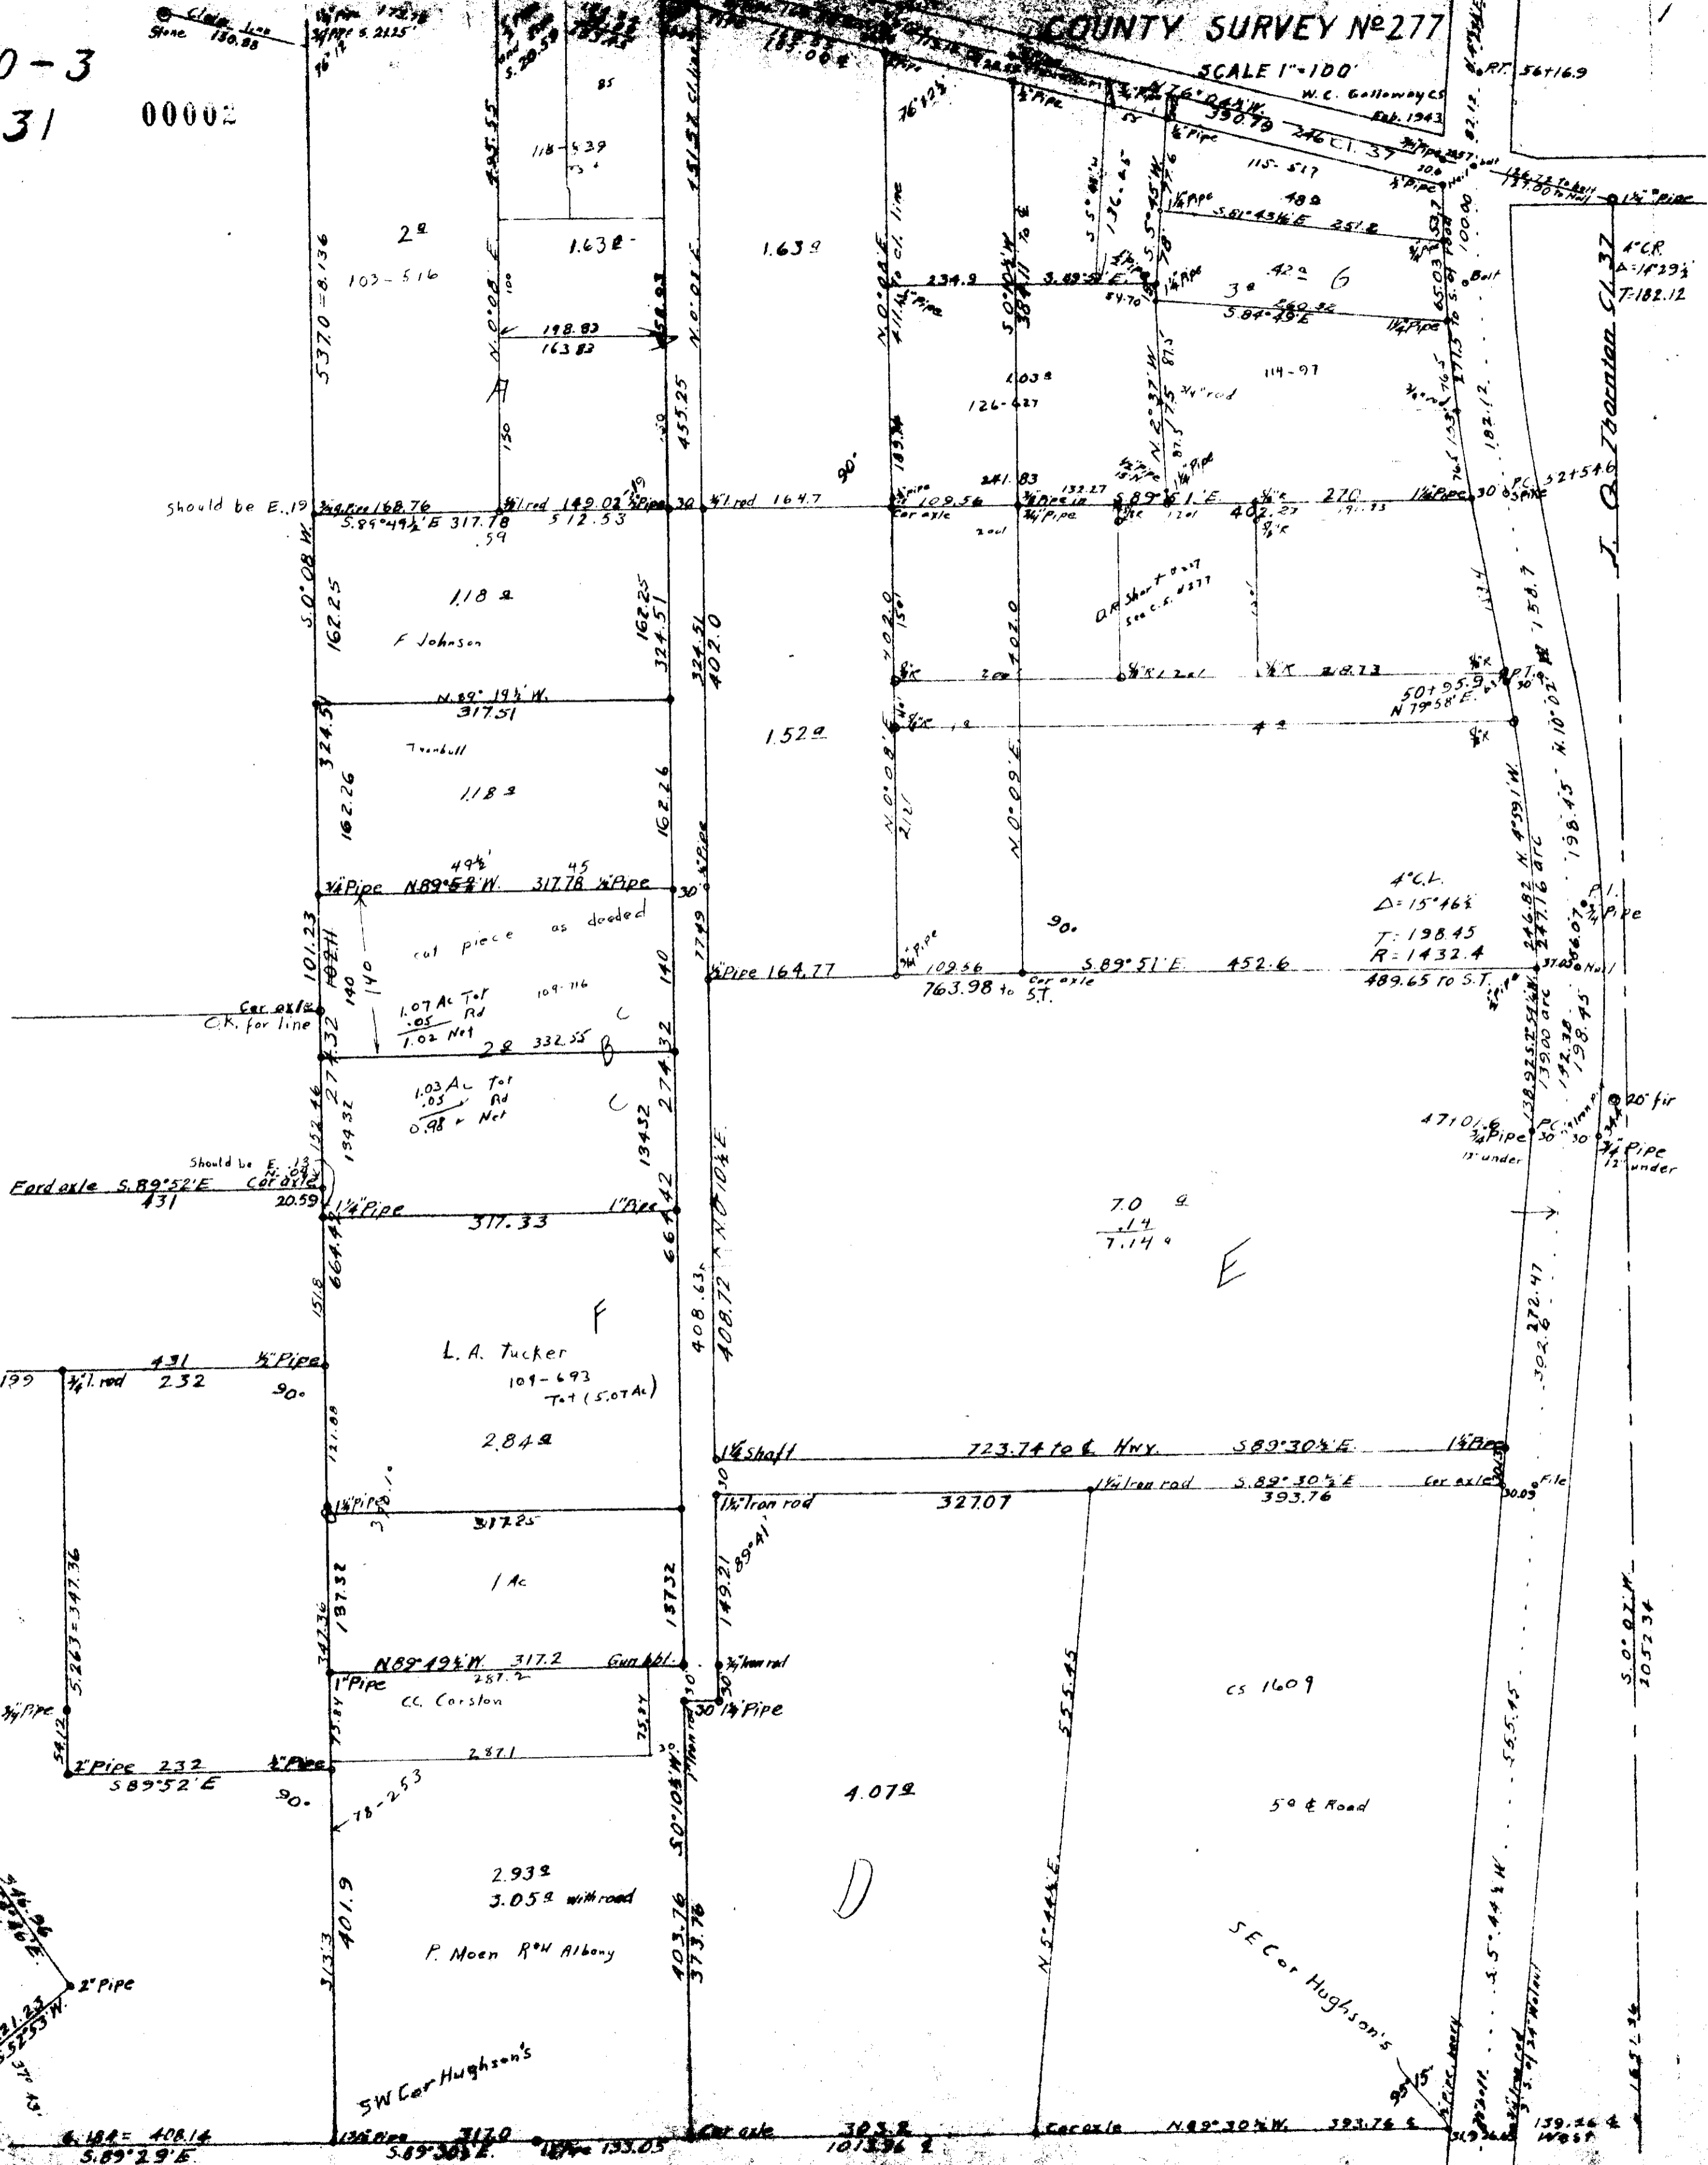

2" Pipe
5.55' 0.06
S. 52° 55' 31"
221.23
2" Pipe
377.45

6.182 = 408.14
S. 89° 29' E

7.0
.14
7.14

E

1" CR
Δ = 1429 1/2
7-182.12

PC 52+54.6
50' 55.9
N 79° 58' E

4" CL
Δ = 15' 16 1/2
T = 198.45
R = 1432.4

20' fir
17' under
1/4" Pipe
12' under

5.0' 0.21 M
1057.34