

10-3
31


00004

COUNTY SURVEY N^o277

SCALE 1" = 100'

W.C. Galloway C.S.
Dec. 31, 1942.

28° C.R.
Δ = 86°
T = 190.83

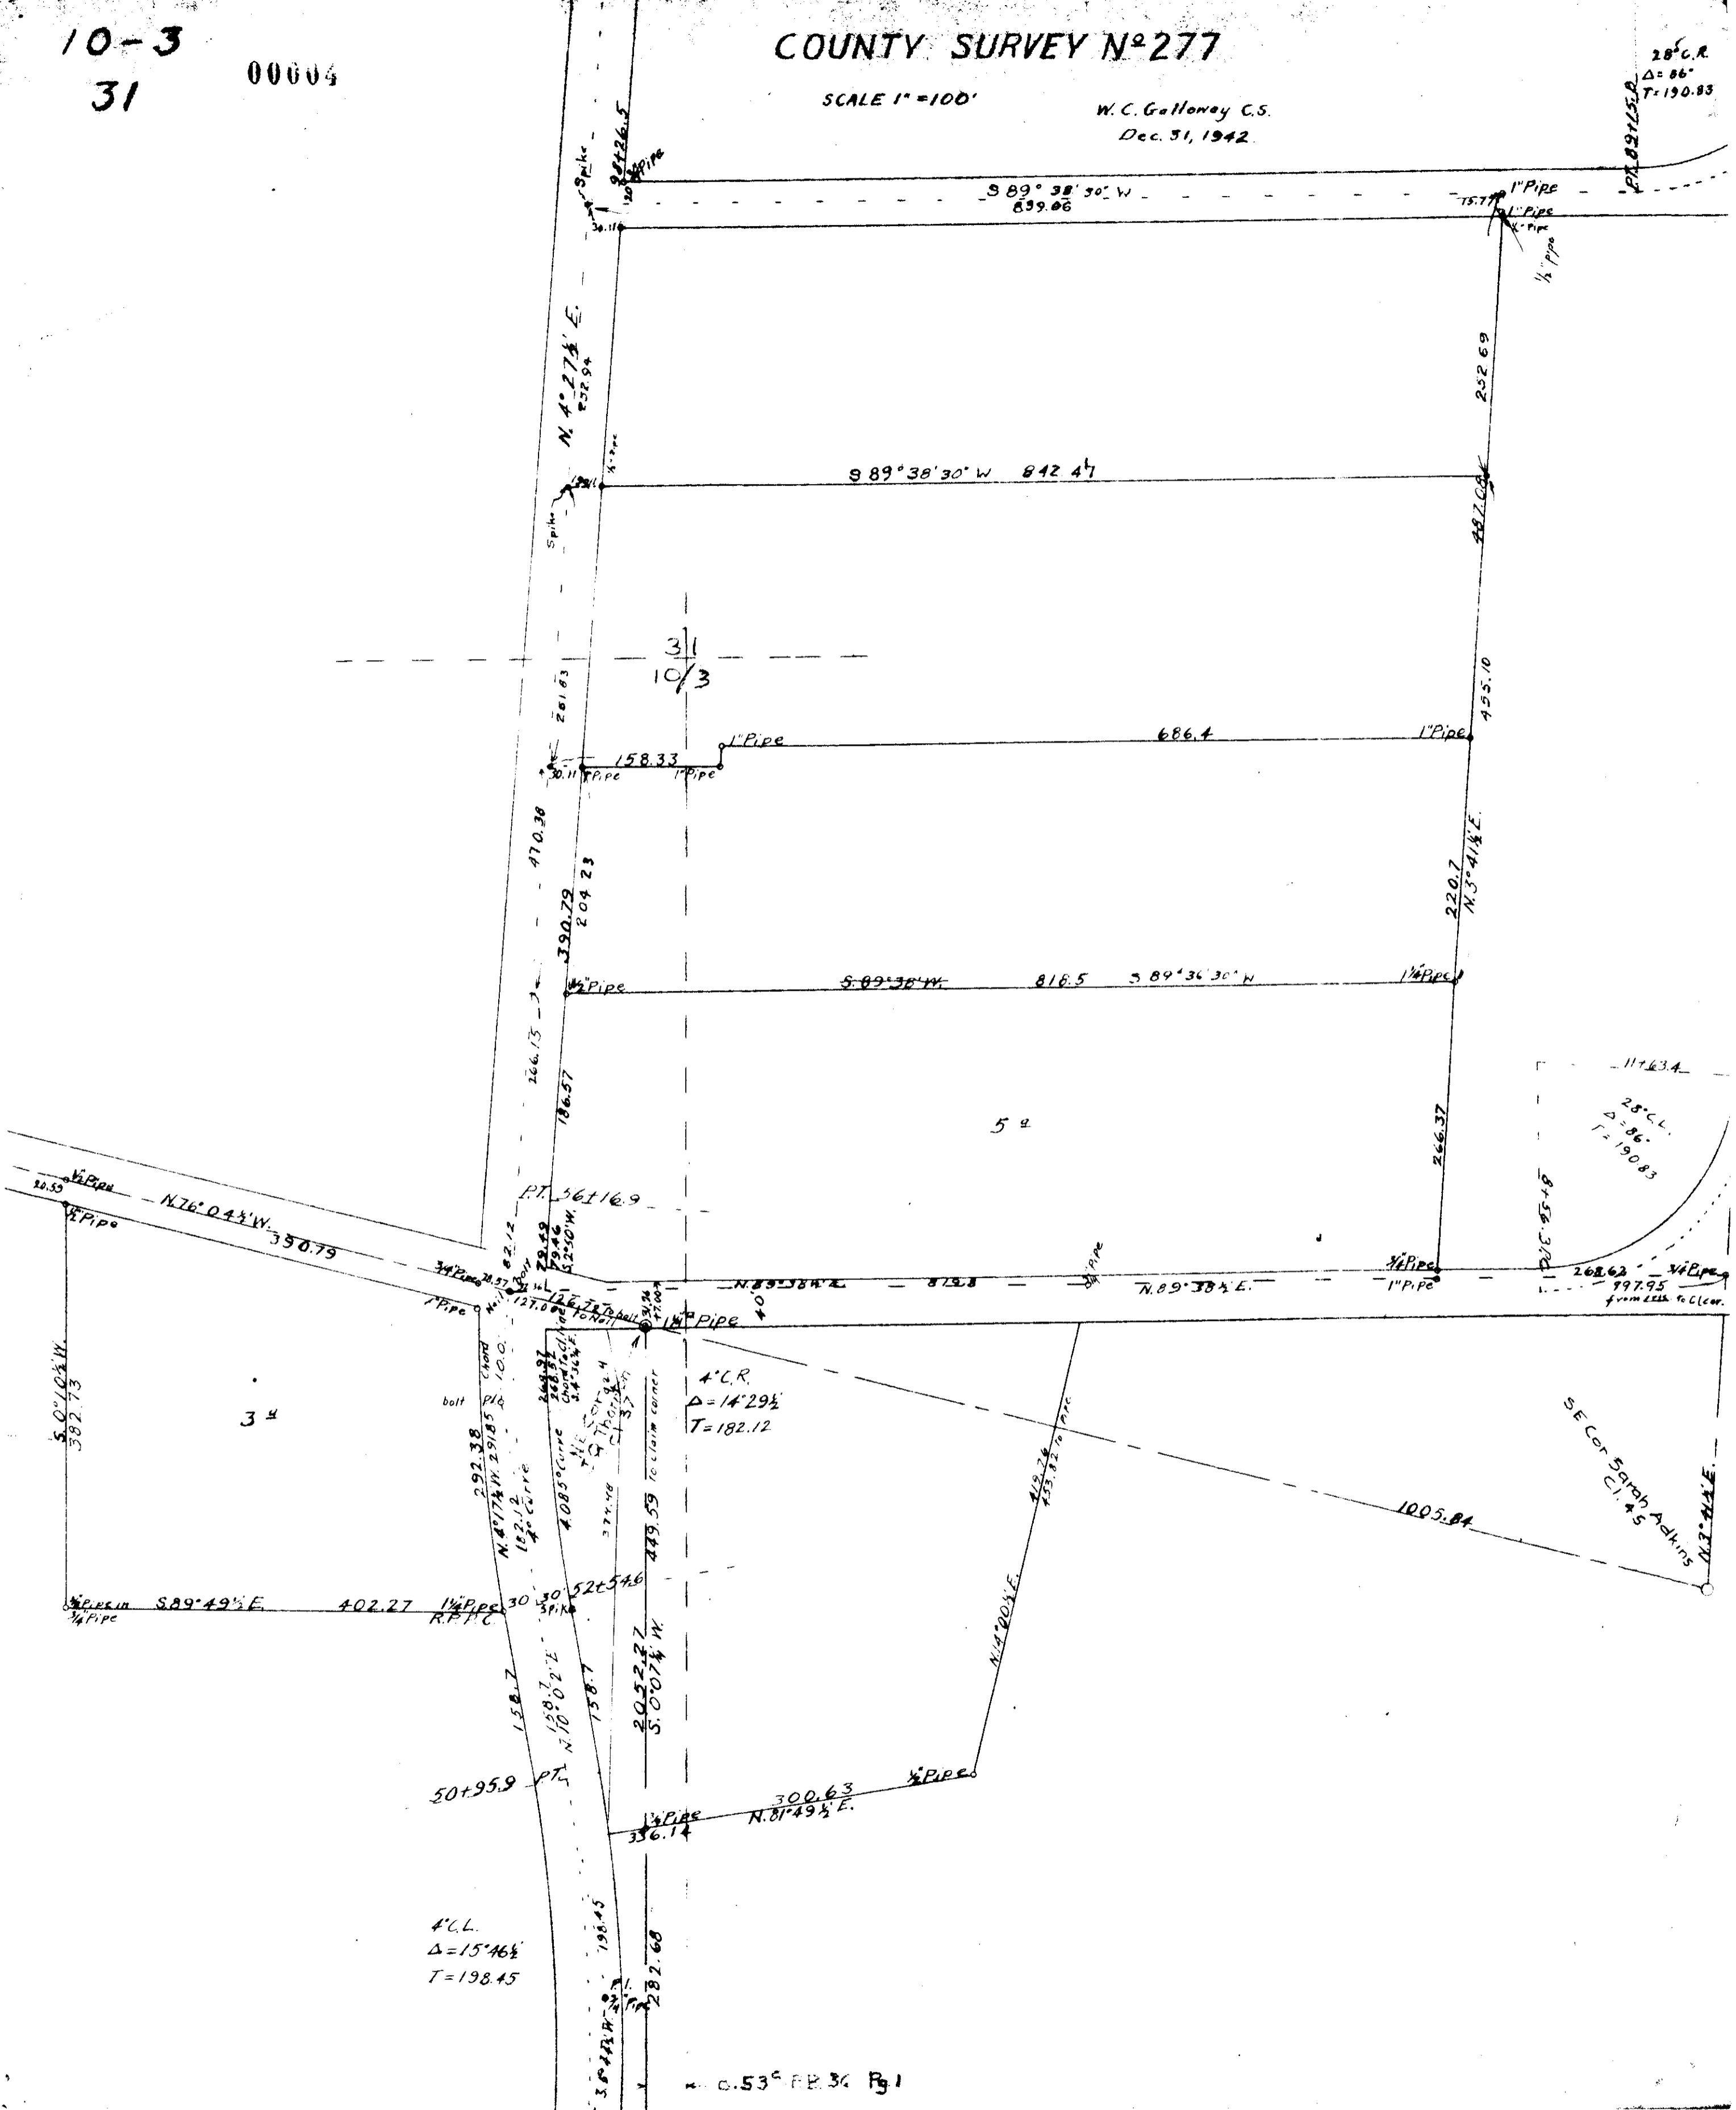

4° C.L.
Δ = 15° 46 1/2
T = 198.45

0.53° FB. 30 Pg 1