

30

10-3
10-3-0006


COUNTY SURVEY 266

In Sec. 30 T.10 S. R.3 W. W.M.

Scale 1"=80ft.

W.C. Ralloway C.S.
Dec. 7, 1917.

Made for
O.M. Leeper
P. P. Jarvis,
C. G. Layton

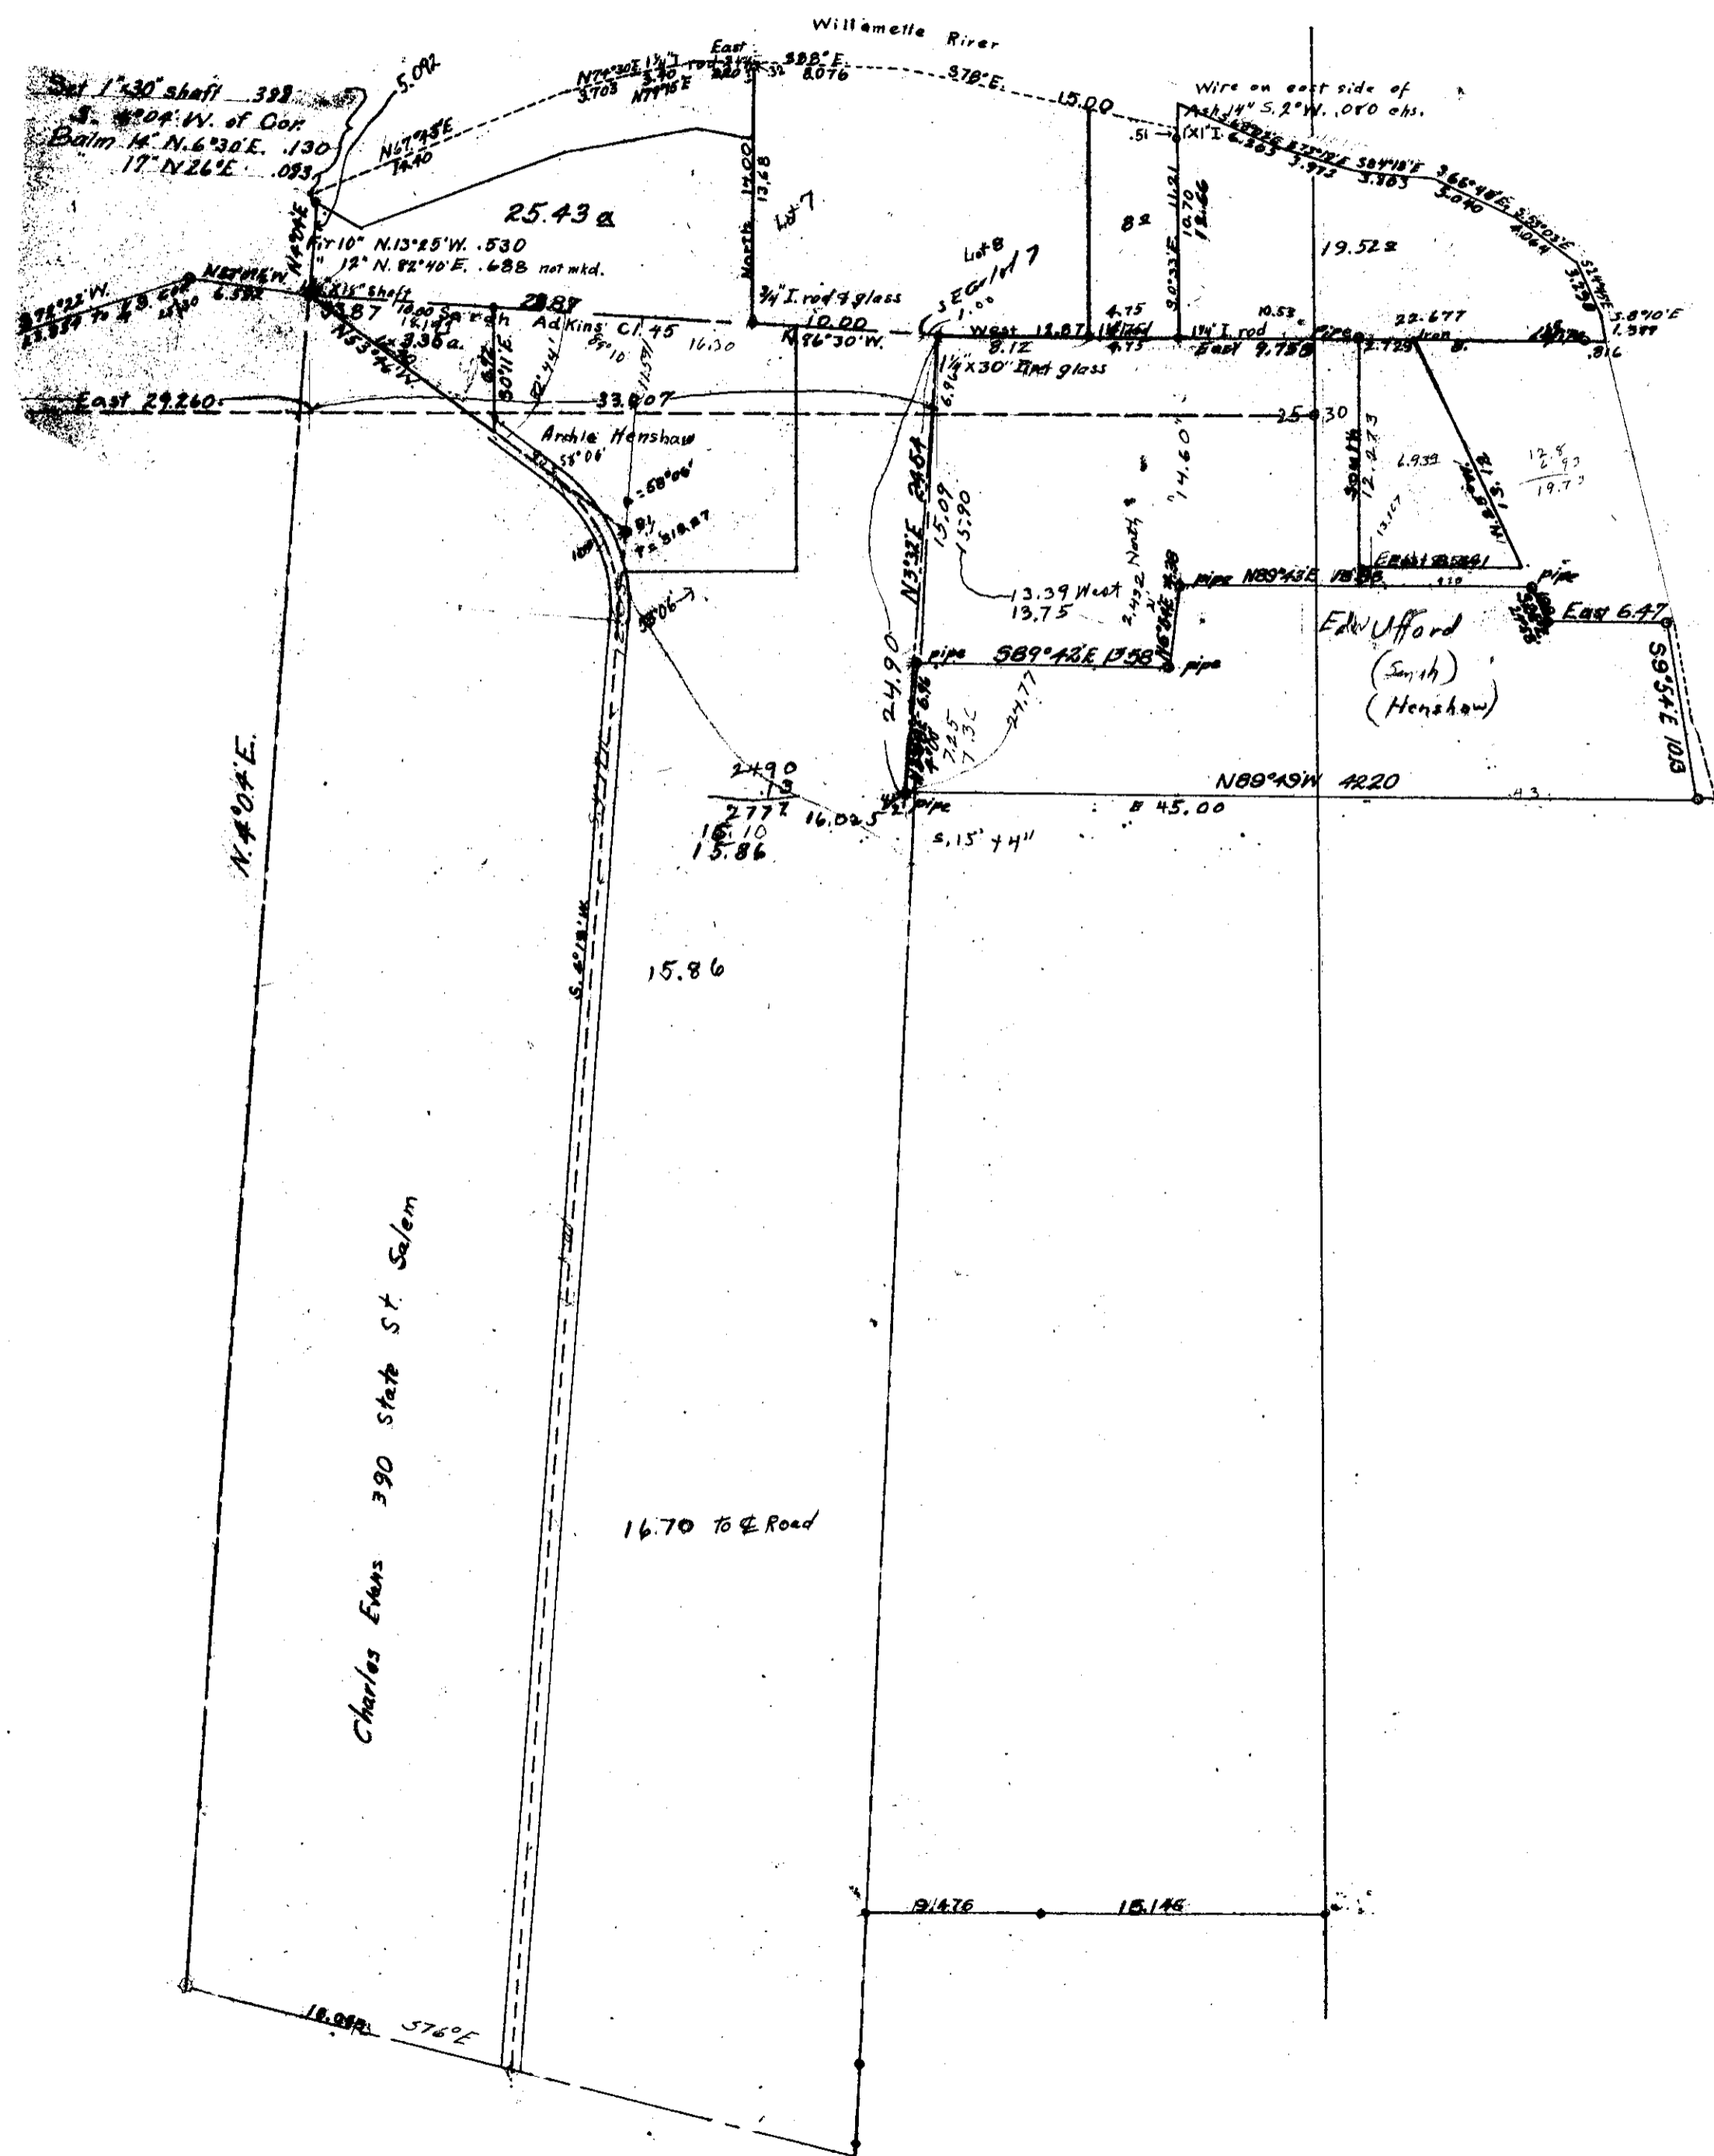

N. 25° W
1500