

10-4
25-36

00014


COUNTY SURVEY No. 163

T. 10 S., R. 3 & 4 W.

Scale 1 in. = 5 chs

Mar 8, 1921
W. C. Galloway C.S.

1/4 Cor on E Sec 25
Marion 1840
Ash 6" 5200 W
" 11 N 57° 10' W 1840

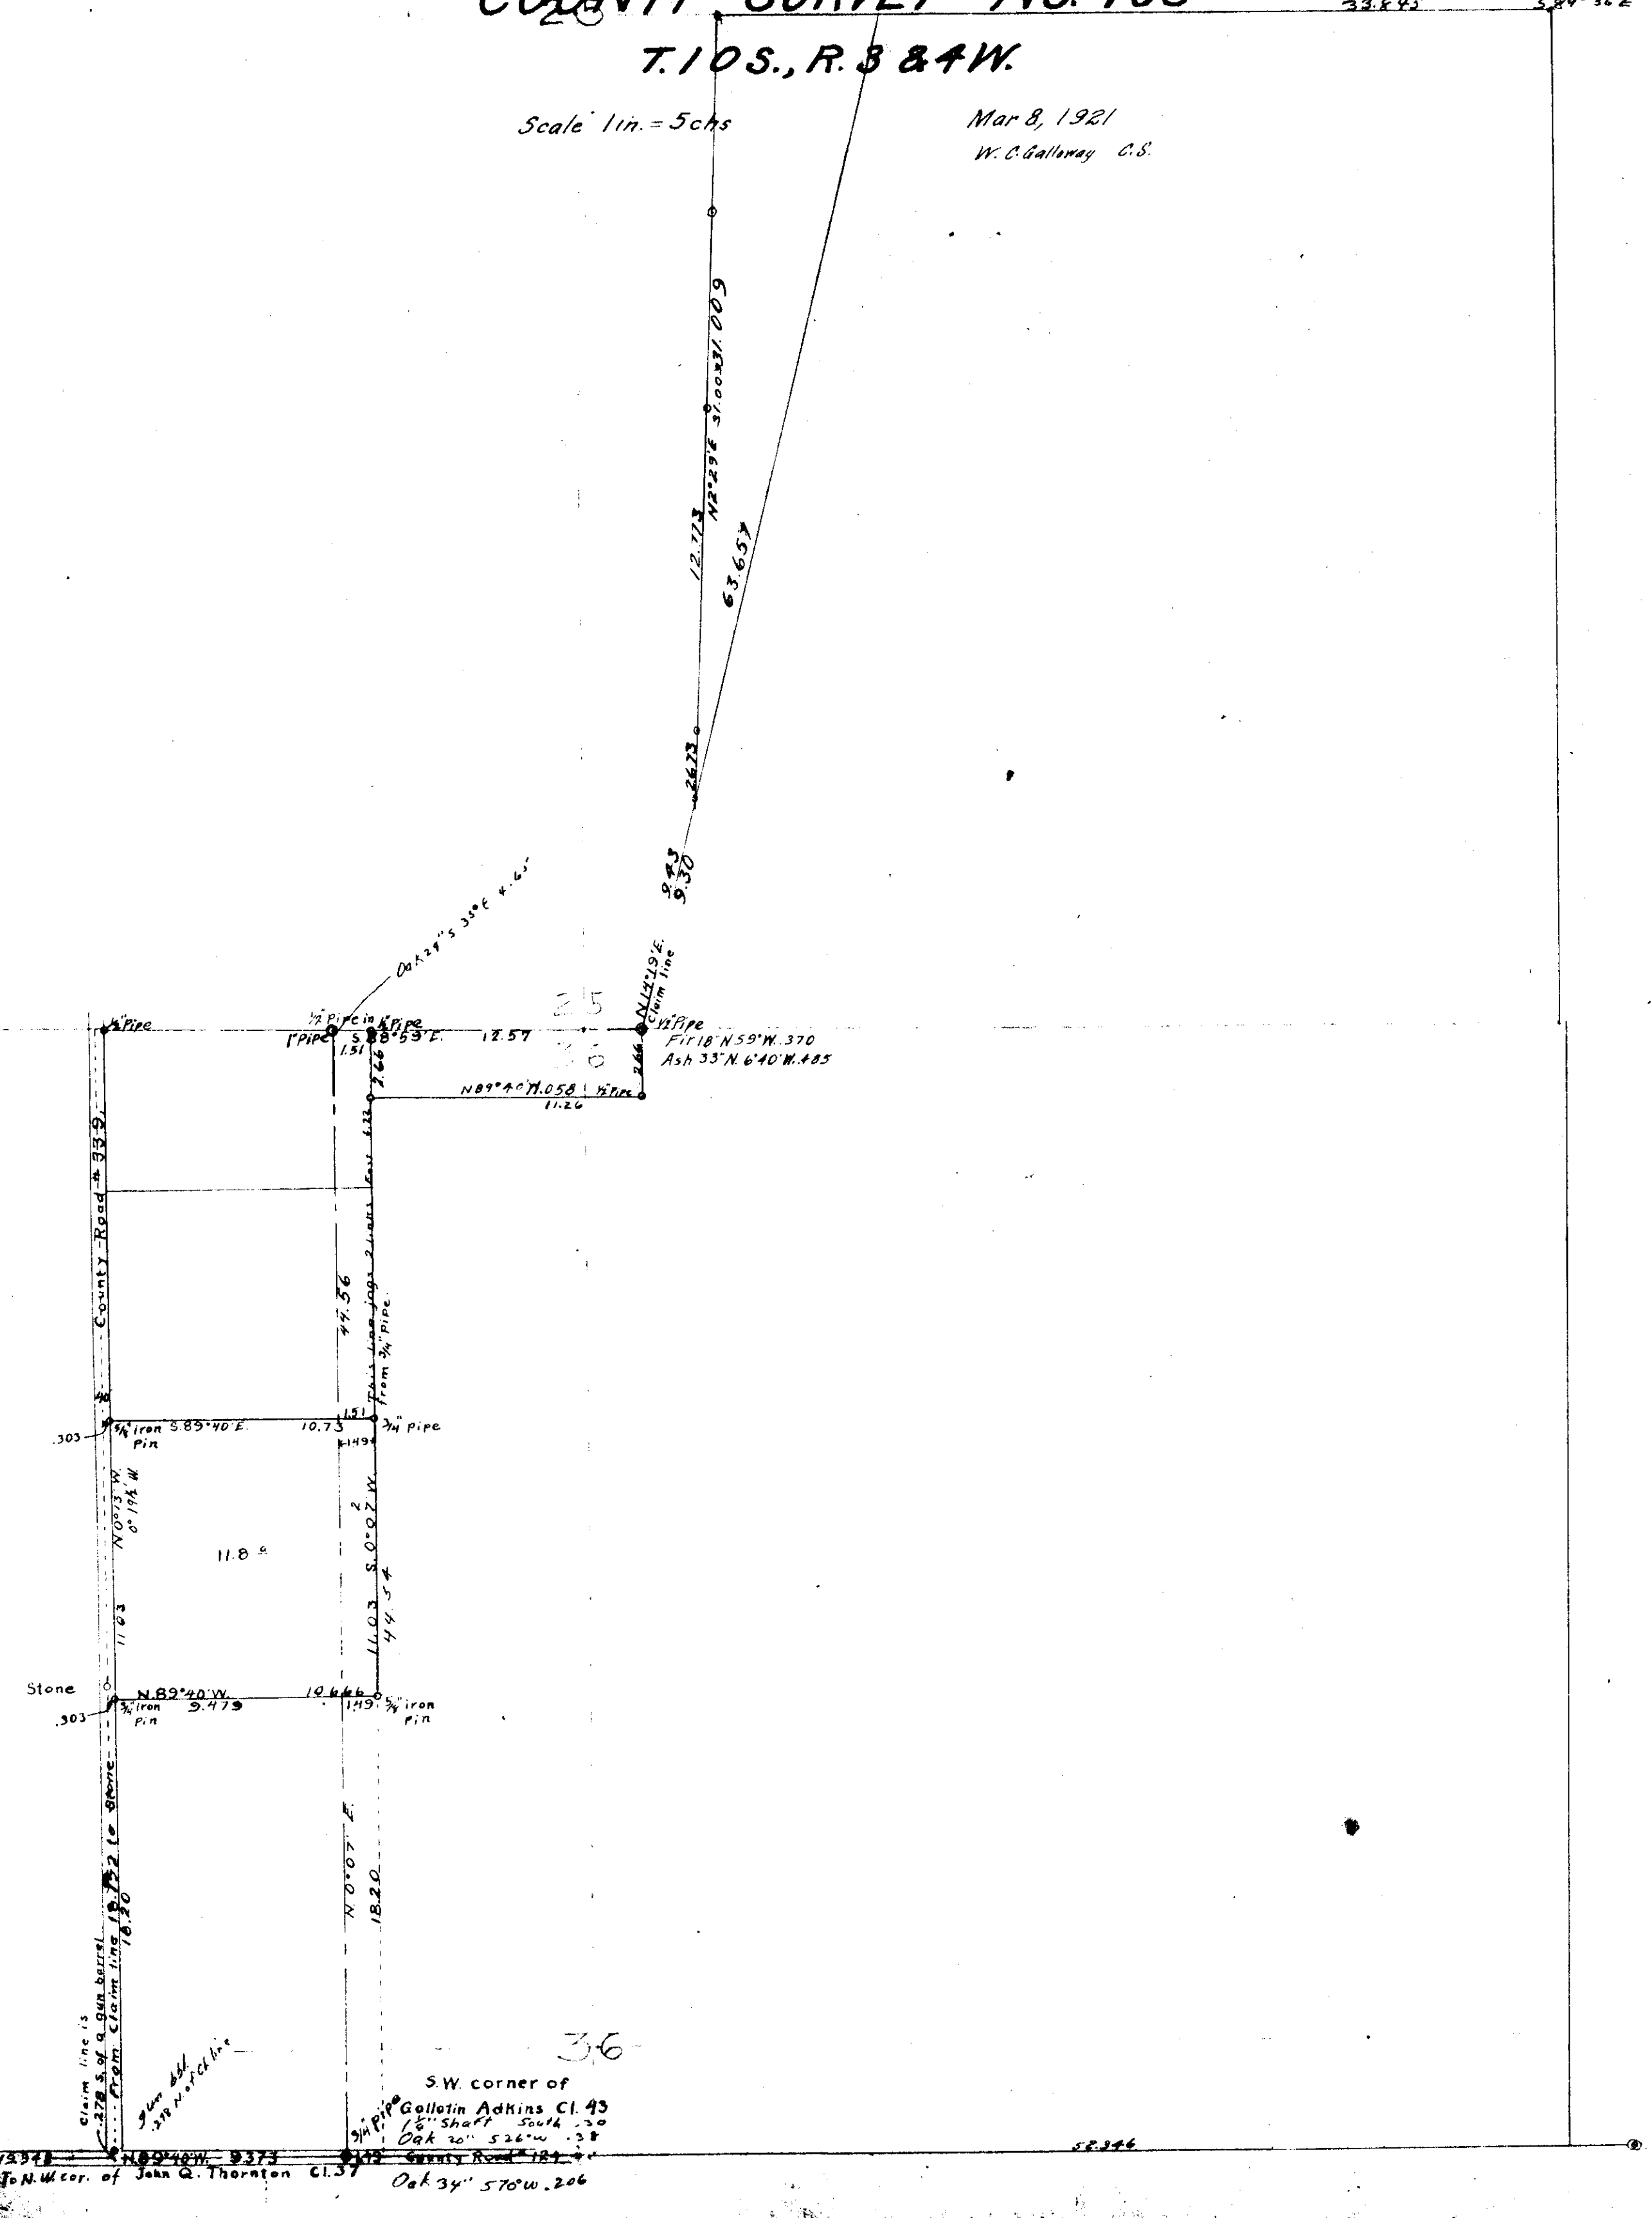

25

30

36

To N.W. cor. of John Q. Thornton Cl. 37
Oak 34' 57° W 206

52.46