


COUNTY SURVEY No 138.

139 on back of this sheet  
in T. 12S. R. 6W.

for  
Johy Roy Rickard et al.  
Mark Cohoon LLC # 58  
Scale 1"=100 ft

9-20-1913 by F.M.W.

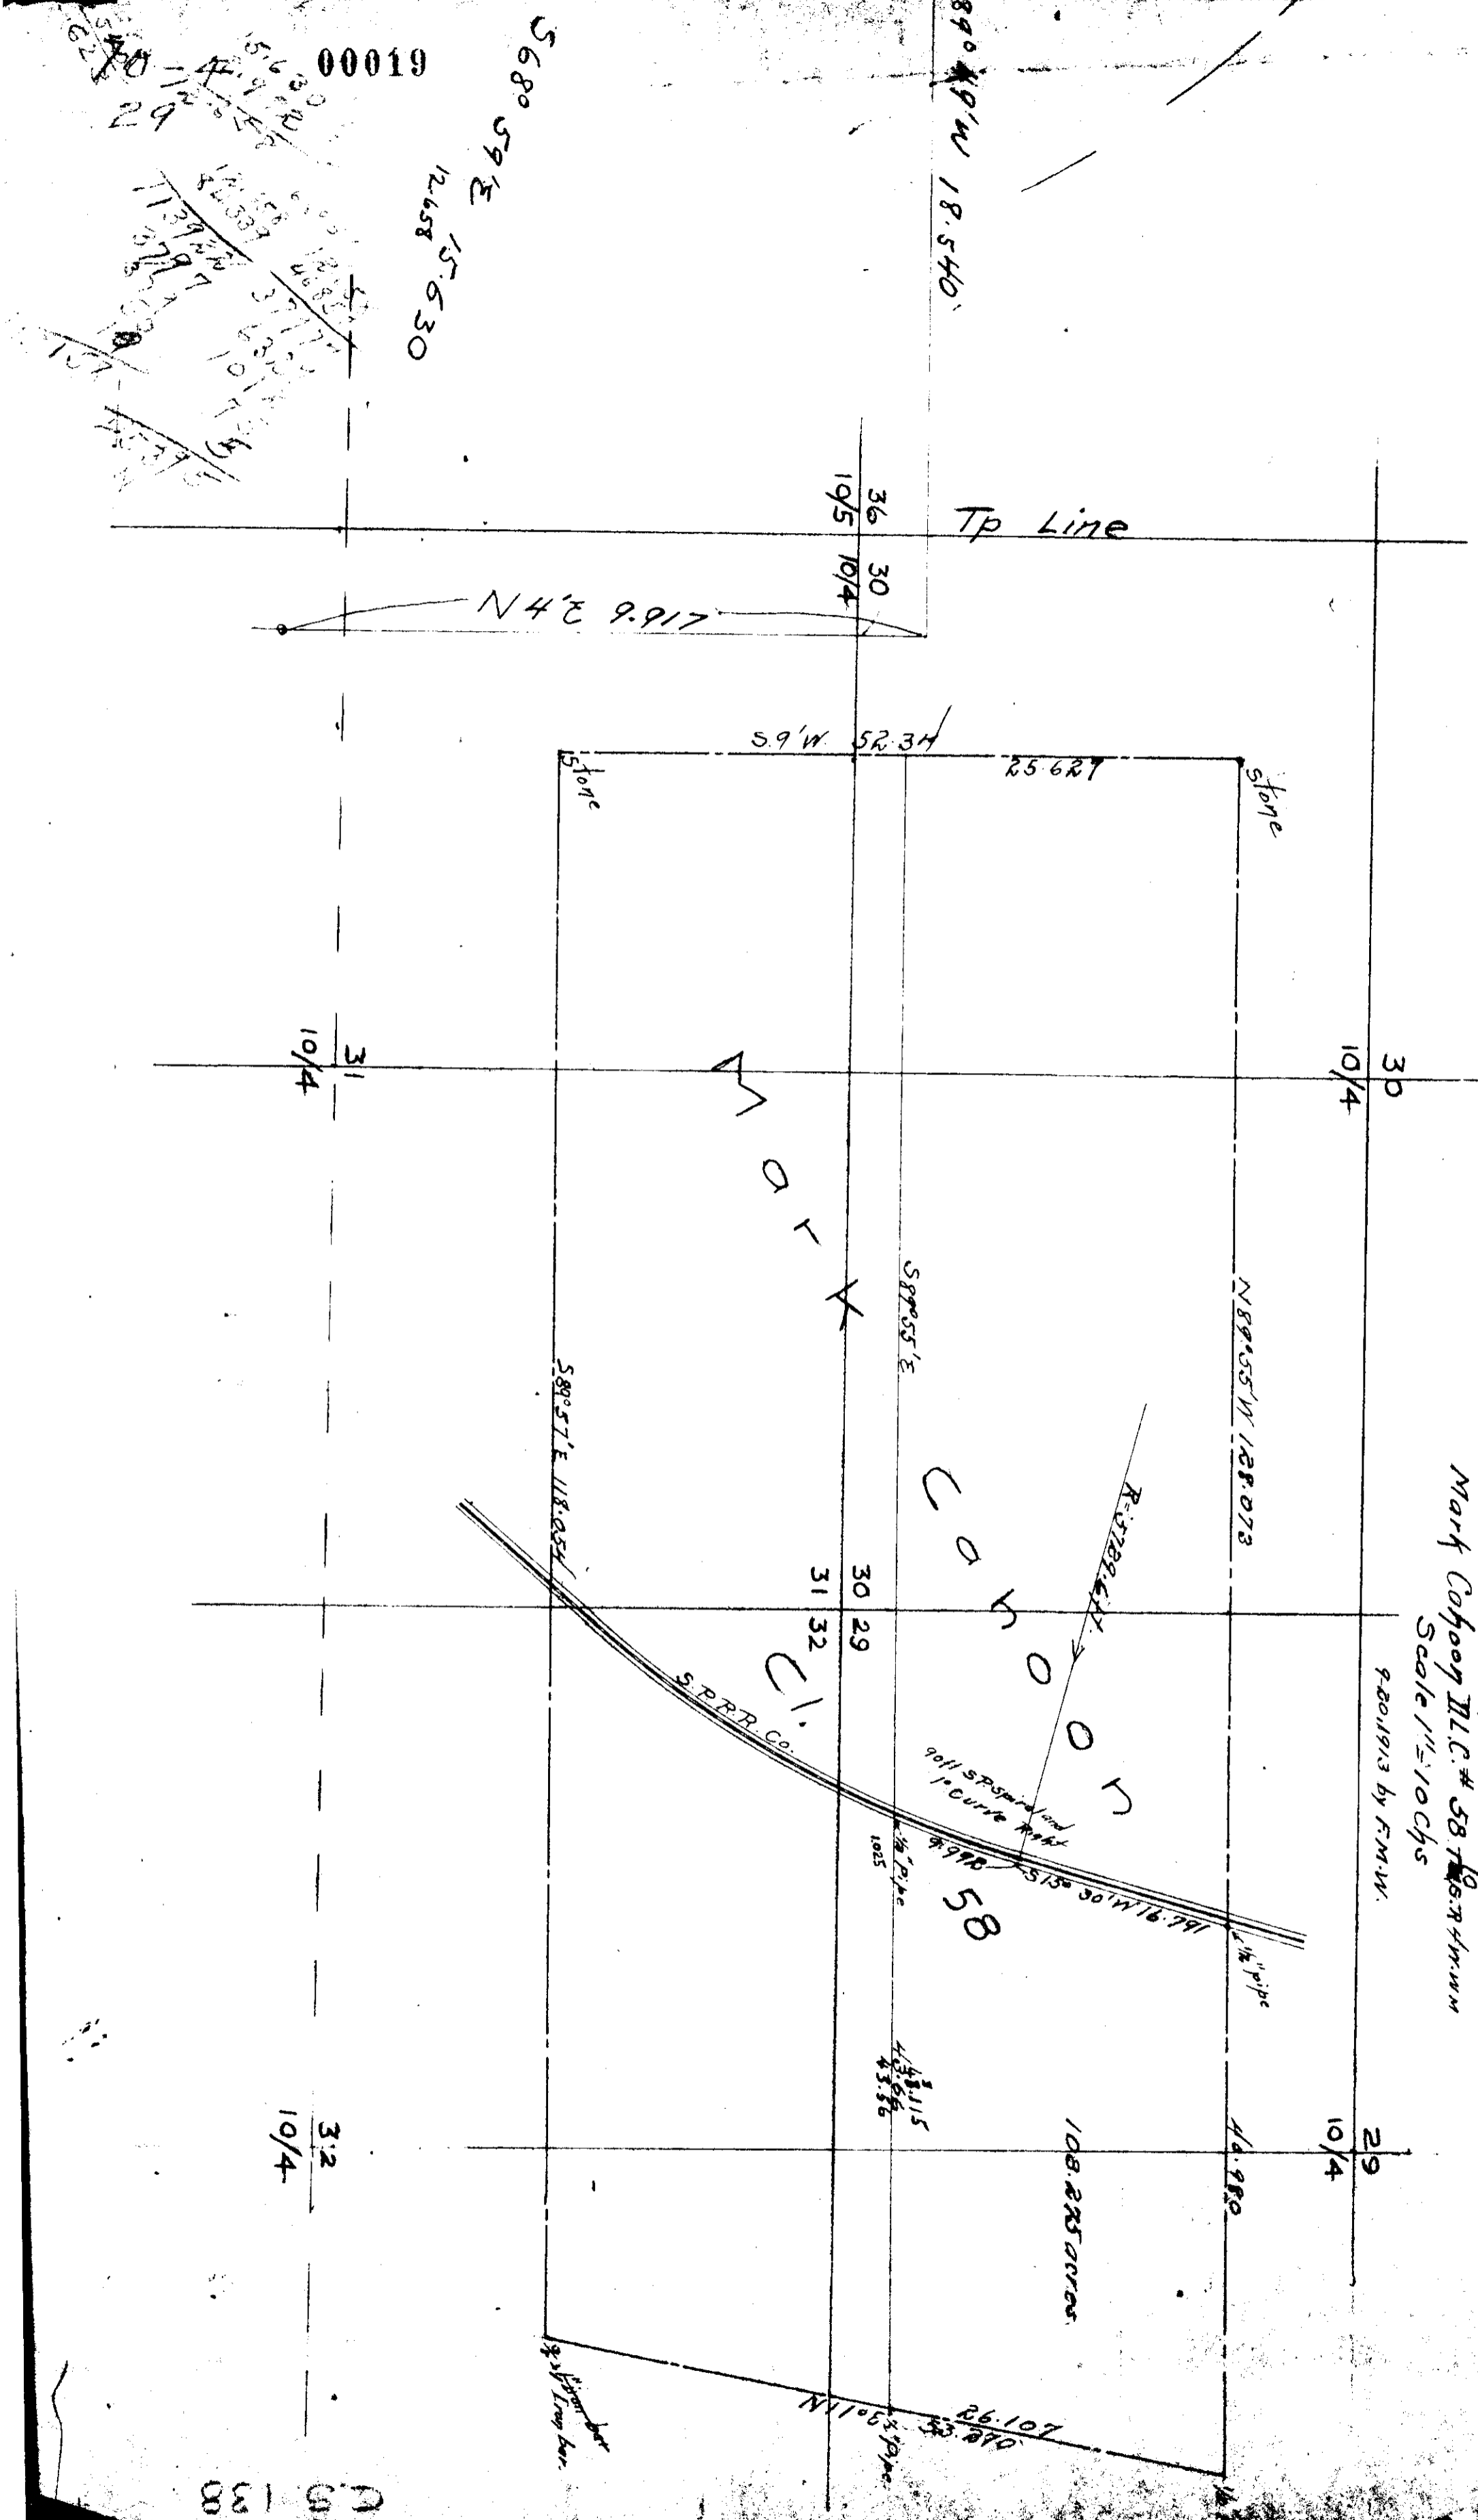

C.S. 138

00019

S 68° 59' E 12.658

15° 5' 30

89° 49' W 18.540

36 19/5  
30 10/4

59' W 52.34

25.627

30 10/4

31 10/4

30 29  
31 32

29 10/4

3:2 10/4

108.235 acres

26.107  
N 1° 11' 30" E 33.870