

10-5

00006


# COUNTY SURVEY NO 134

Secs. 17 & 18 T10S. R5W. W.M.

Scale 1"=10 cts.

W.C. Galloway C.S.  
Mch. 1933.

17 & 18

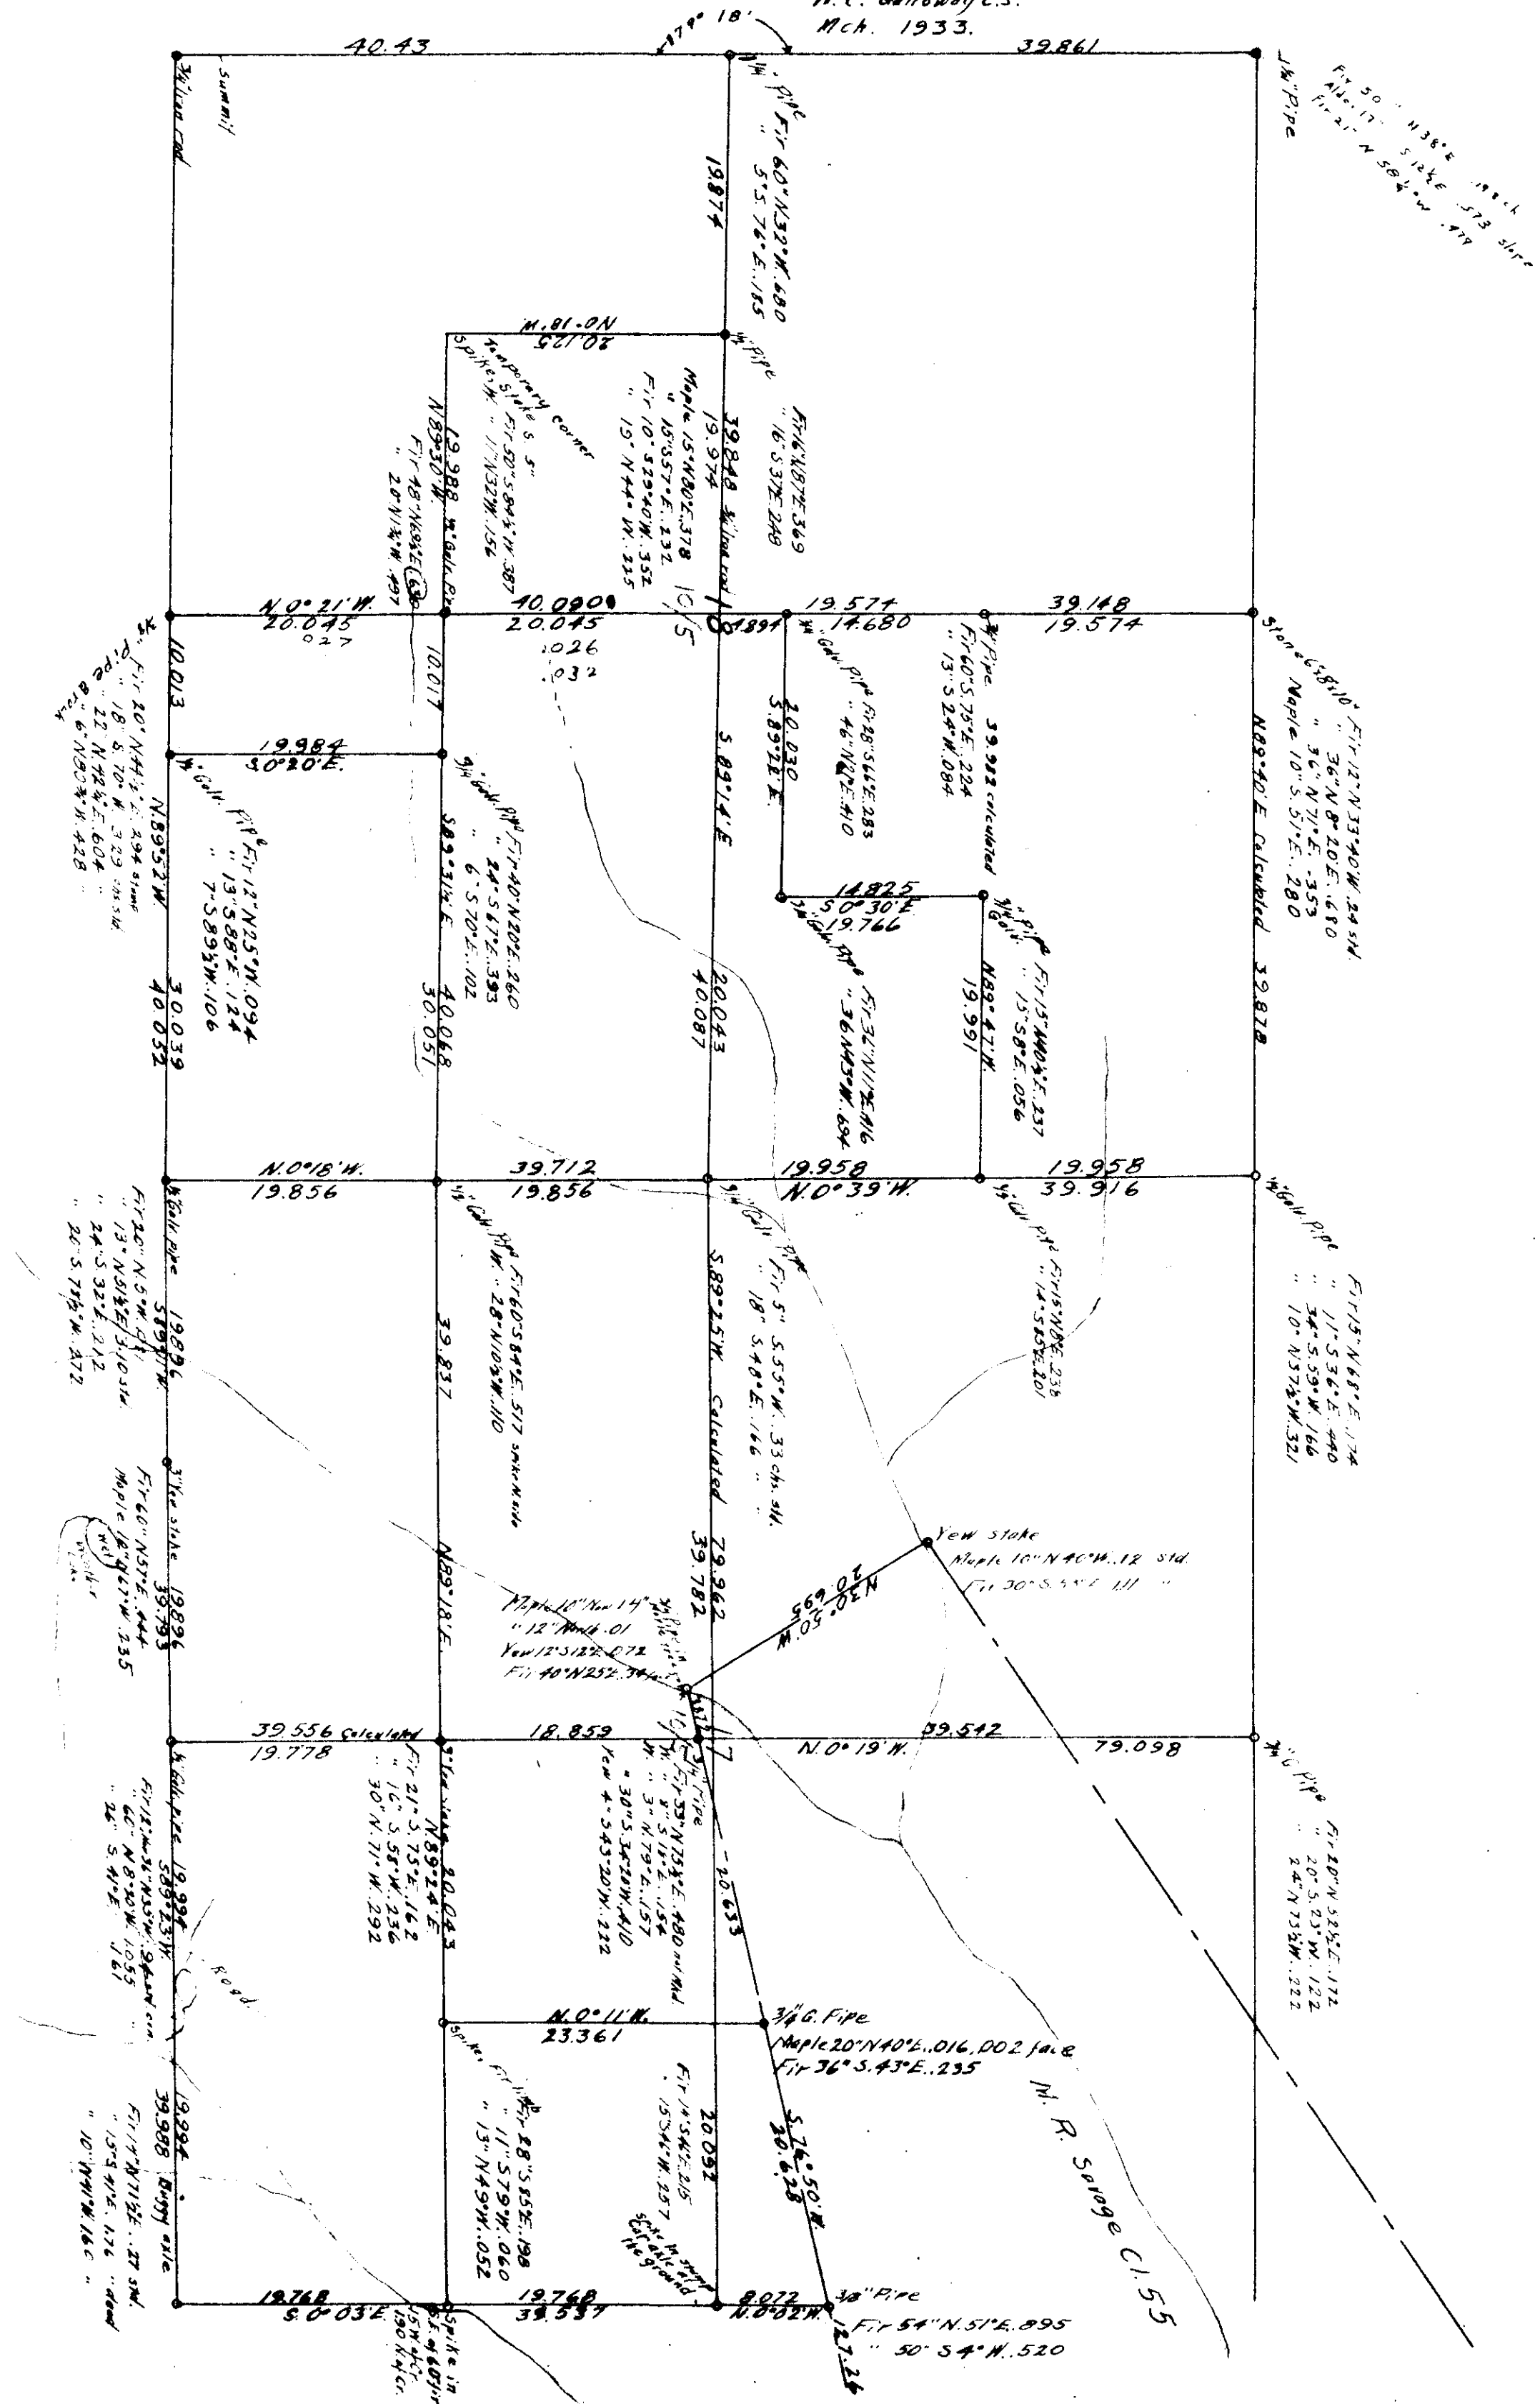

Fix 50' N 36° E 121.1  
 " 17' S 24° E 52.3  
 " 21' N 58° W 117

Store C 2810  
 " 36° N 8° 10' E 680  
 " 56° N 7° E 353  
 " 10° S 51° E 280

360' Pipe  
 " 17° 15' N 88° E 174  
 " 17° 56' E 440  
 " 34° 59' W 166  
 " 10° 15' 32' W 321

3/4" Pipe  
 " 12° 10' N 38° E 172  
 " 20° 52' W 122  
 " 24° N 75° W 222

3 1/2" Pipe  
 " 18° S 70° E 329  
 " 22° N 72° E 604  
 " 6° N 80° W 428

3 1/2" Pipe  
 " 13° 30' N 57° E 444  
 " 13° N 58° E 310  
 " 24° S 32° E 212  
 " 20° S 79° W 422

3 1/2" Pipe  
 " 60° N 8° 30' W 1053  
 " 20° S 41° E 161  
 " 15° S 91° E 176  
 " 10° 11' W 166

Maple 15" N 80° E 378  
 " 16° 57' E 232  
 " 10° S 29° 40' W 352  
 " 10° N 44° W 335

Maple 20" N 40° E 1016  
 " 36° S 43° E 235  
 " 20" N 40° E 1016  
 " 36° S 43° E 235

Maple 20" N 40° E 1016  
 " 36° S 43° E 235  
 " 20" N 40° E 1016  
 " 36° S 43° E 235