


10-6 00007  
 10-6  
 19

CS 204  
 CS 204

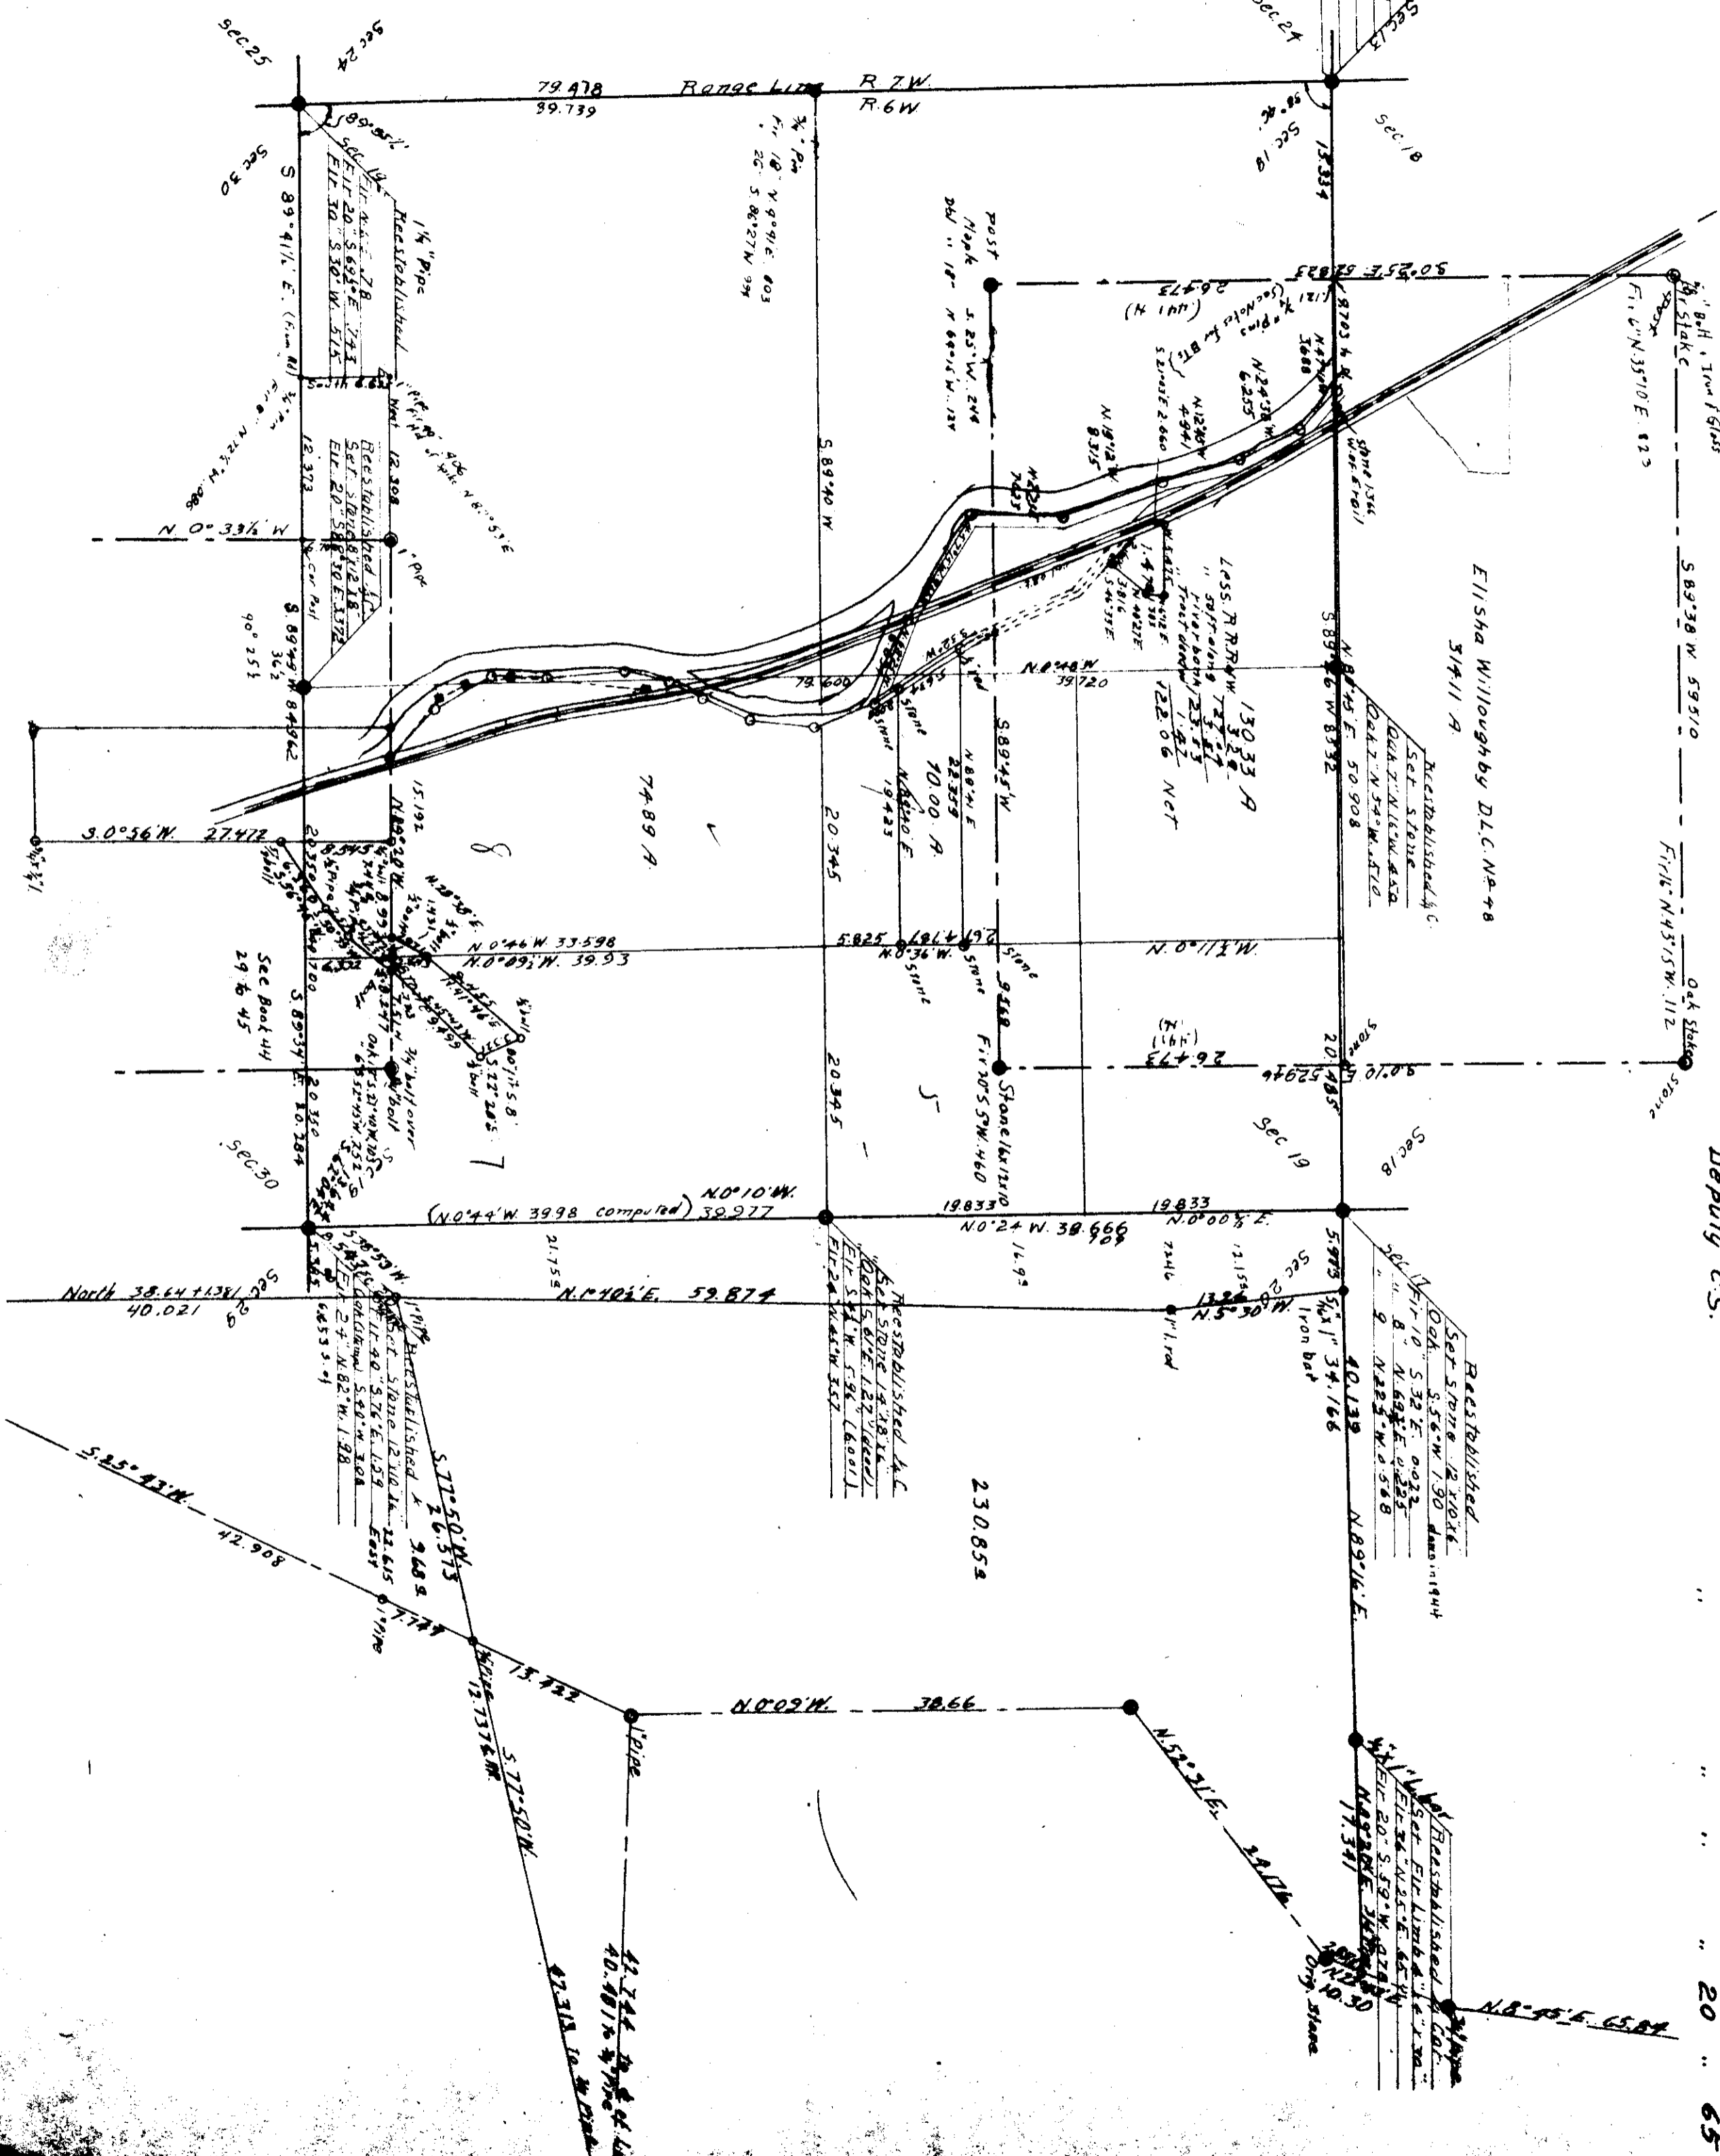

Scale 1" = 100 CHS.

Secs. 19-20 & E. Willoughby D.L.C. No. 48 T. 10 S. R. 6 W. Will. Mer.

COUNTY SURVEY No. 204  
 Made For B. Frantz et al.  
 IN

Deputy C.S.

Field Notes. Book 11 Page 66  
 " " " 19 " 28  
 " " " 20 " 65