


10-6 00010 5/16/51  
20, 21, 28, 29

Scale - 1" = 10 chs

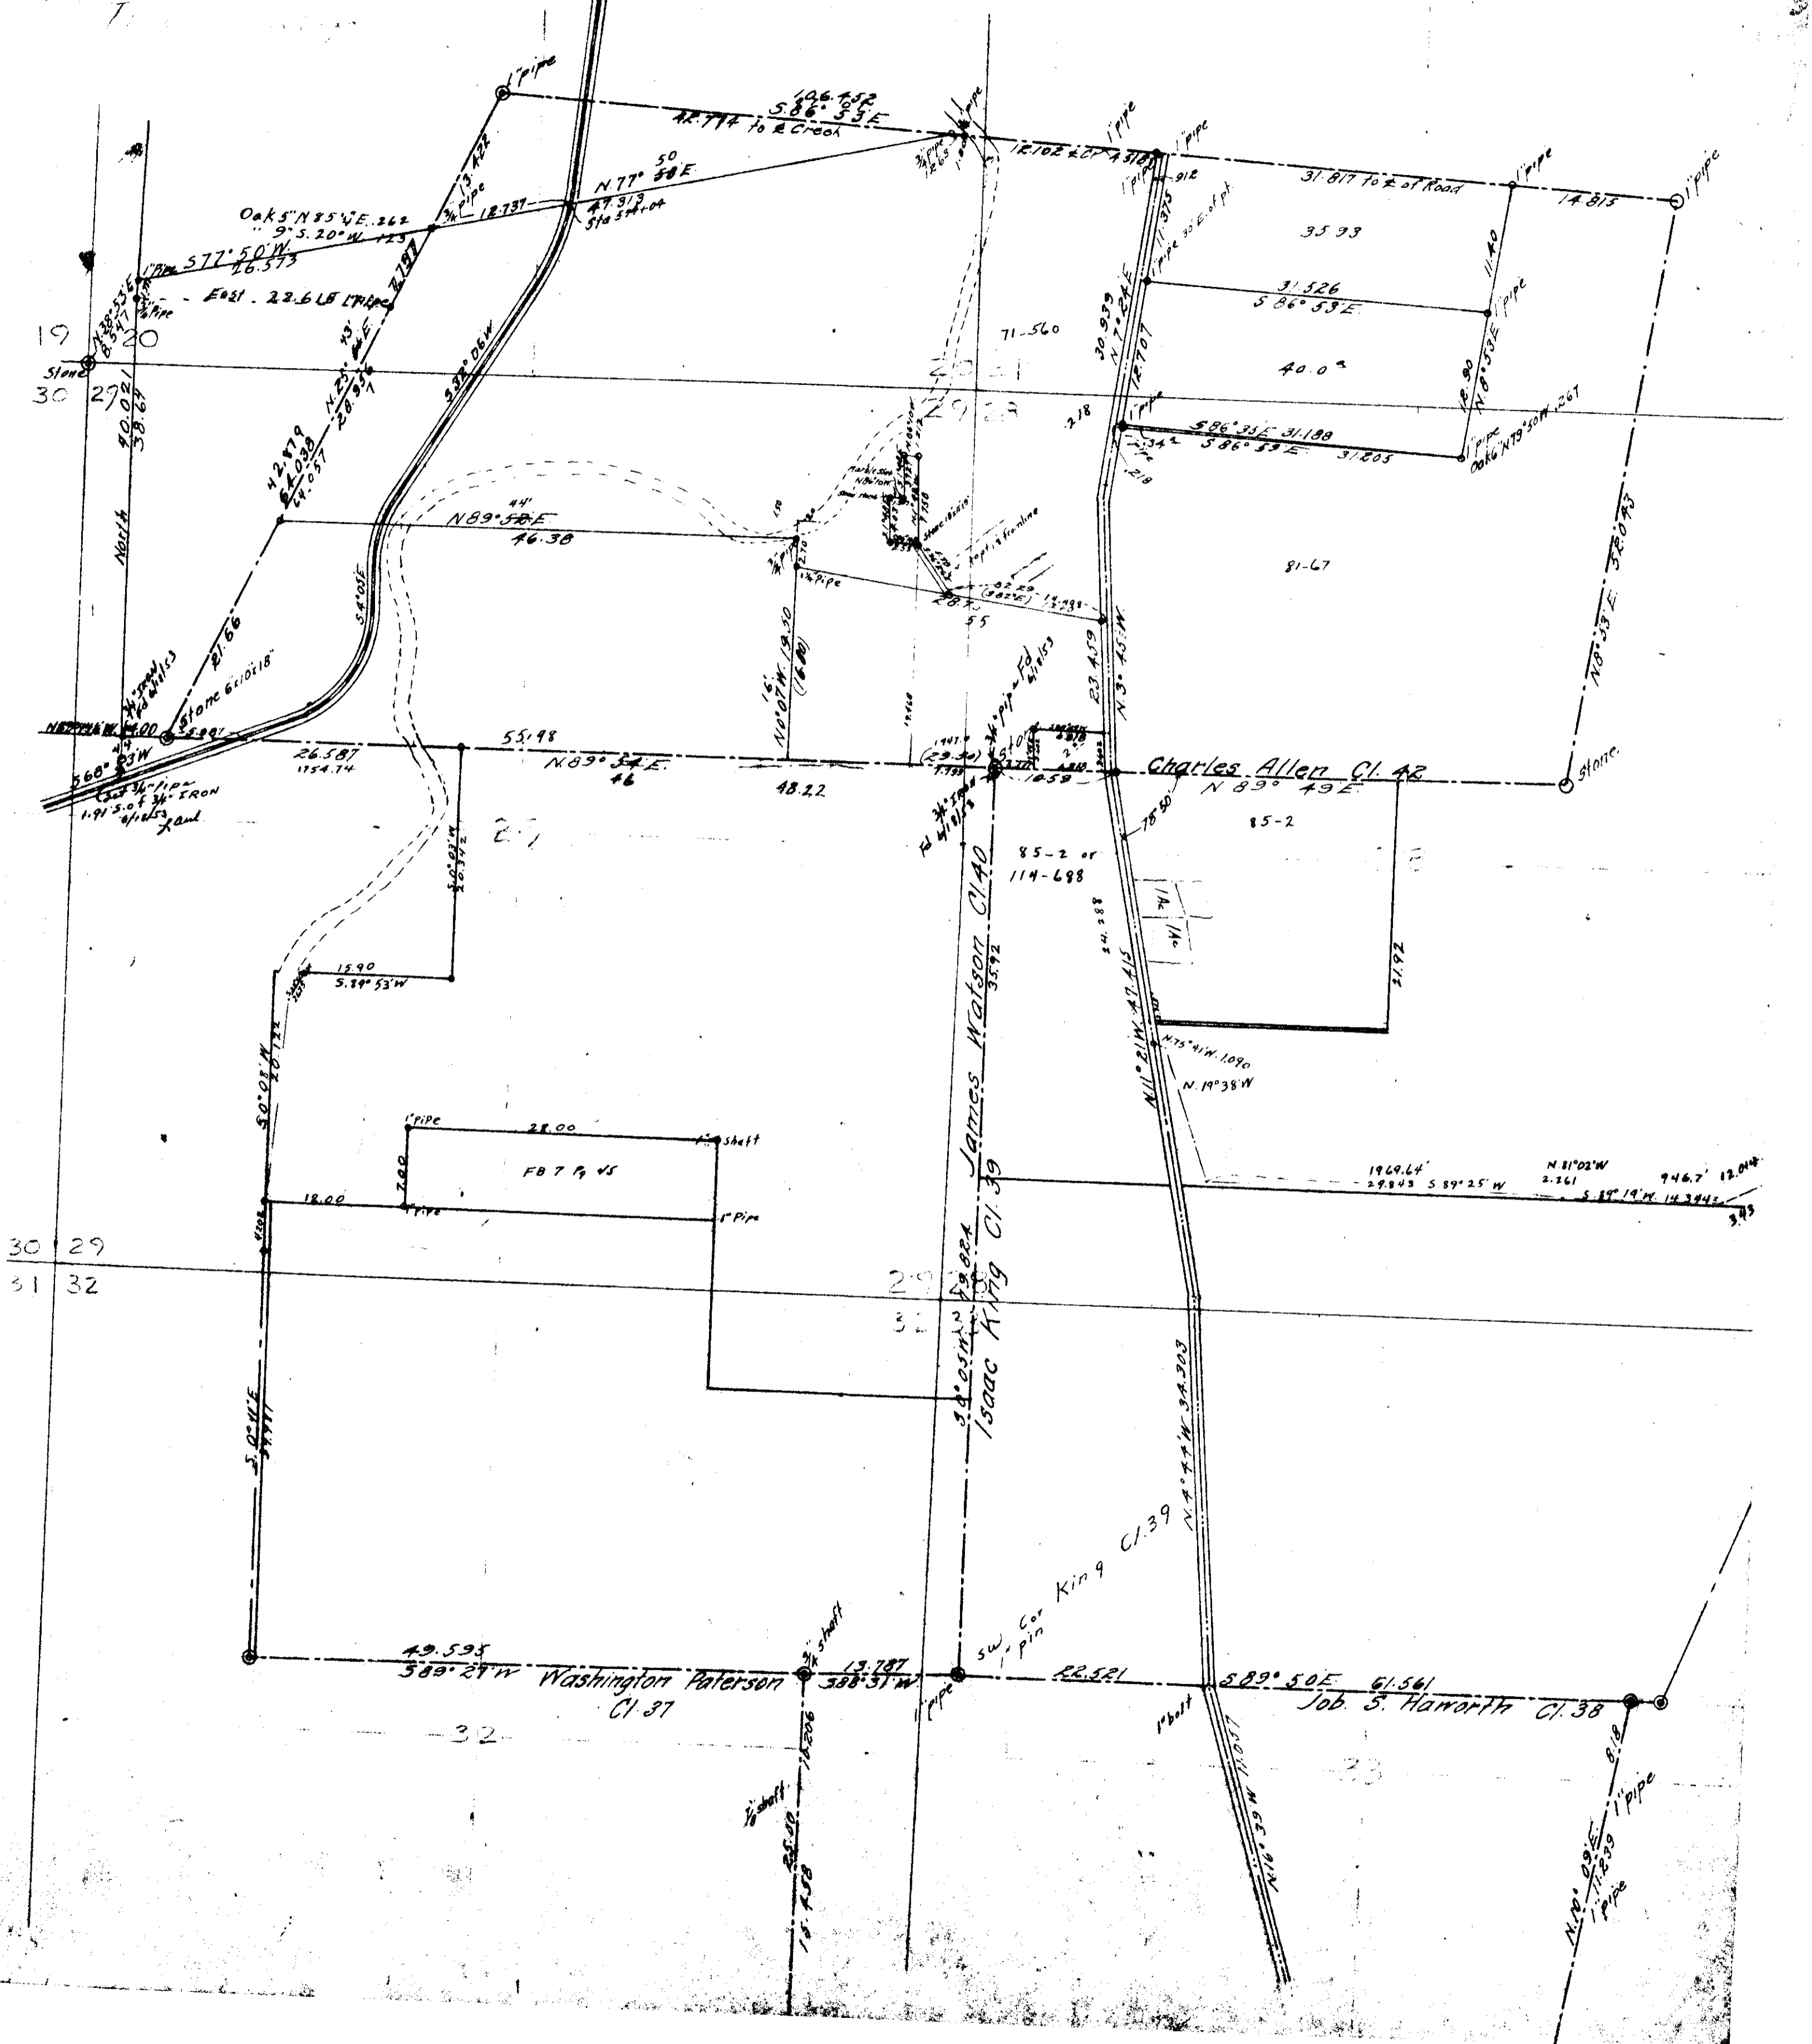

19  
30  
29

30  
31  
29  
32

32

23

20

21

29  
32

Oaks N 85° E. 262  
9° 5.20' W. 123  
577.50 W  
16.573  
East - 22.6 LB (Pipe)

106.452  
586° 55' E  
N 77° 50' E  
50  
12.737

31.817 to E of Road  
35.93  
31.526  
586° 53' E  
40.0°

55.98  
N 89° 52' E  
46  
48.22

Charles Allen Cl. 42  
N 89° 49' E  
85-2  
114-688

28.00  
18.00  
FB 7 9 45  
1" Pipe  
1" Shaft

James Watson Cl. 40  
Isaac King Cl. 39

49.595  
589° 29' W  
Washington Paterson Cl. 37  
13.787  
388° 31' W

22.521  
589° 50' E  
61.561  
Job S. Hamrath Cl. 38

N 80° 02' E  
1" Pipe