

10-6

00013


28-29

County Survey N^o 177

Scale 1"=300'

W.C. Galloway
Dec. 16, 1942

Lucius C. Norton Cl. 43

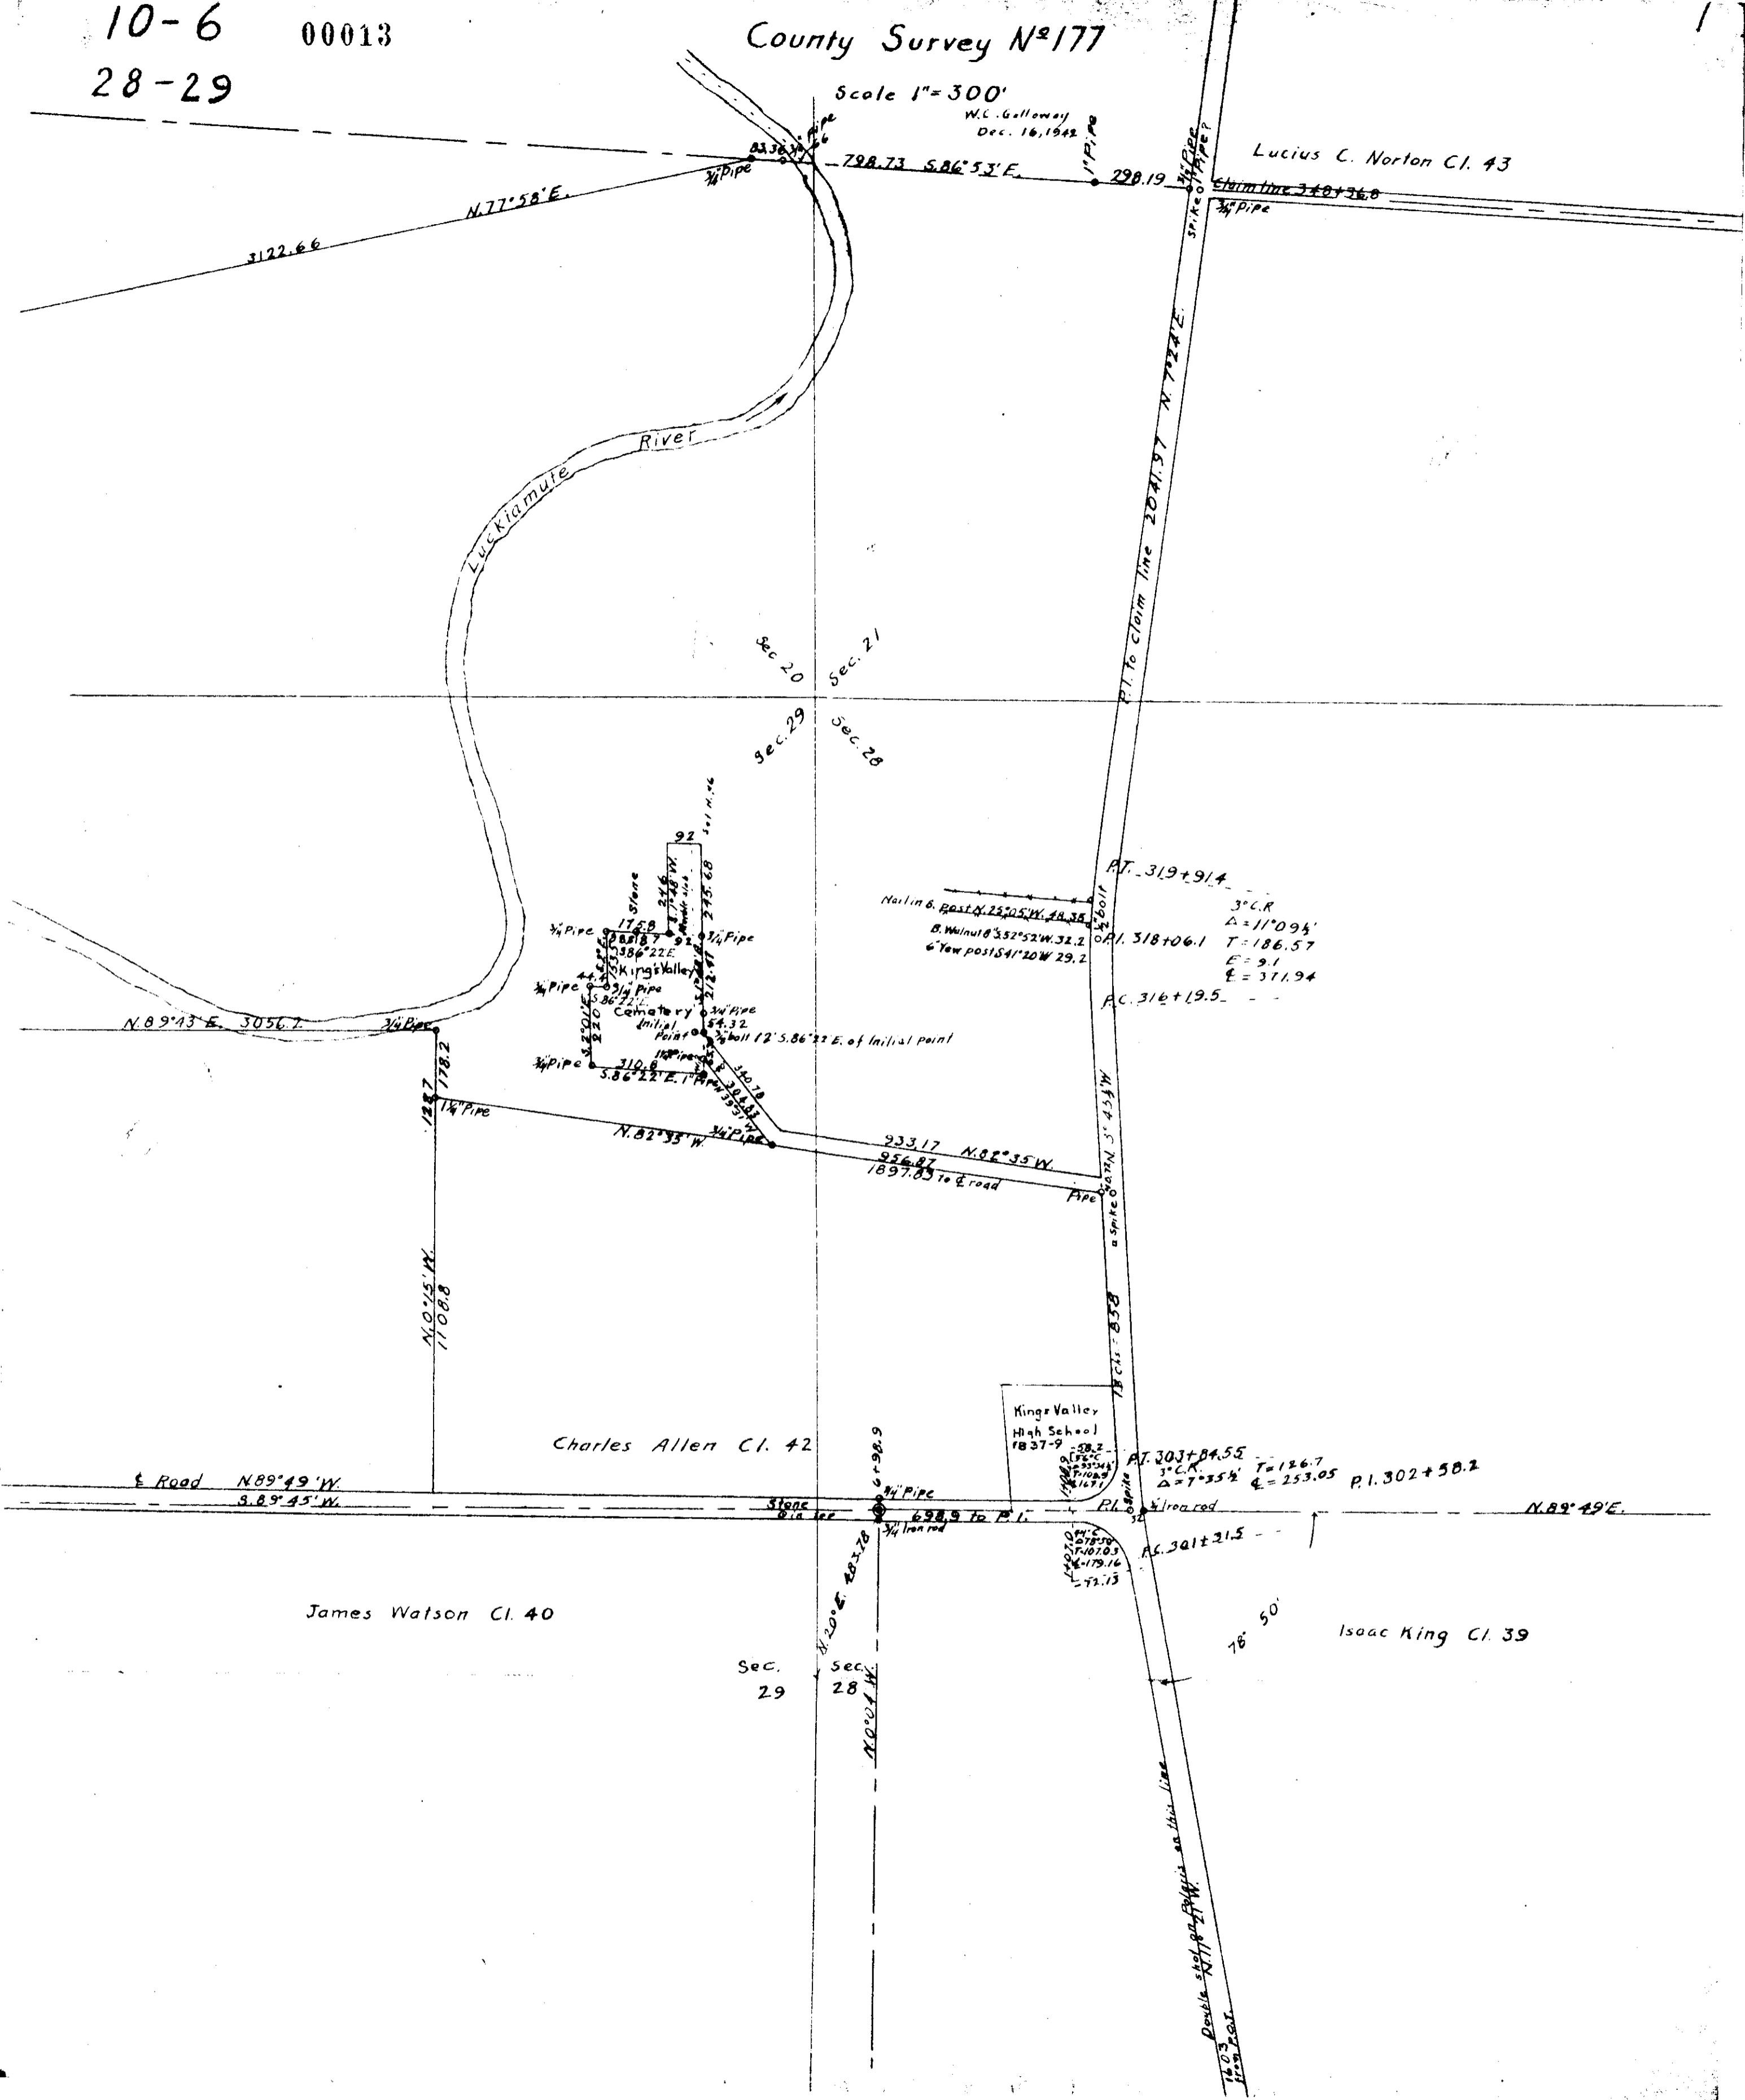

3122.66

N77°58'E.

798.73 S86°53'E.

290.19

Claim line 340+36.0

Luckiamute River

Sec. 20

Sec. 21

Sec. 29

Sec. 28

P.I. to claim line 20+197 N 77°42'E.

Nail in S. Post of 23705' W. 48.38
B. Walnut 8°52'S 2' W. 32.2
6" Yew post S 41° 20' W 29.2

P.T. 319+91.4

3° C.R.
Δ = 11° 09 1/2'
T = 186.57
E = 9.1
Σ = 371.94

P.C. 316+19.5

N. 89° 43' E. 3056.7

3/4 Pipe

128.7

1/4 Pipe

1108.8

178.2

Stone
92
17.58
3/4 Pipe
388.7
386° 22'E
King's Valley
Cemetery
Initial
Point
310.8
3/4 Pipe
5.86° 22' E. 117.8
3/4 Pipe
189.8
N. 82° 33' W
3/4 Pipe
30.18
3/4 Pipe
32.85
3/4 Pipe
32.85
3/4 Pipe
12.5.86° 22' E. of Initial point

933.17 N. 82° 35' W.
956.87
1897.85 to & road

1/4 Pipe

1897.85

to & road

Pipe

Charles Allen Cl. 42

King's Valley High School
1837-9

P.T. 303+84.55

3° C.R.
Δ = 7° 35 1/2'
T = 126.7
E = 253.05
P.I. 302+50.2

& Road N. 89° 49' W.
S. 89° 45' W.

Stone
6.10
102

6+98.9

3/4 Pipe

698.9 to P.I.

3/4 Iron rod

102

102

James Watson Cl. 40

Sec. 29

Sec. 28

P.I. 302+50.2

1/4 Iron rod

76° 50'

P.C. 301+21.5

Isaac King Cl. 39

Double spike in place as this line
103
Iron rod