


10-6
34,35-

00016

11-6
3-4-9-10

14' 10 1/2" Pipe
10' 10 1/2" Pipe
15' 5 1/2" Pipe
20' 5 1/2" Pipe

05.214
Scale: 1" = 100 ft.

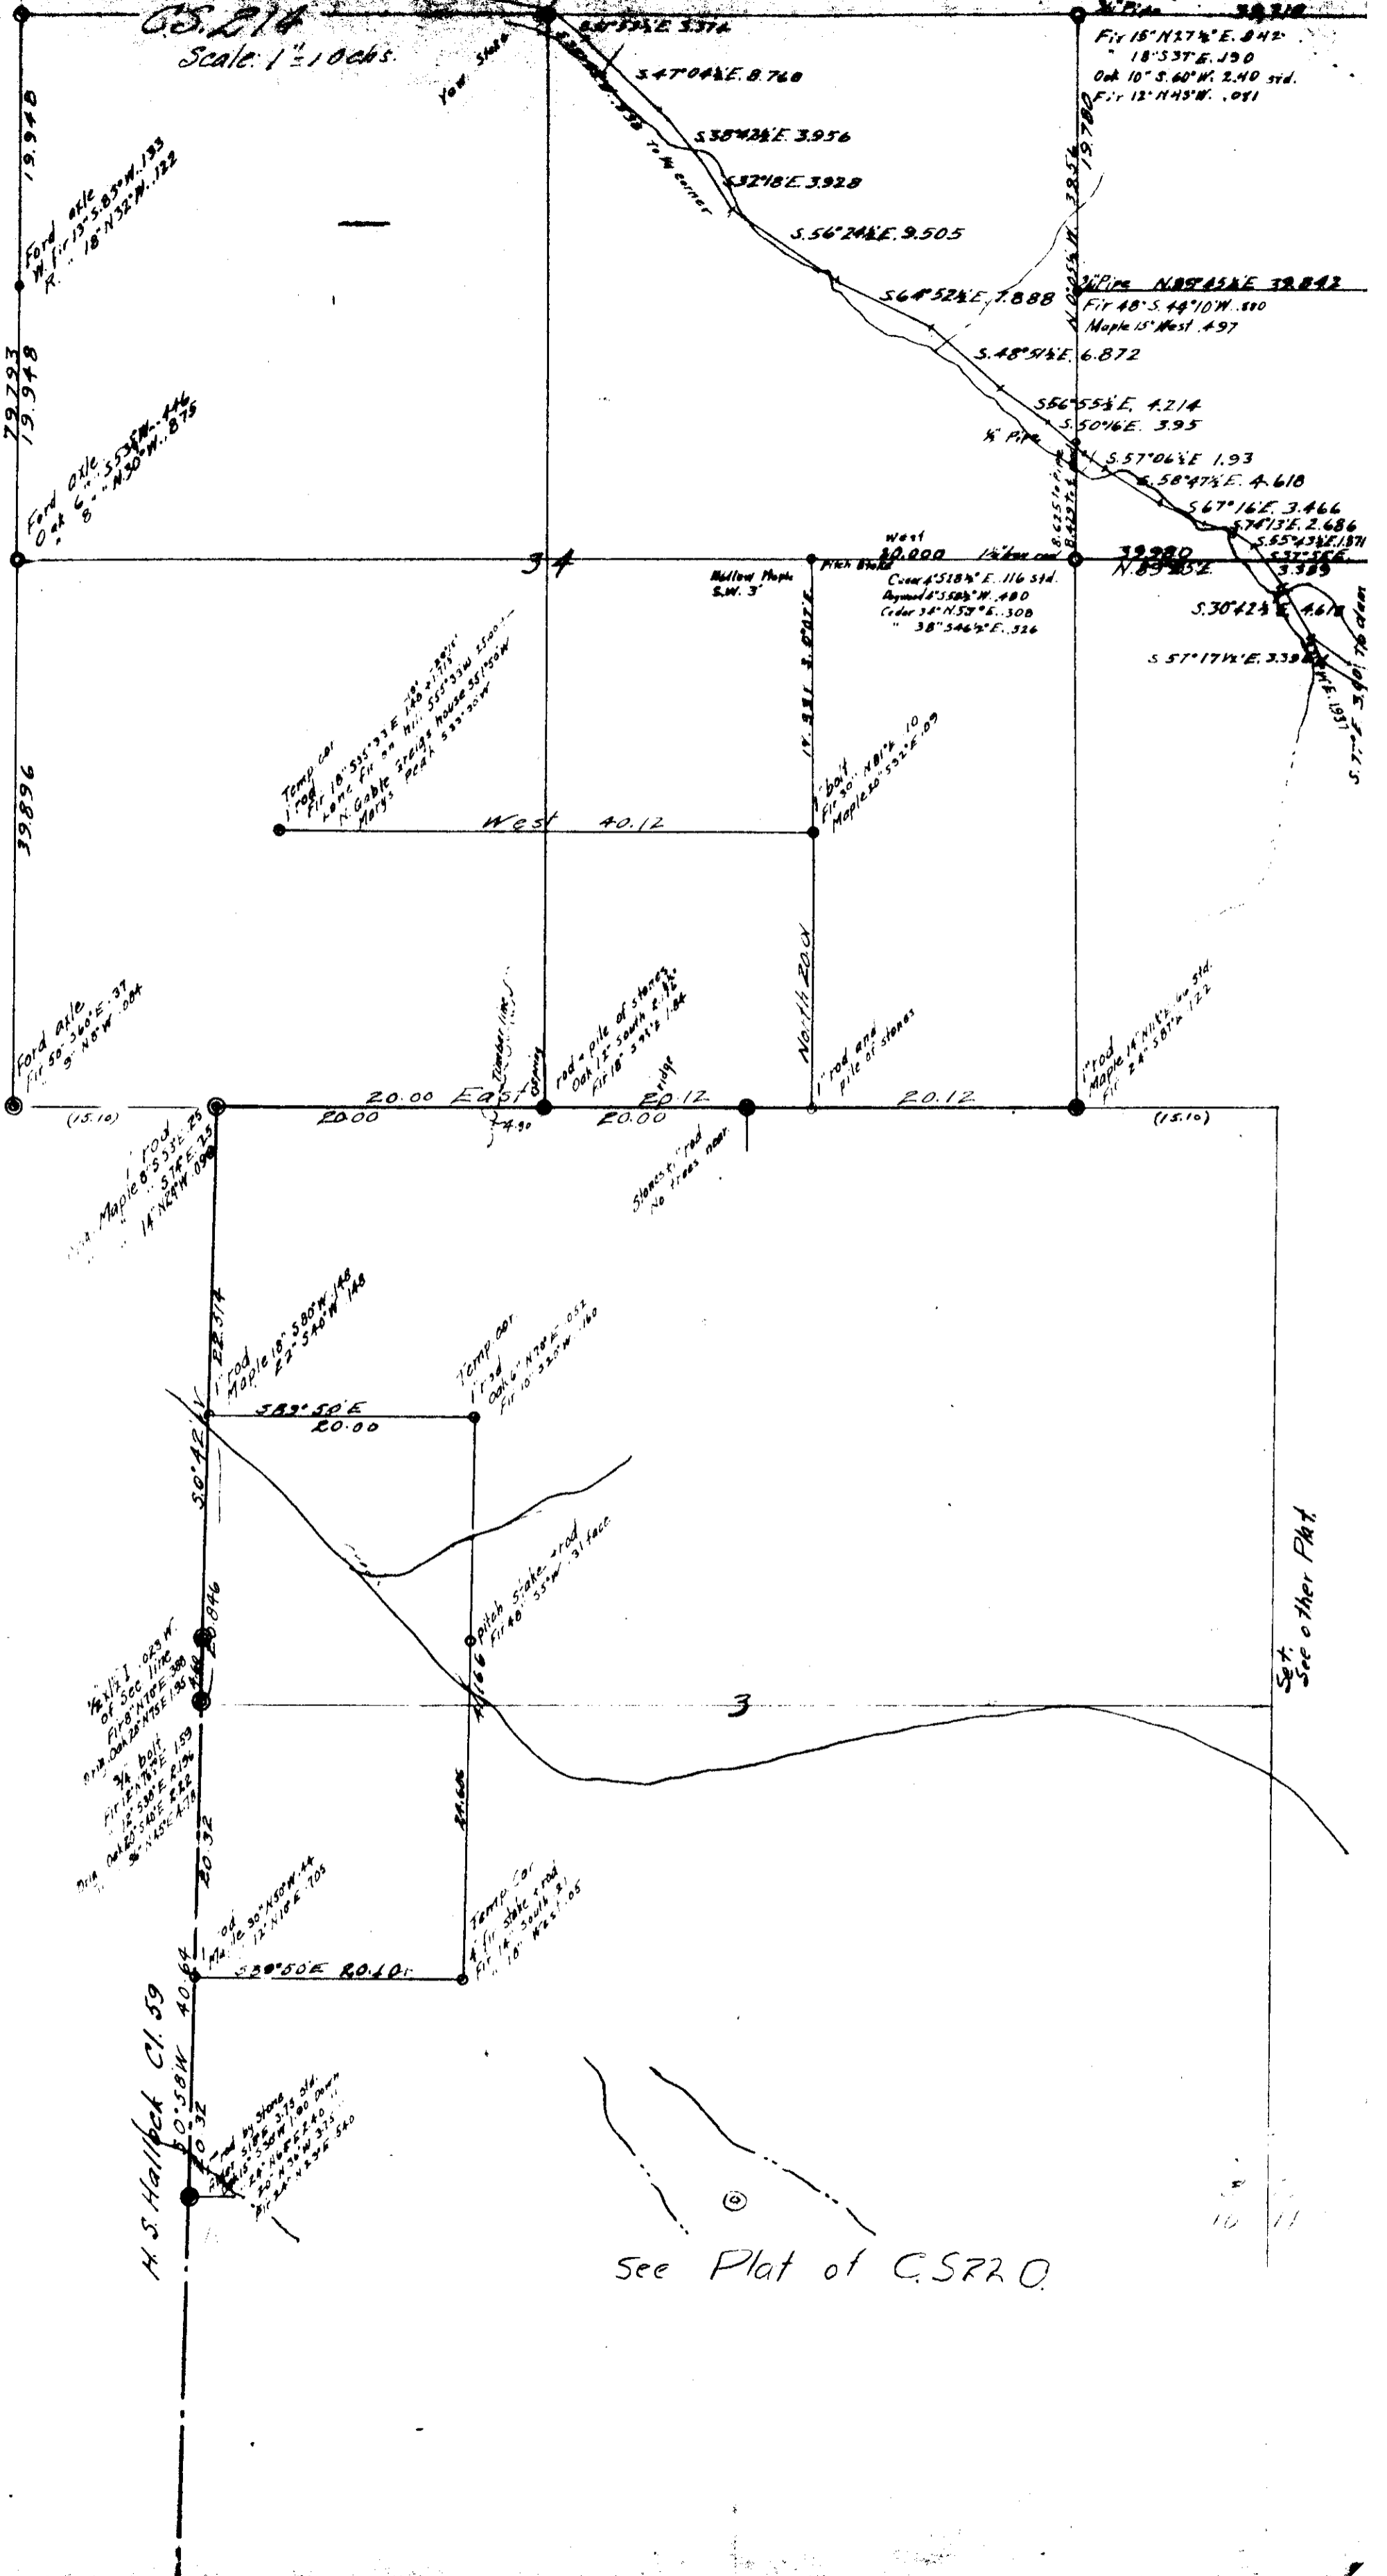

See other Plat

see Plat of C.572.0