


10-7 00008

20, 21, 28 & 29

COUNTY SURVEY 150

For Fred Heidle et al

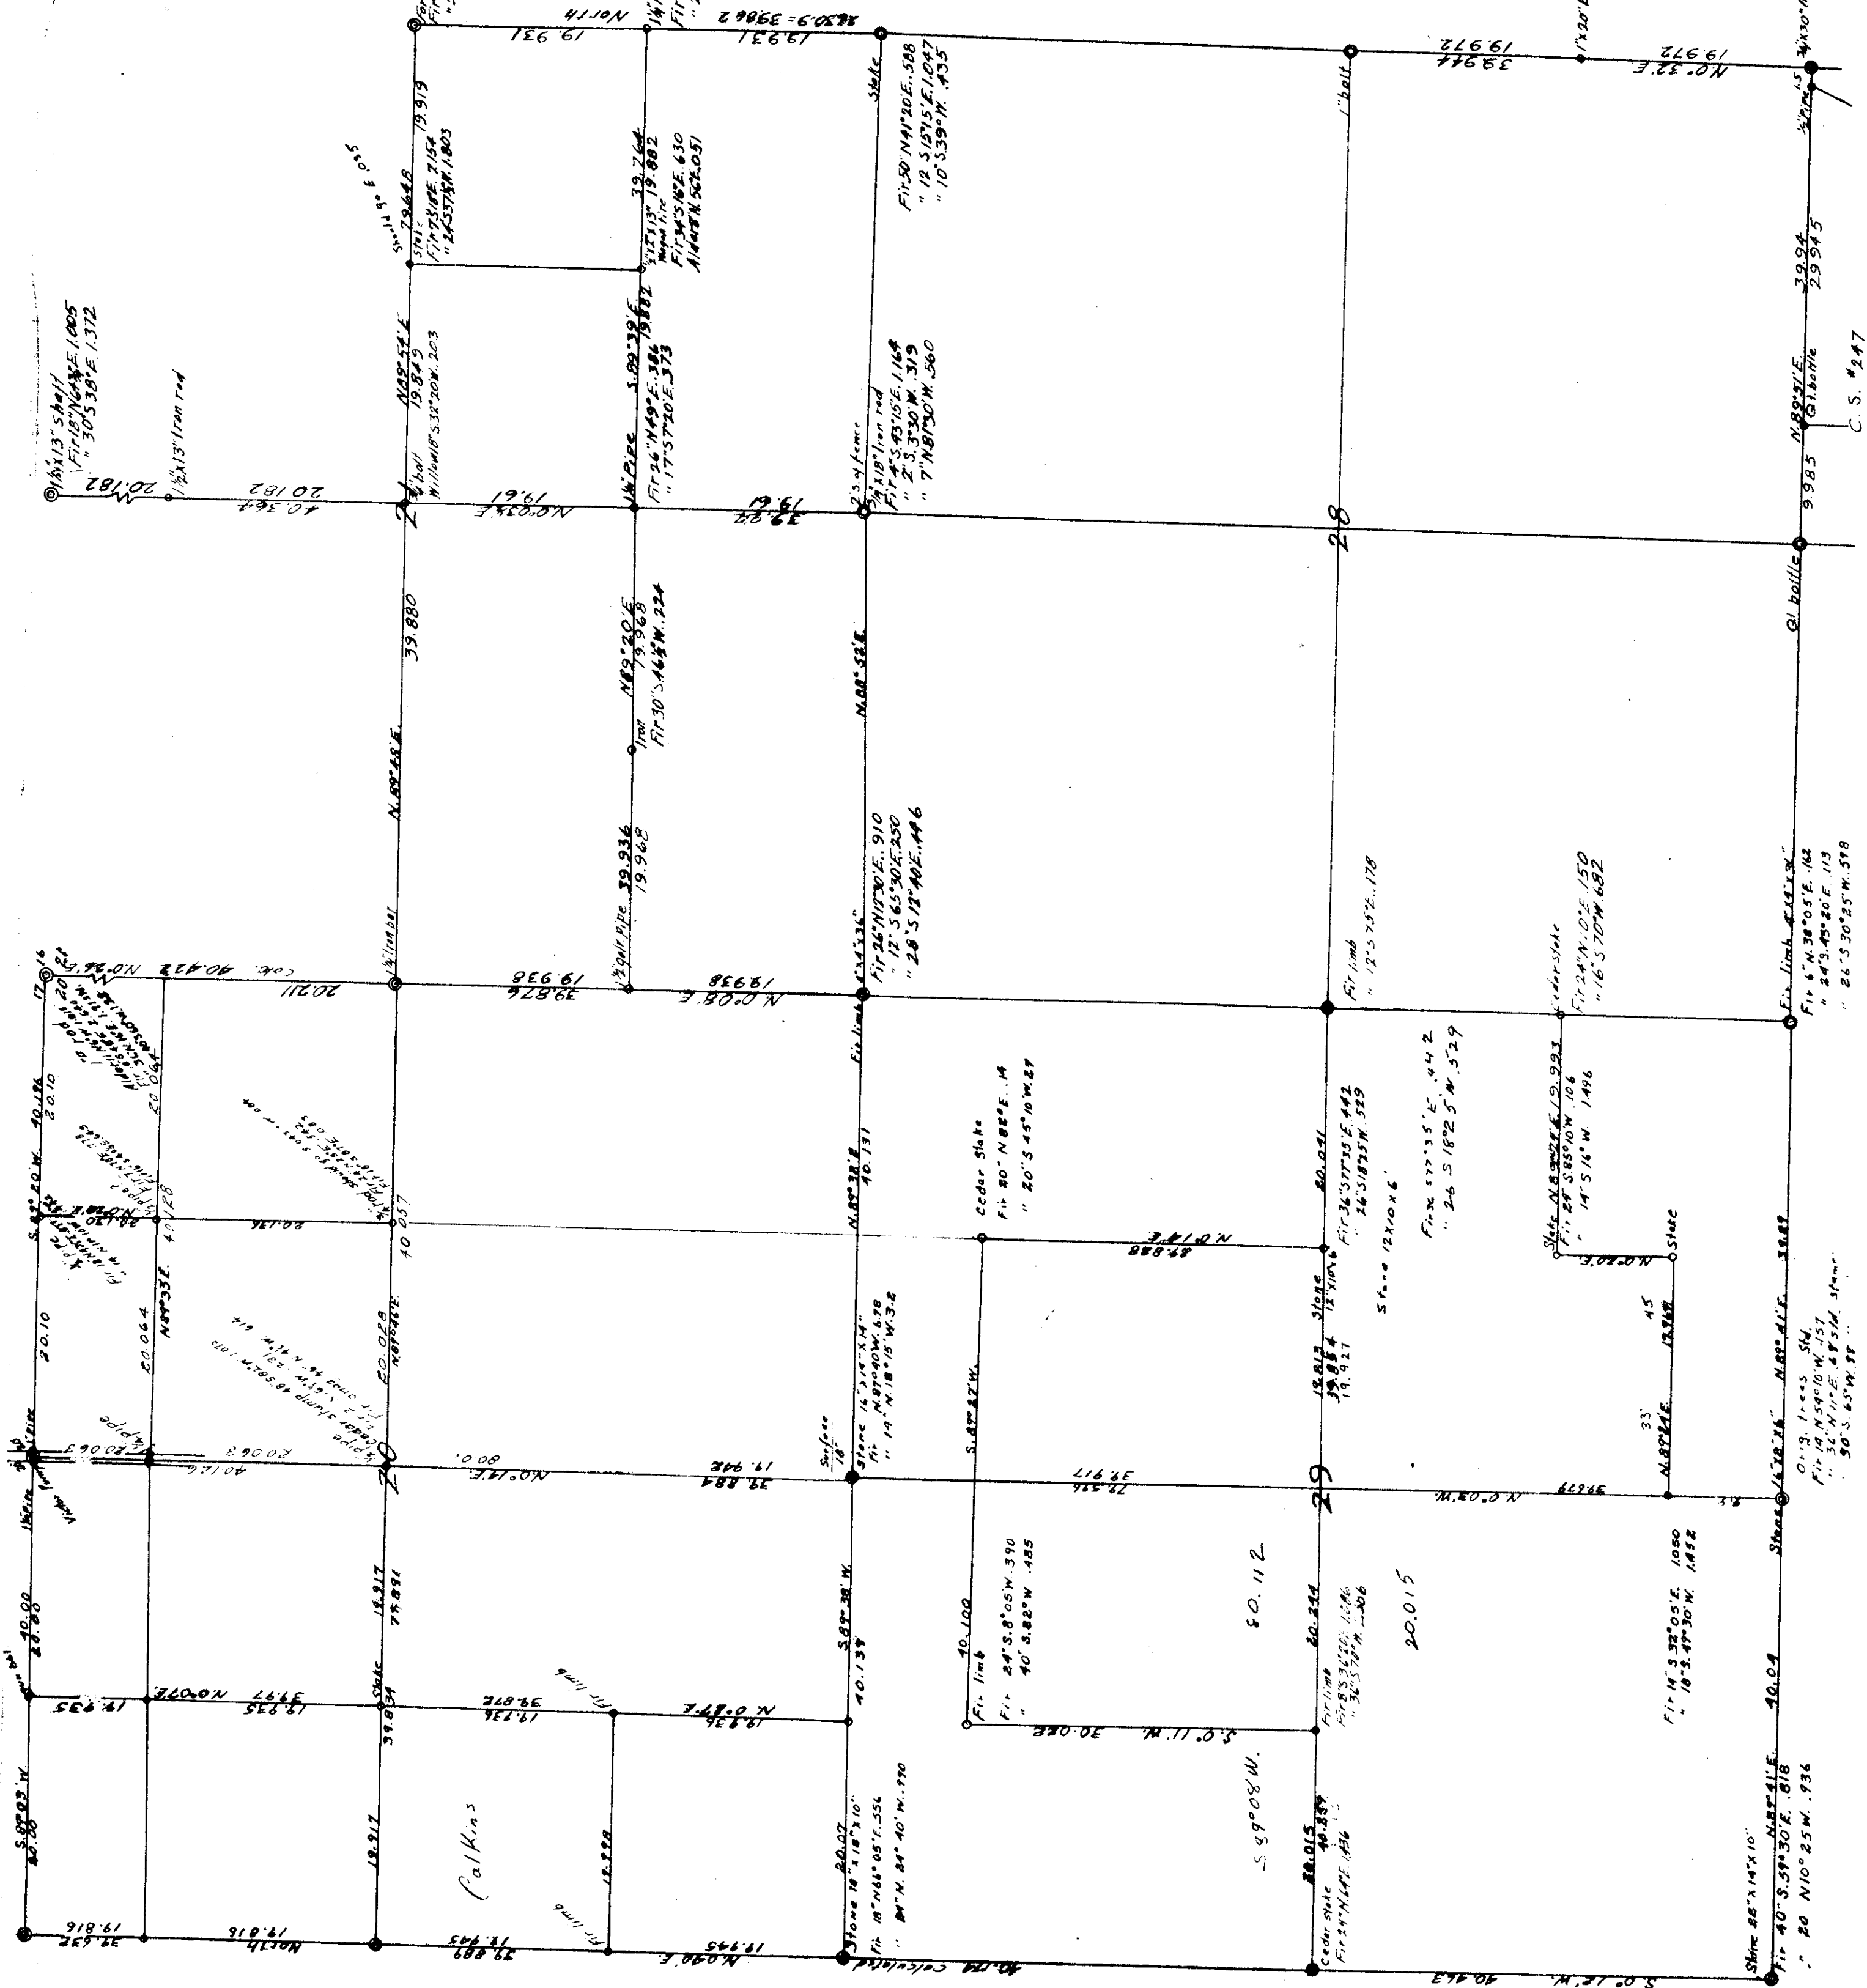

C. S. #247