


10-7

00017

1" = 200'

32

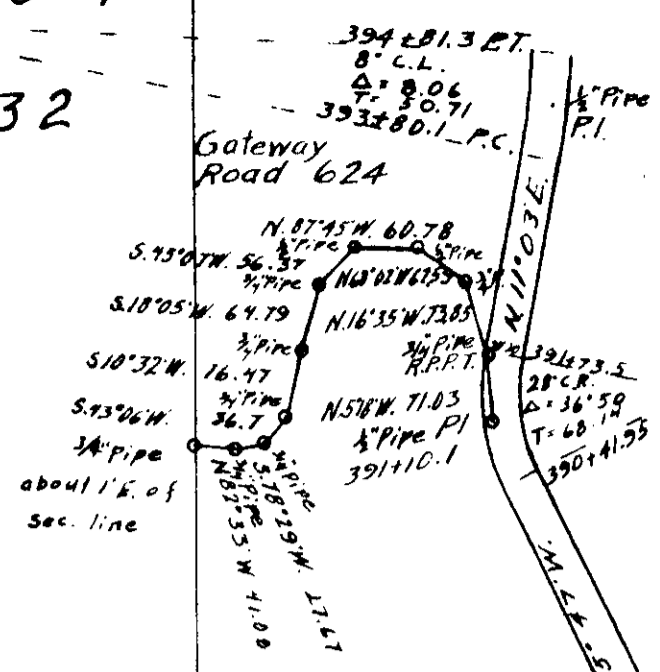

Calculated N. 00° 27' E. 2639.0

Point 3

