


35 36

2

7 105 7 115

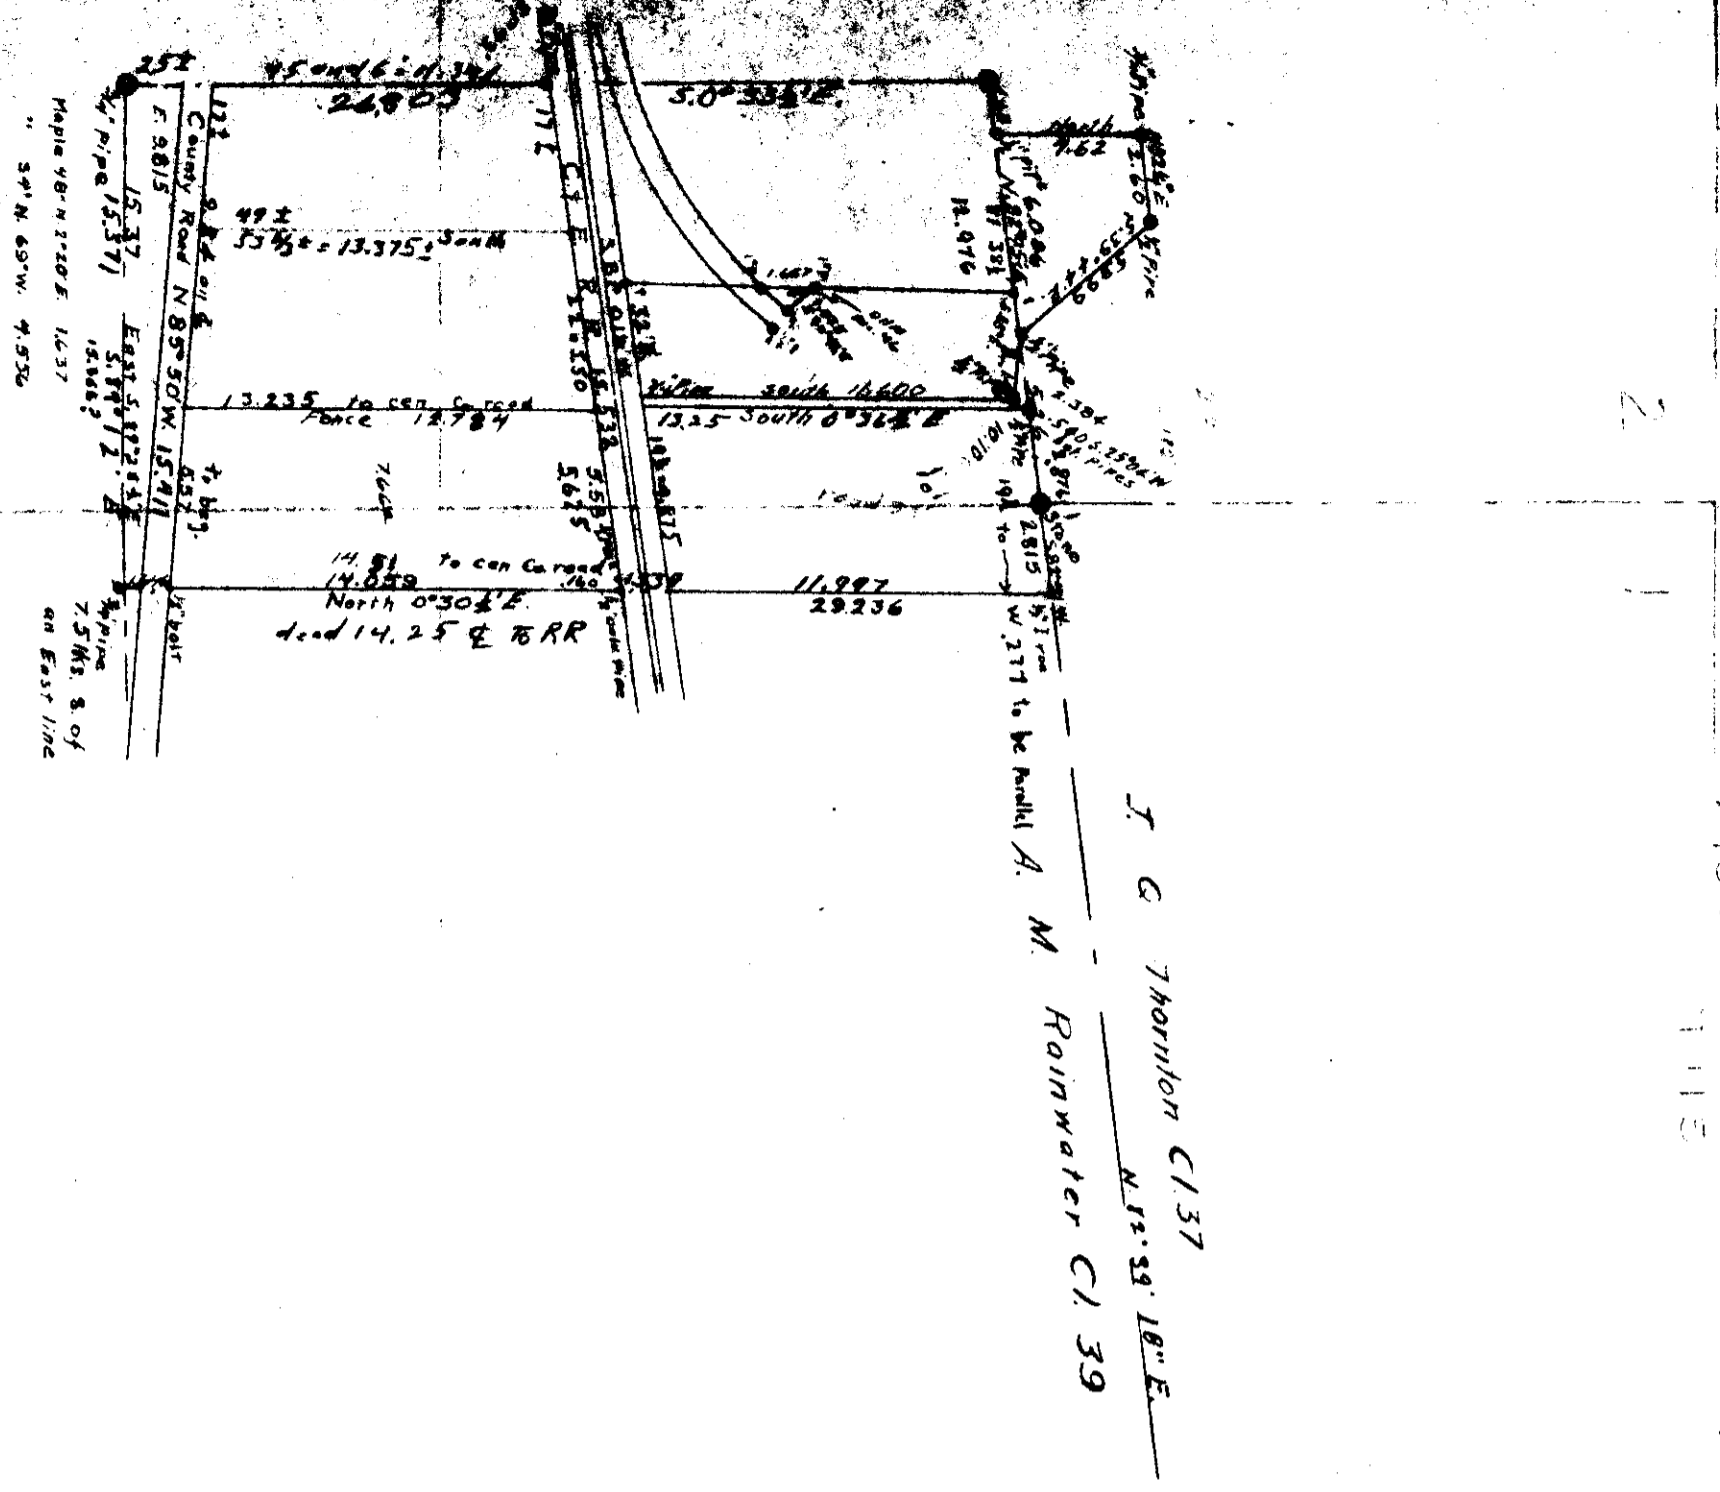

J. G. Thornton C/37
 N 12° 59' 18\"/>

COUNTY SURVEY #279
 A.M. Rainwater C/39, Sec. 1
 T.11S.R4W.

Scale 1" = 60 ft.

W.C. Galloway C.E.
 June 19, 1919.

R 4 W
 N 3 W

R 4 W
 N 3 W