


11-A
7,8,17,18

00010

C.S. 271

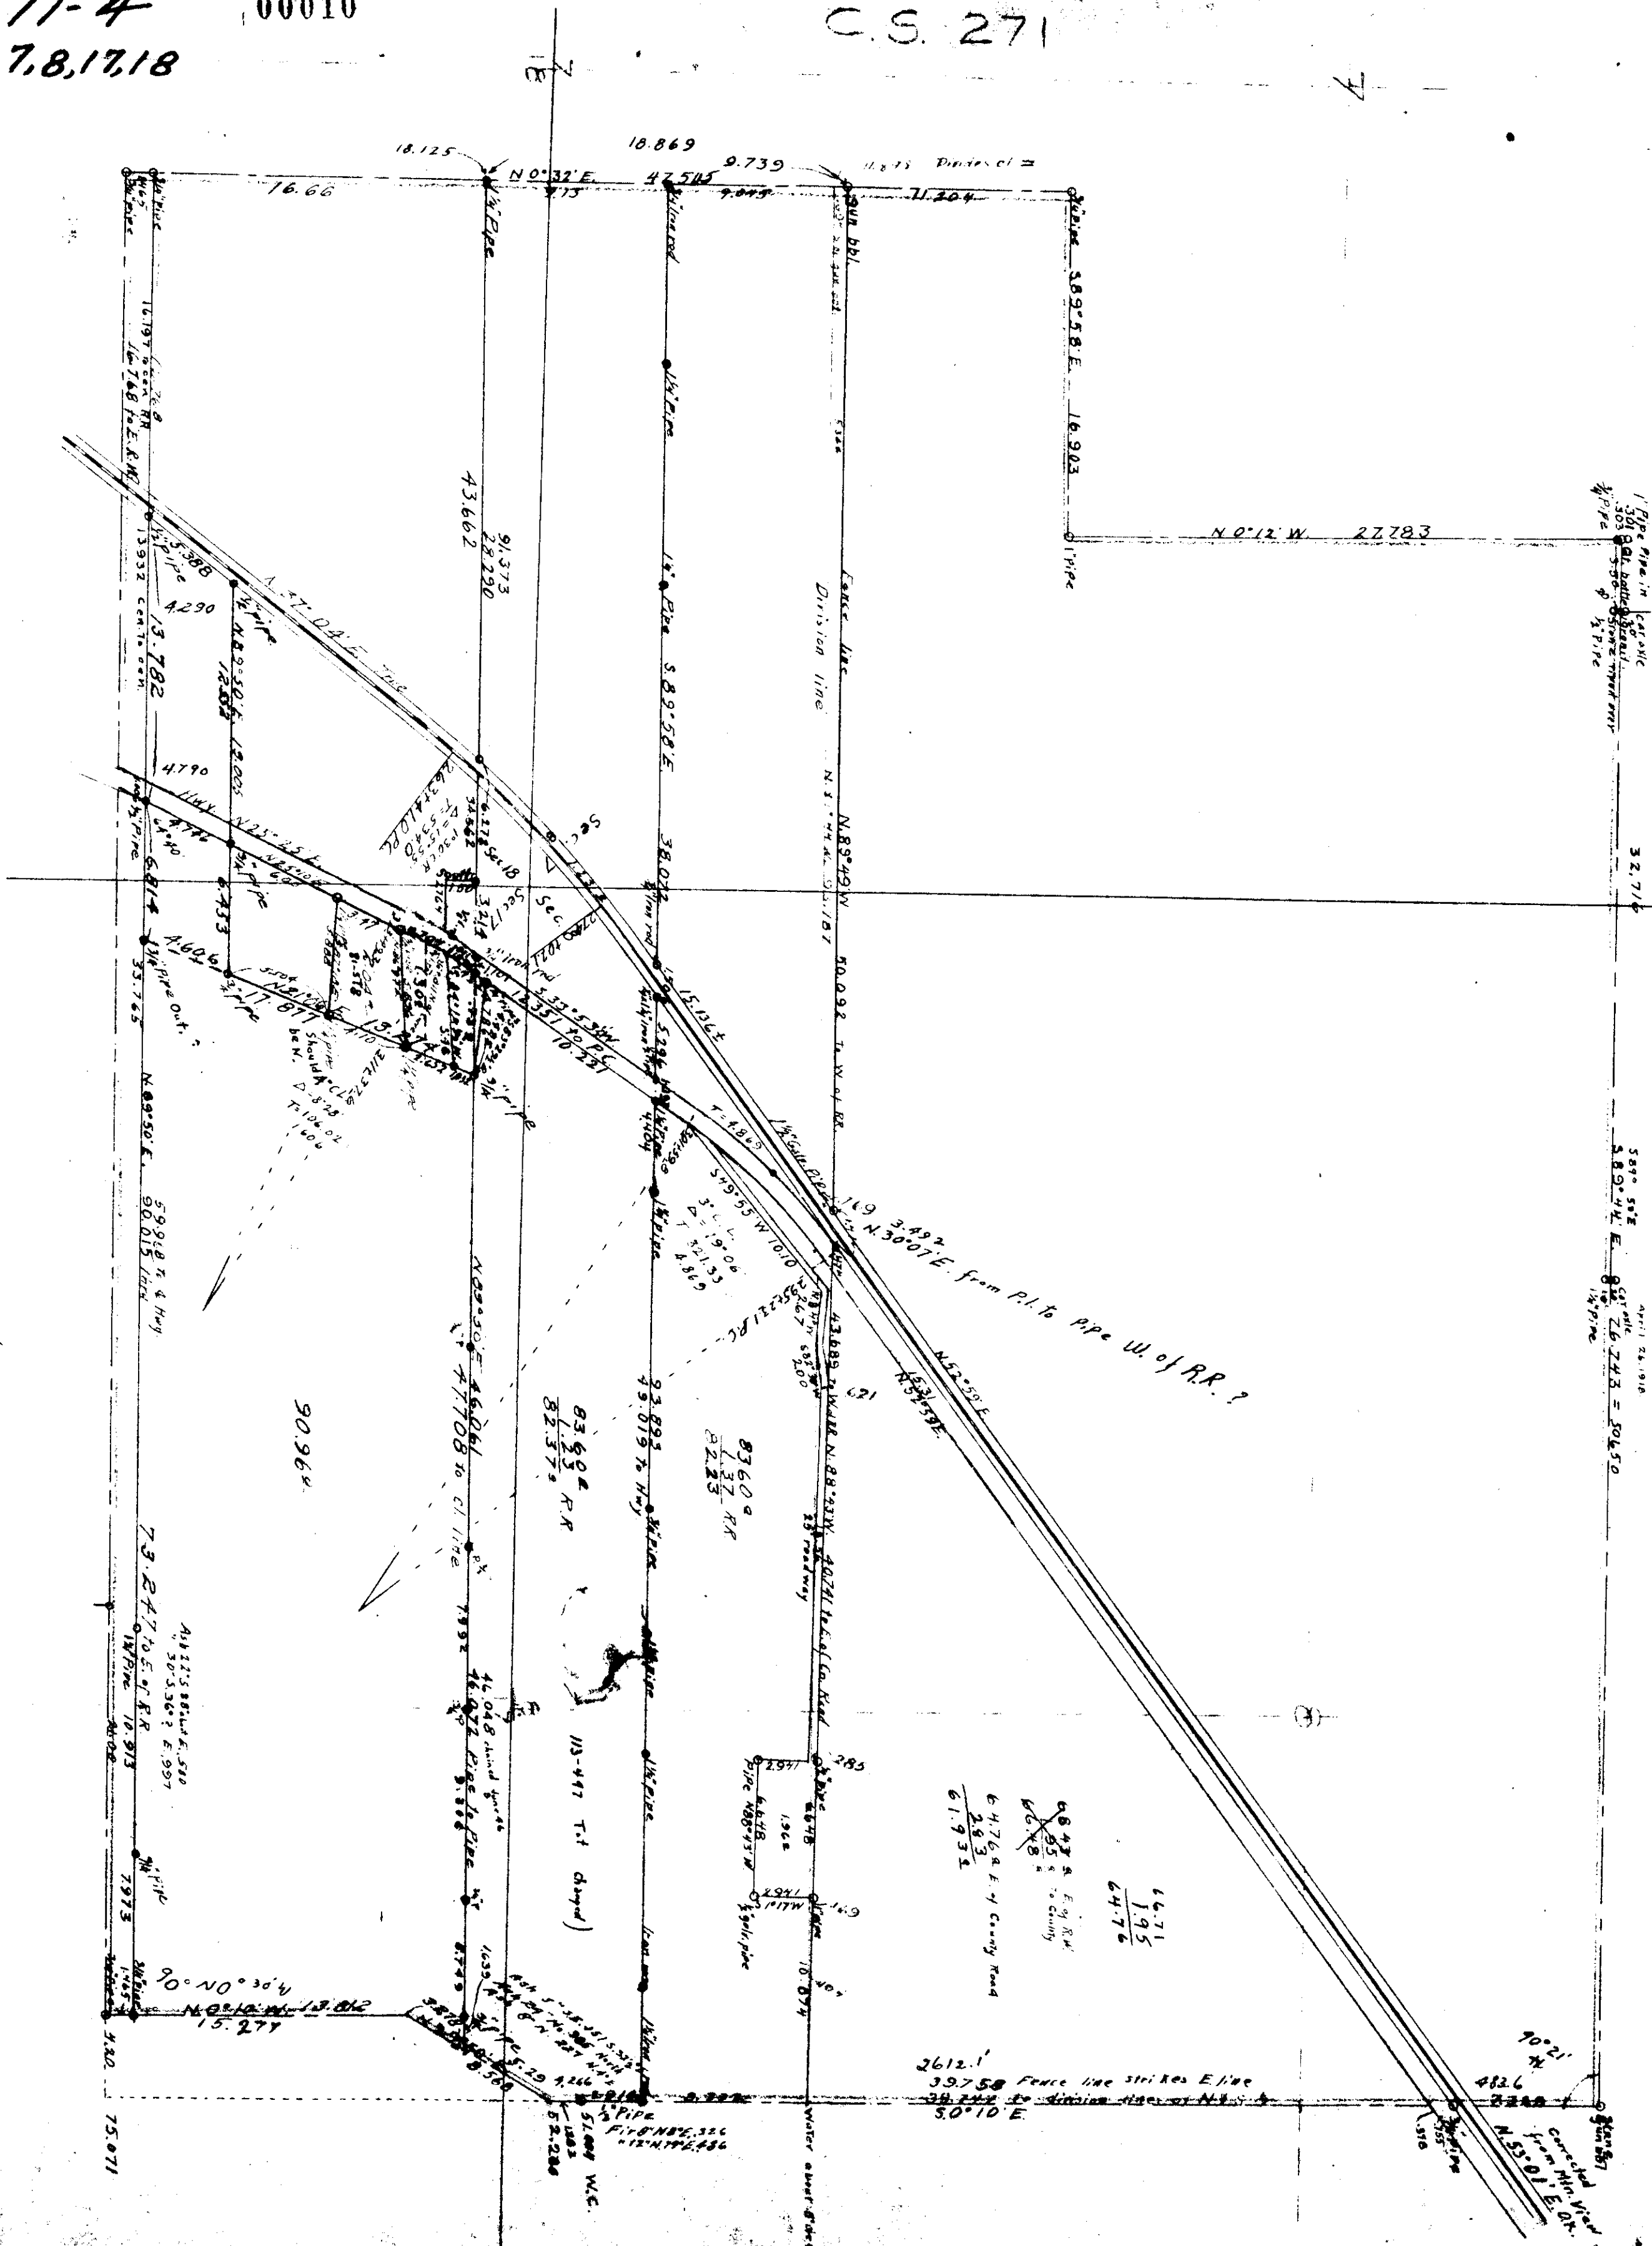

COUNTY SURVEY # 271
 Wm Taylor C146
 T11S R4W Will Mer.
 Scale 1" = 60 CHS.

W.C. Galloway C.S.
 April 24, 1918
 58° 50' E 50.015
 82° 44' E 50.015
 82° 44' E 50.015
 82° 44' E 50.015

6476.4 E. of County Road
 2.83
 61.931

3612.1
 39.750 Fence line strikes E line
 38.722 to division line at N 30° 10' E
 30° 10' E

90° 21'
 483.6
 222.8
 N 55° 01' E 0.0
 Connected Min View
 from this view

90.964

83.992 RR
 1.32
 82.372

83.600 RR
 1.32
 82.23

115-447 T-1 (drip)

51.004 W.C.
 1.003
 52.286

15.277
 4.00° ON 0°
 15.277
 75.071

73.847 to E. of RR
 10.873
 7973
 1945

50.015
 50.015
 50.015
 50.015

4.290
 13.782
 13.932 cont. to own
 13.932

16.66
 18.125
 18.869

18.869
 9.739
 71.204
 16.903
 27783
 N 0° 12' W

18.869
 9.739
 71.204
 16.903
 27783
 N 0° 12' W

119 3.492
 N 30° 07' E from P.I. to Pipe U. of RR?
 43.889
 40.211
 40.211
 40.211

297
 1.902
 1.902
 1.902

297
 1.902
 1.902
 1.902