


11-4 00011

17&18

C.S 133 TILSRAN

Scale: 1"=100fts

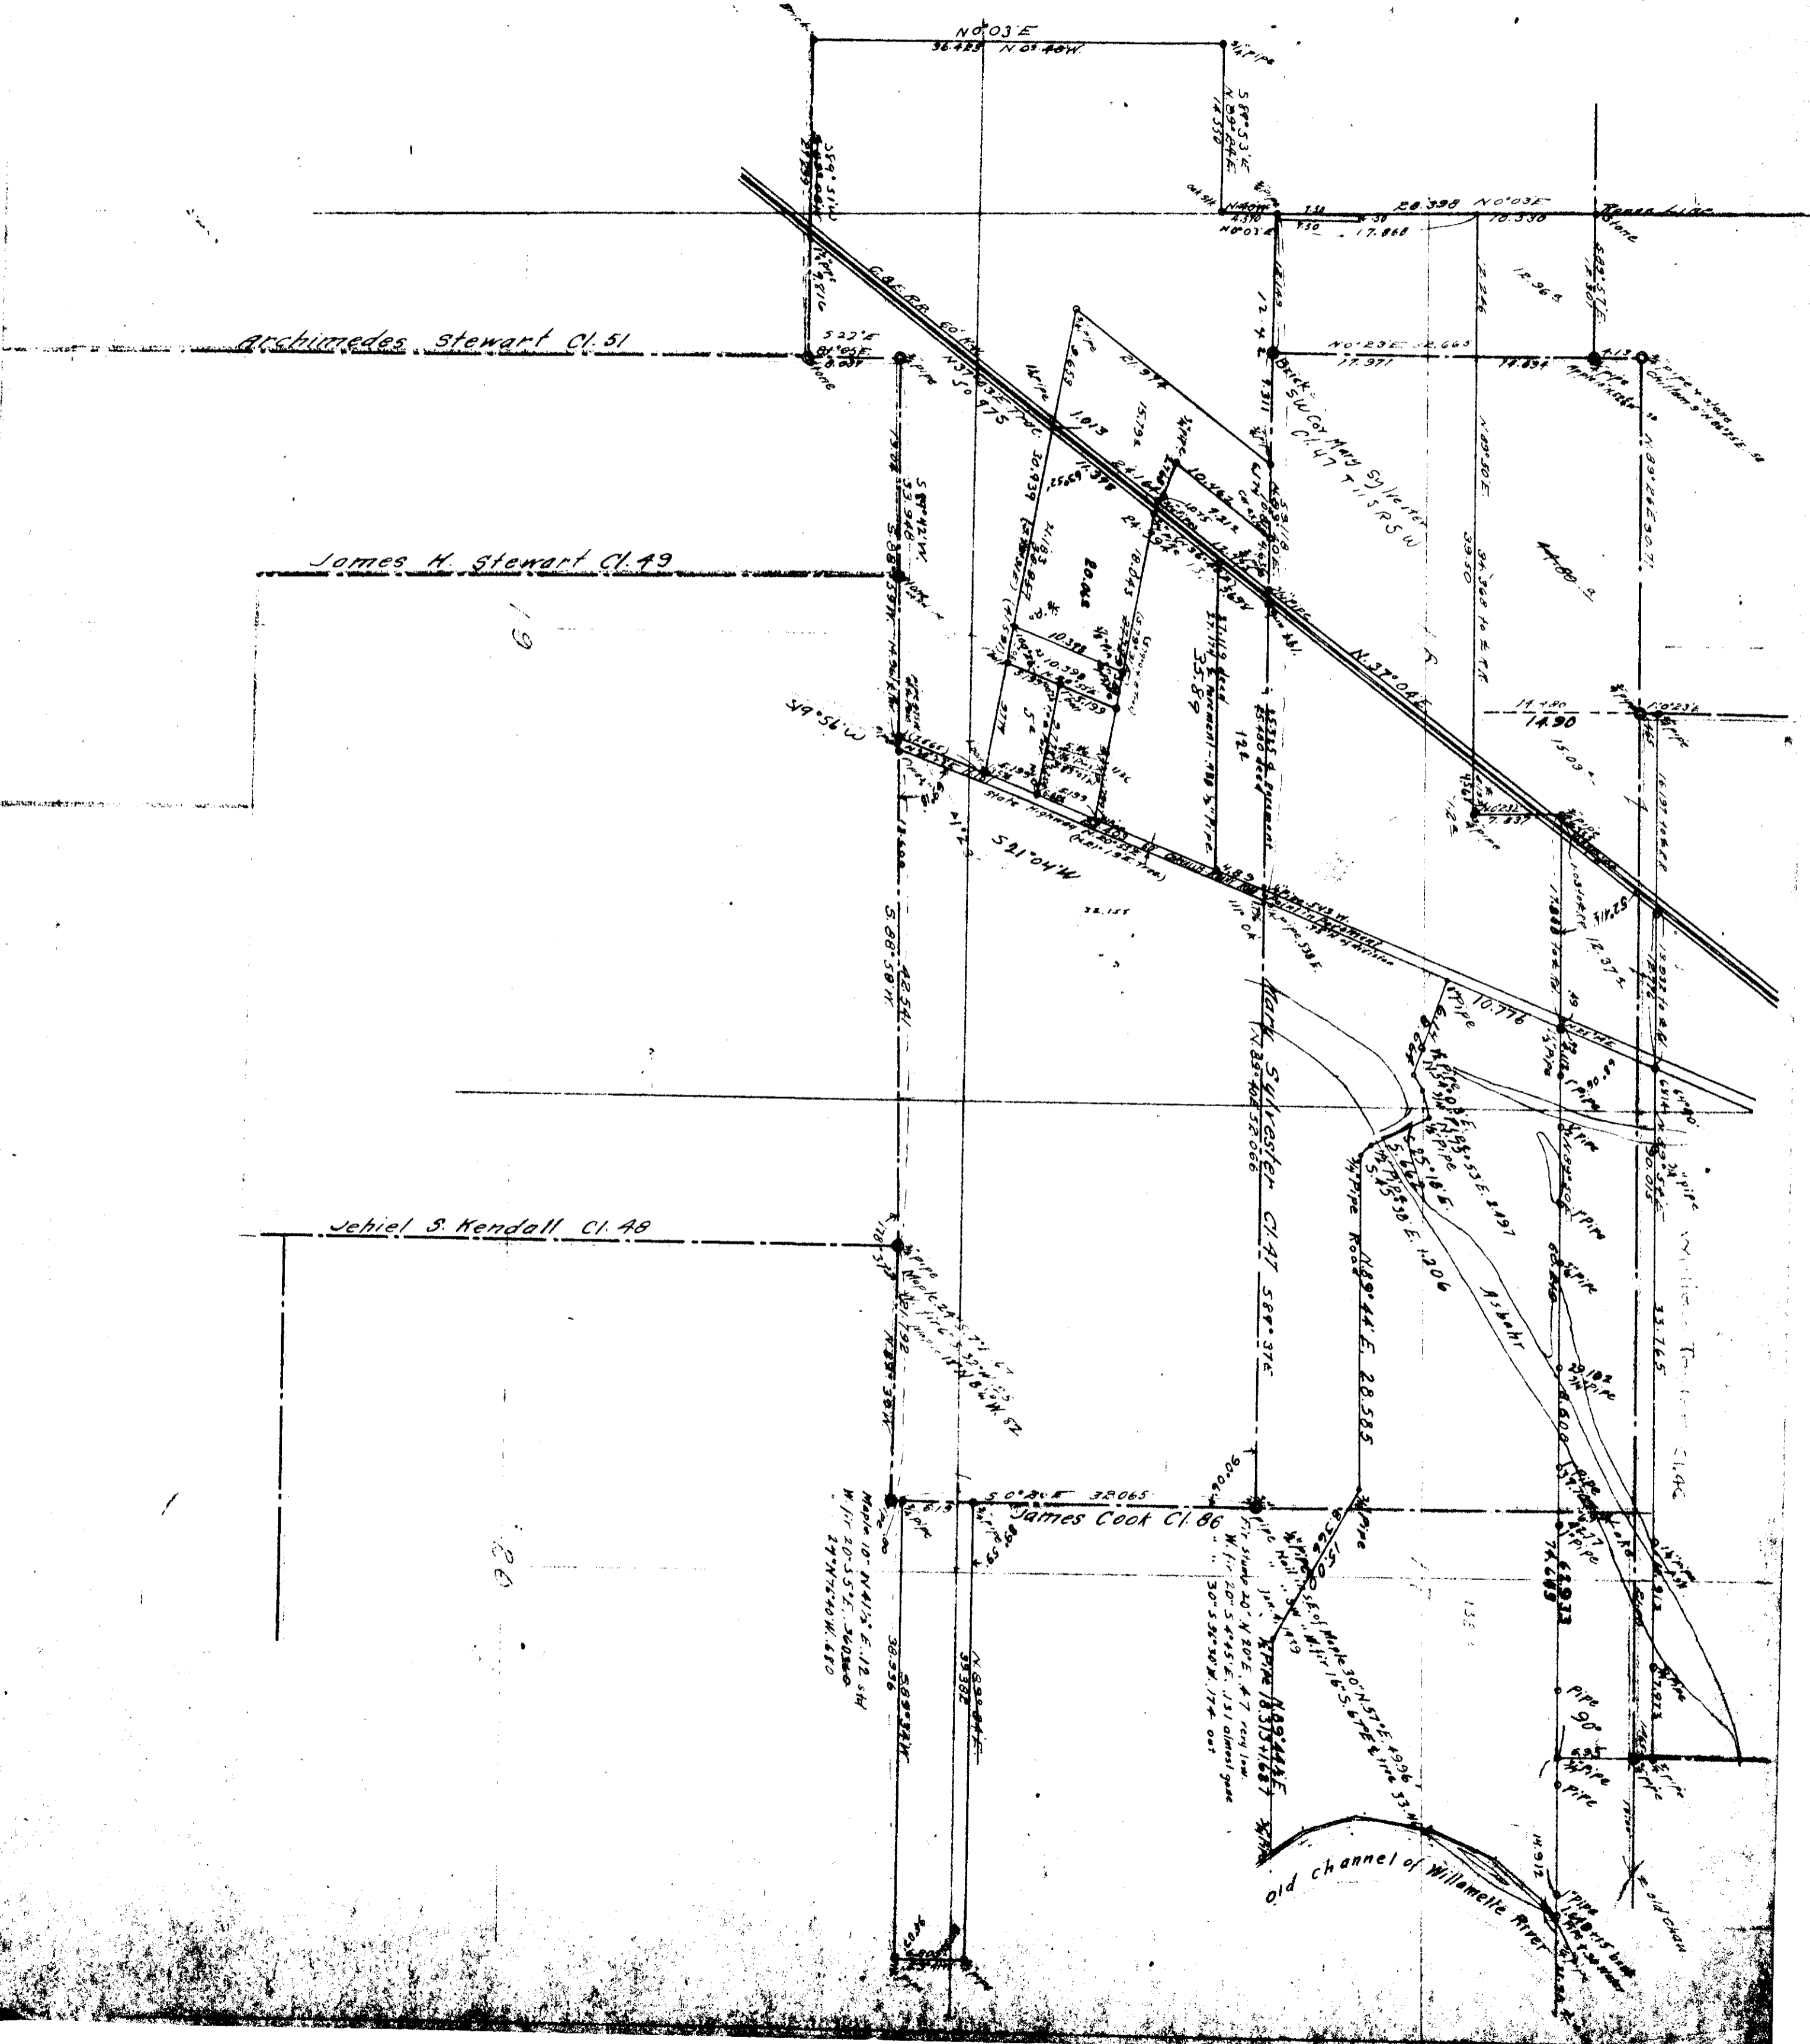

Archimedes Stewart Cl. 51

James H. Stewart Cl. 49

Jehiel S. Kendall Cl. 48

James Cook Cl. 86

old channel of Willamette River

61

82

Made 10' N 41' E 12.5 ft
 W 1' 20' S 5' E 560.00
 14' N 74' W 480

W 1' 20' S 4' 45' E 131 almost gone
 30' S 54' 30' W 174 out

PIPE 90'

PIPE 150'

PIPE 200'

PIPE 250'

PIPE 300'

PIPE 350'

PIPE 400'

PIPE 450'

PIPE 500'

PIPE 550'

PIPE 600'

PIPE 650'

PIPE 700'

PIPE 750'

PIPE 800'

PIPE 850'

PIPE 900'

PIPE 950'

PIPE 1000'