


(PLATTED)

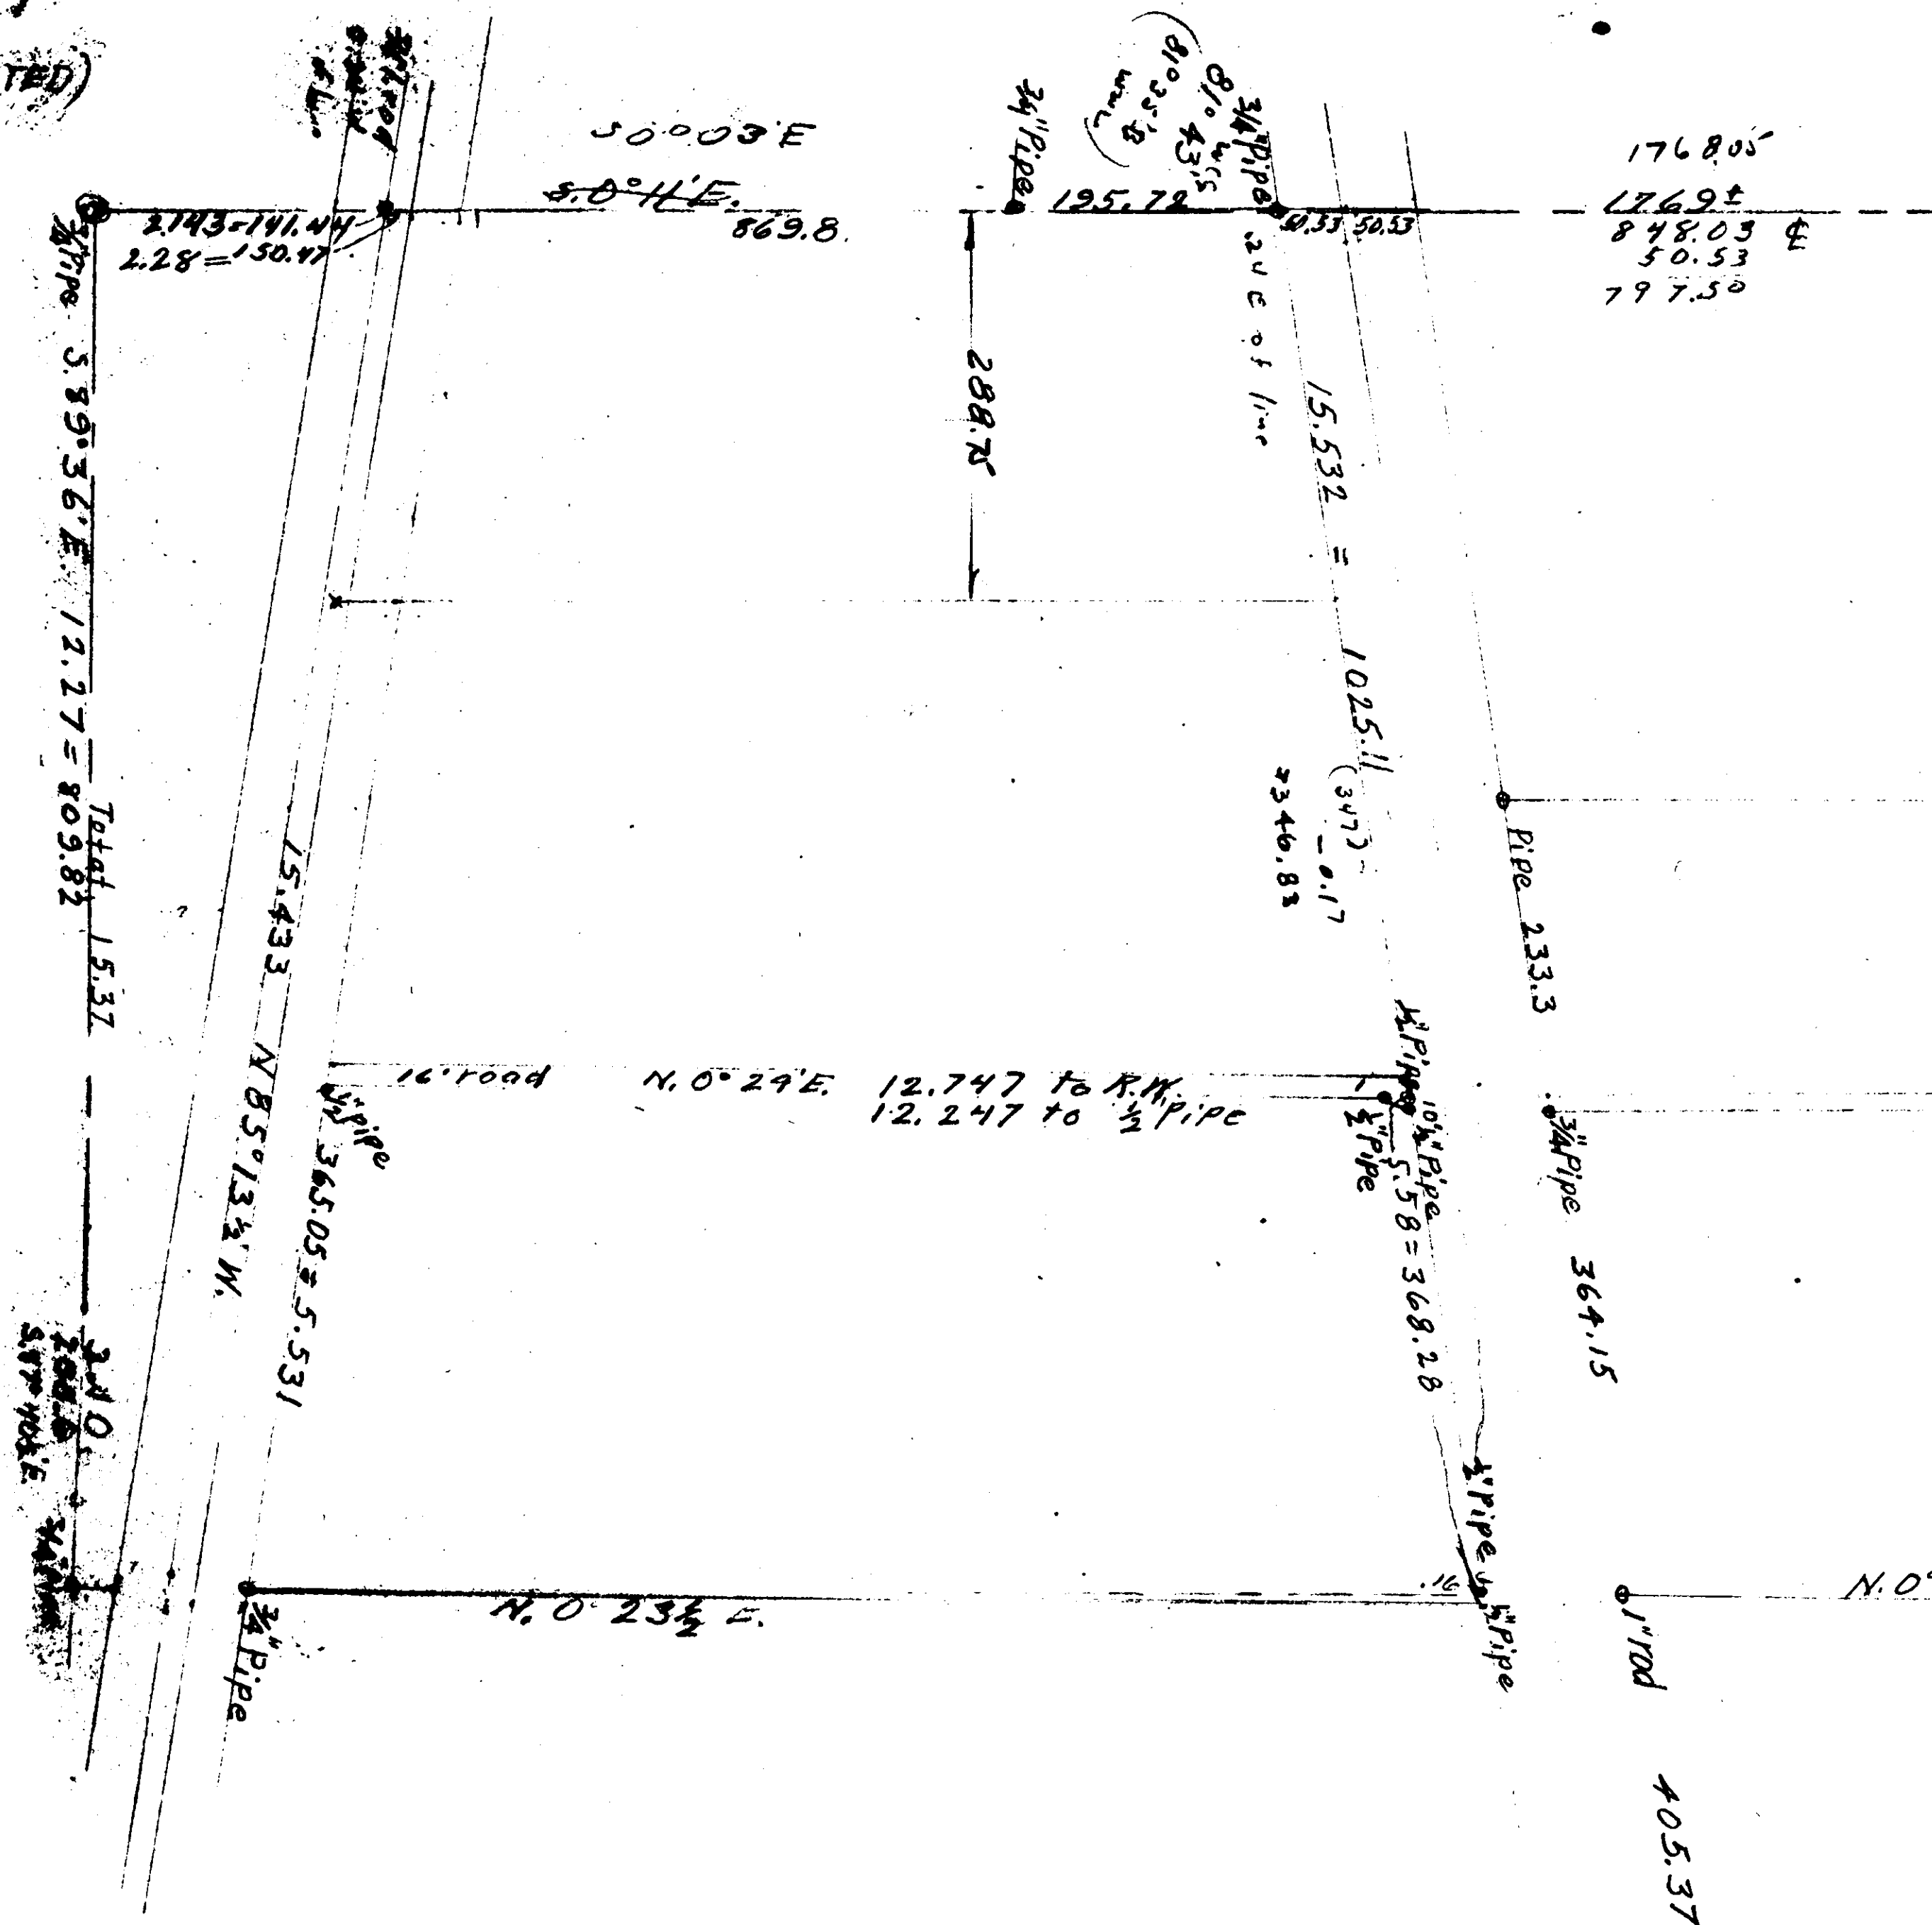

RECORDED

INDEXED

N. 81° 32' E.