

11-5  
12+13


00008

COUNTY SUR

Secs. 1, 12 & 13

Scale 1" = 100 ft

Price Fuller cl. 37

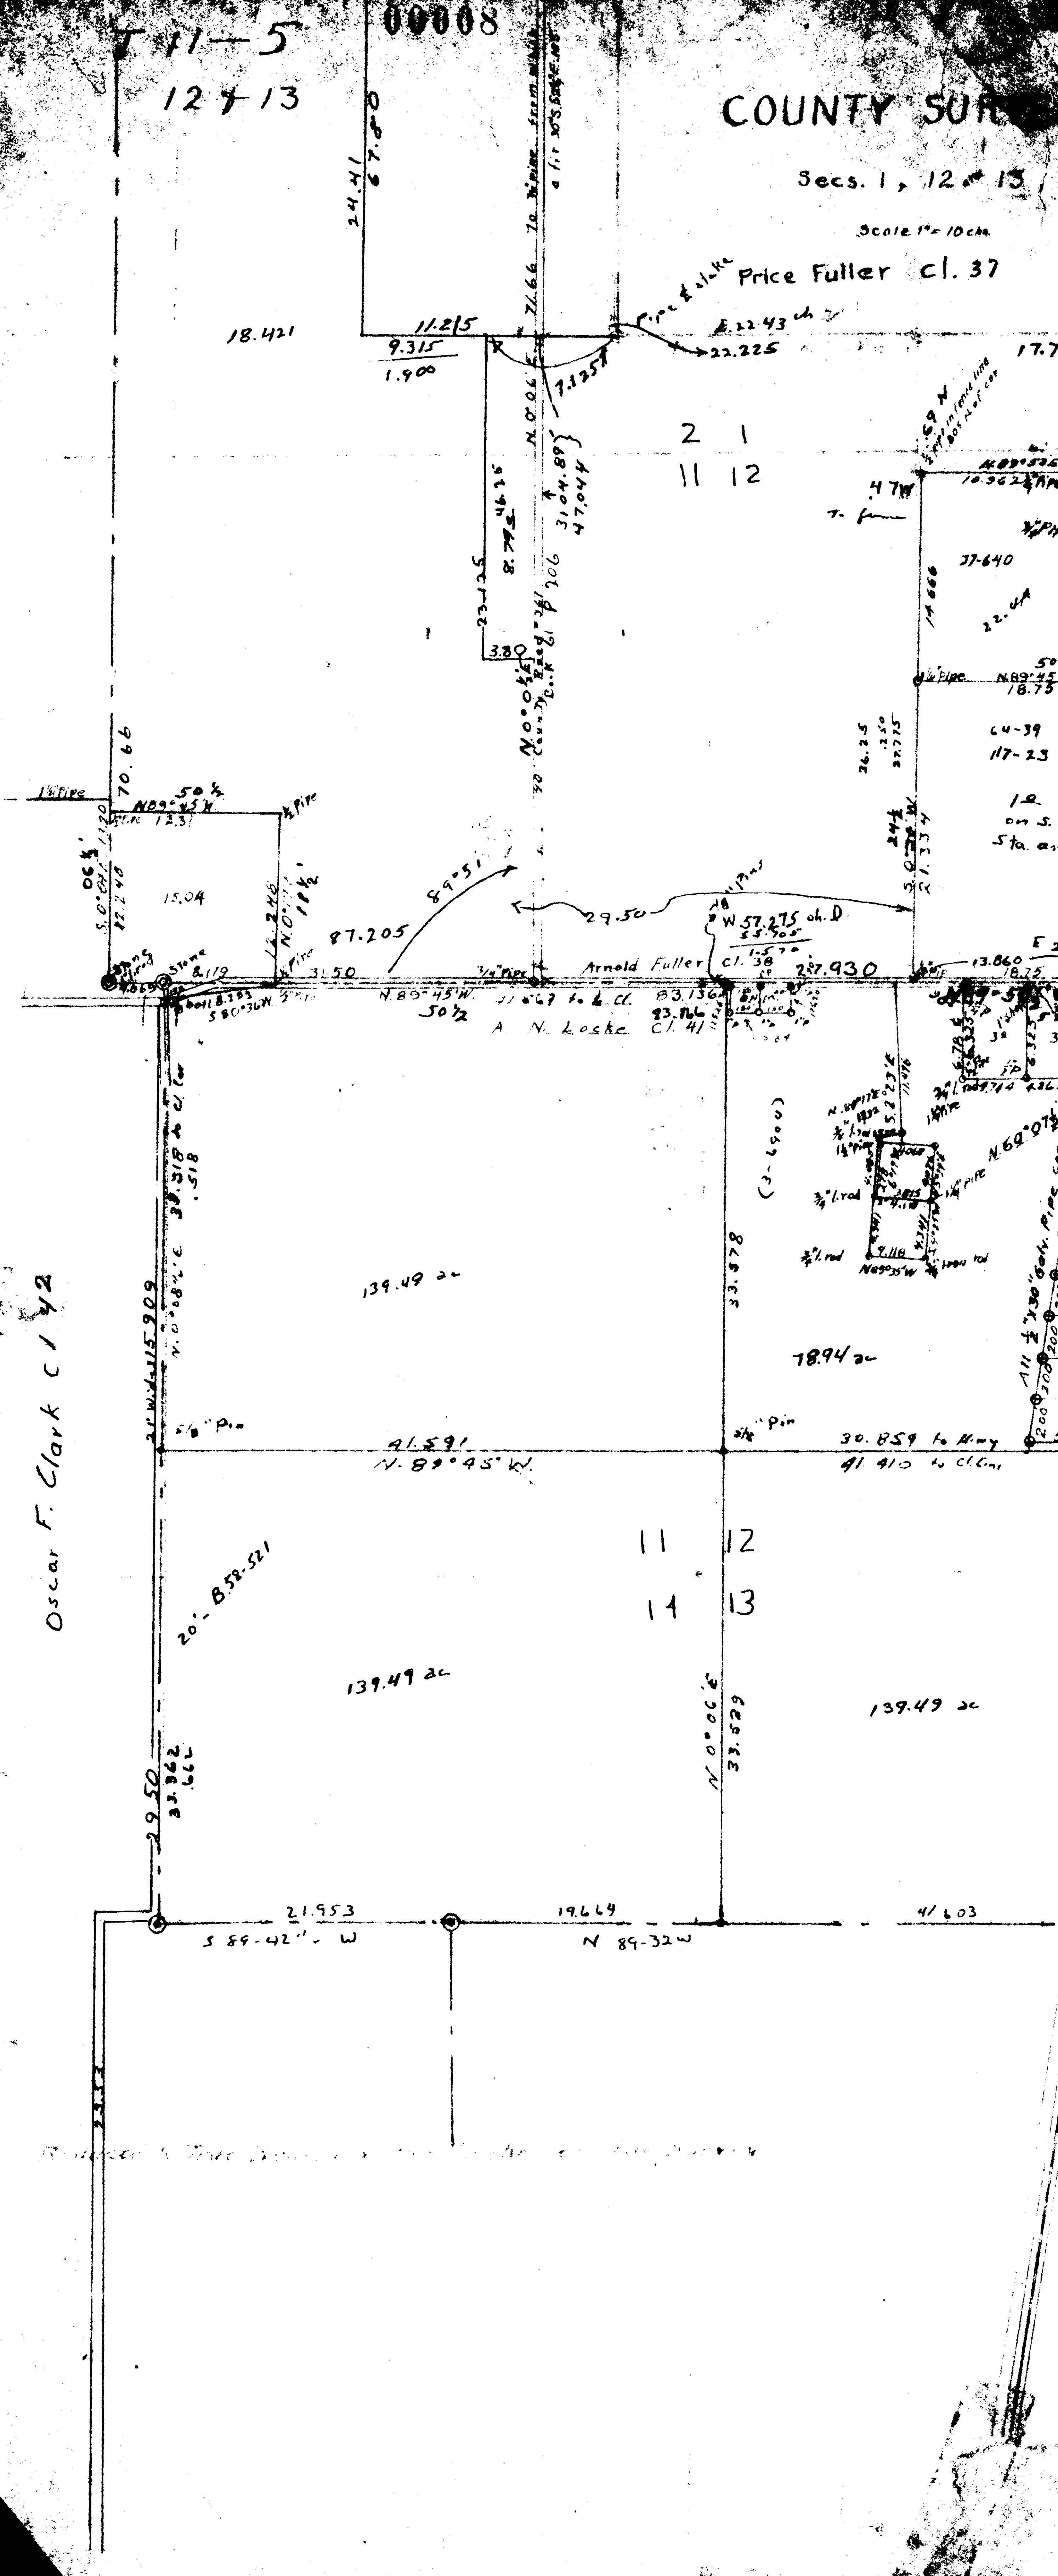

Oscar F. Clark C 1 42

20- B. 58-521

11 12  
14 13

Resurveyed to Price Fuller...