

11-8  
22-27


00010

C.S.  
T. 115  
500

THIS LINE IS OFF  
(PLOTTED)

James L. Mulkey Jr. 65

D. B. Mulkey Cl. 6A

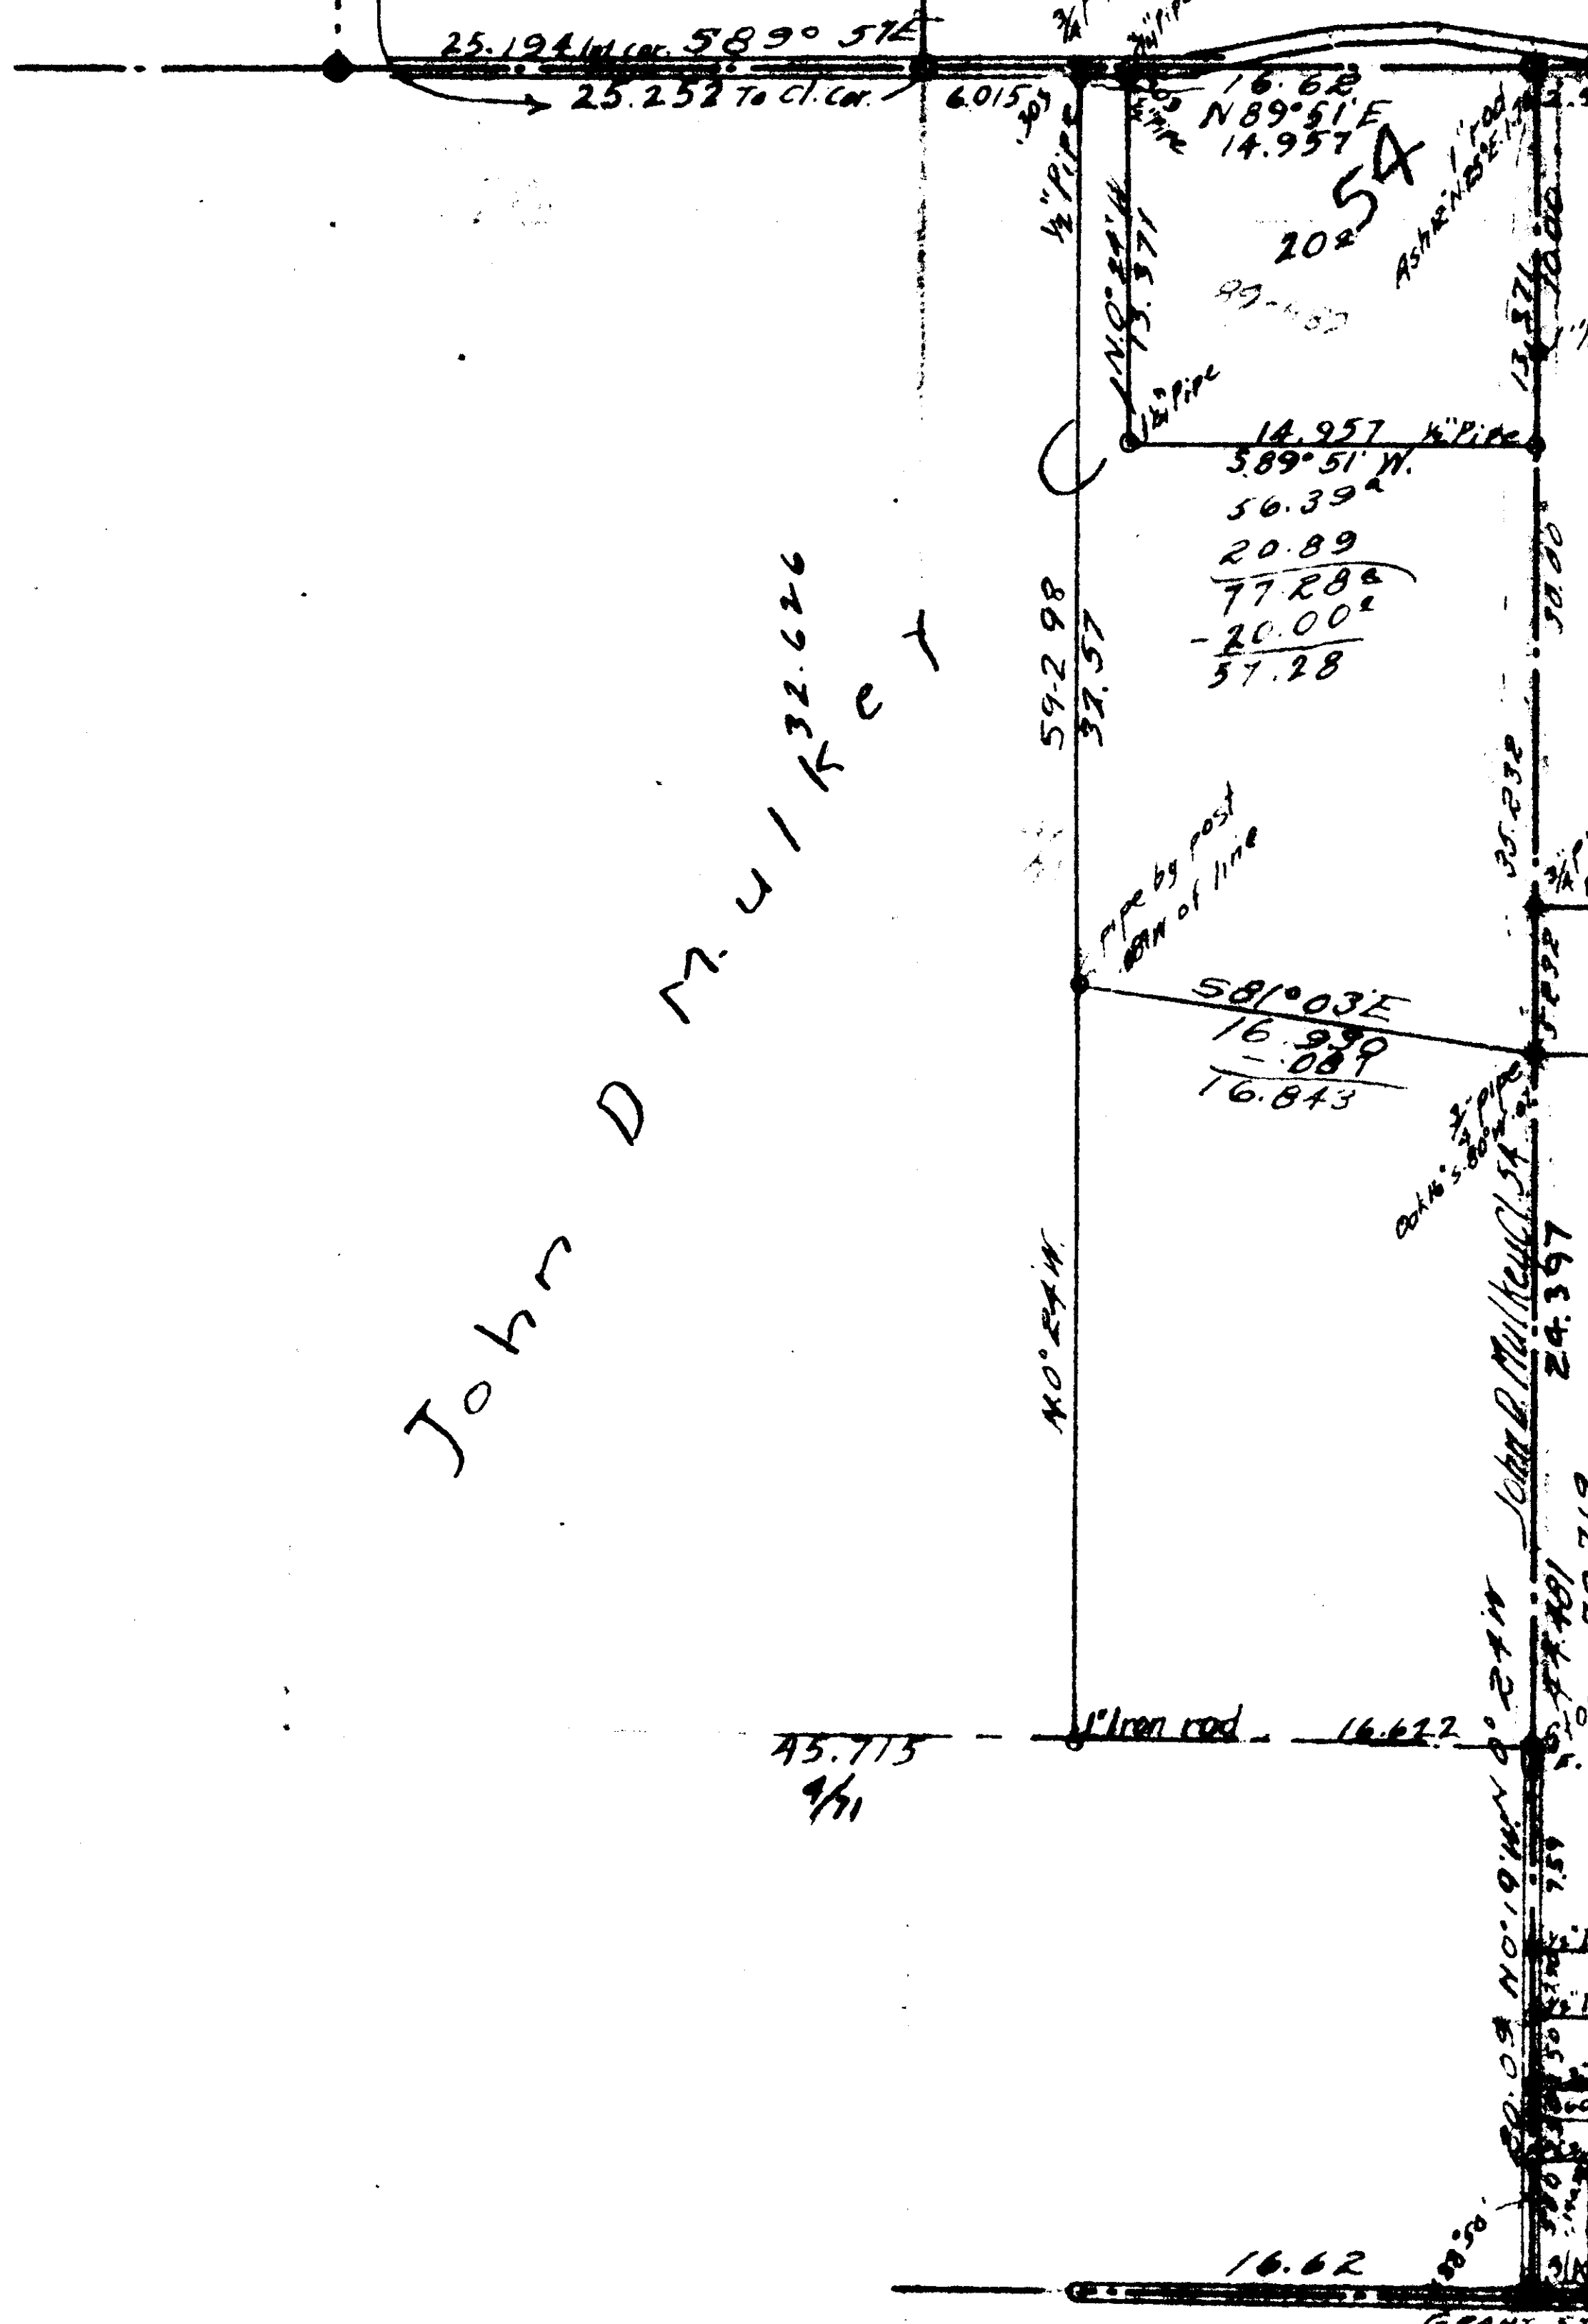

John D. Mulkey