


11-5 00026  
28

# COUNTY SURVEY No 270

Secs. 27 & 28 T. 11 S. R. 5 W.

Scale 1" = 10 chains

James L. Mulkey Sr. Cl. 63

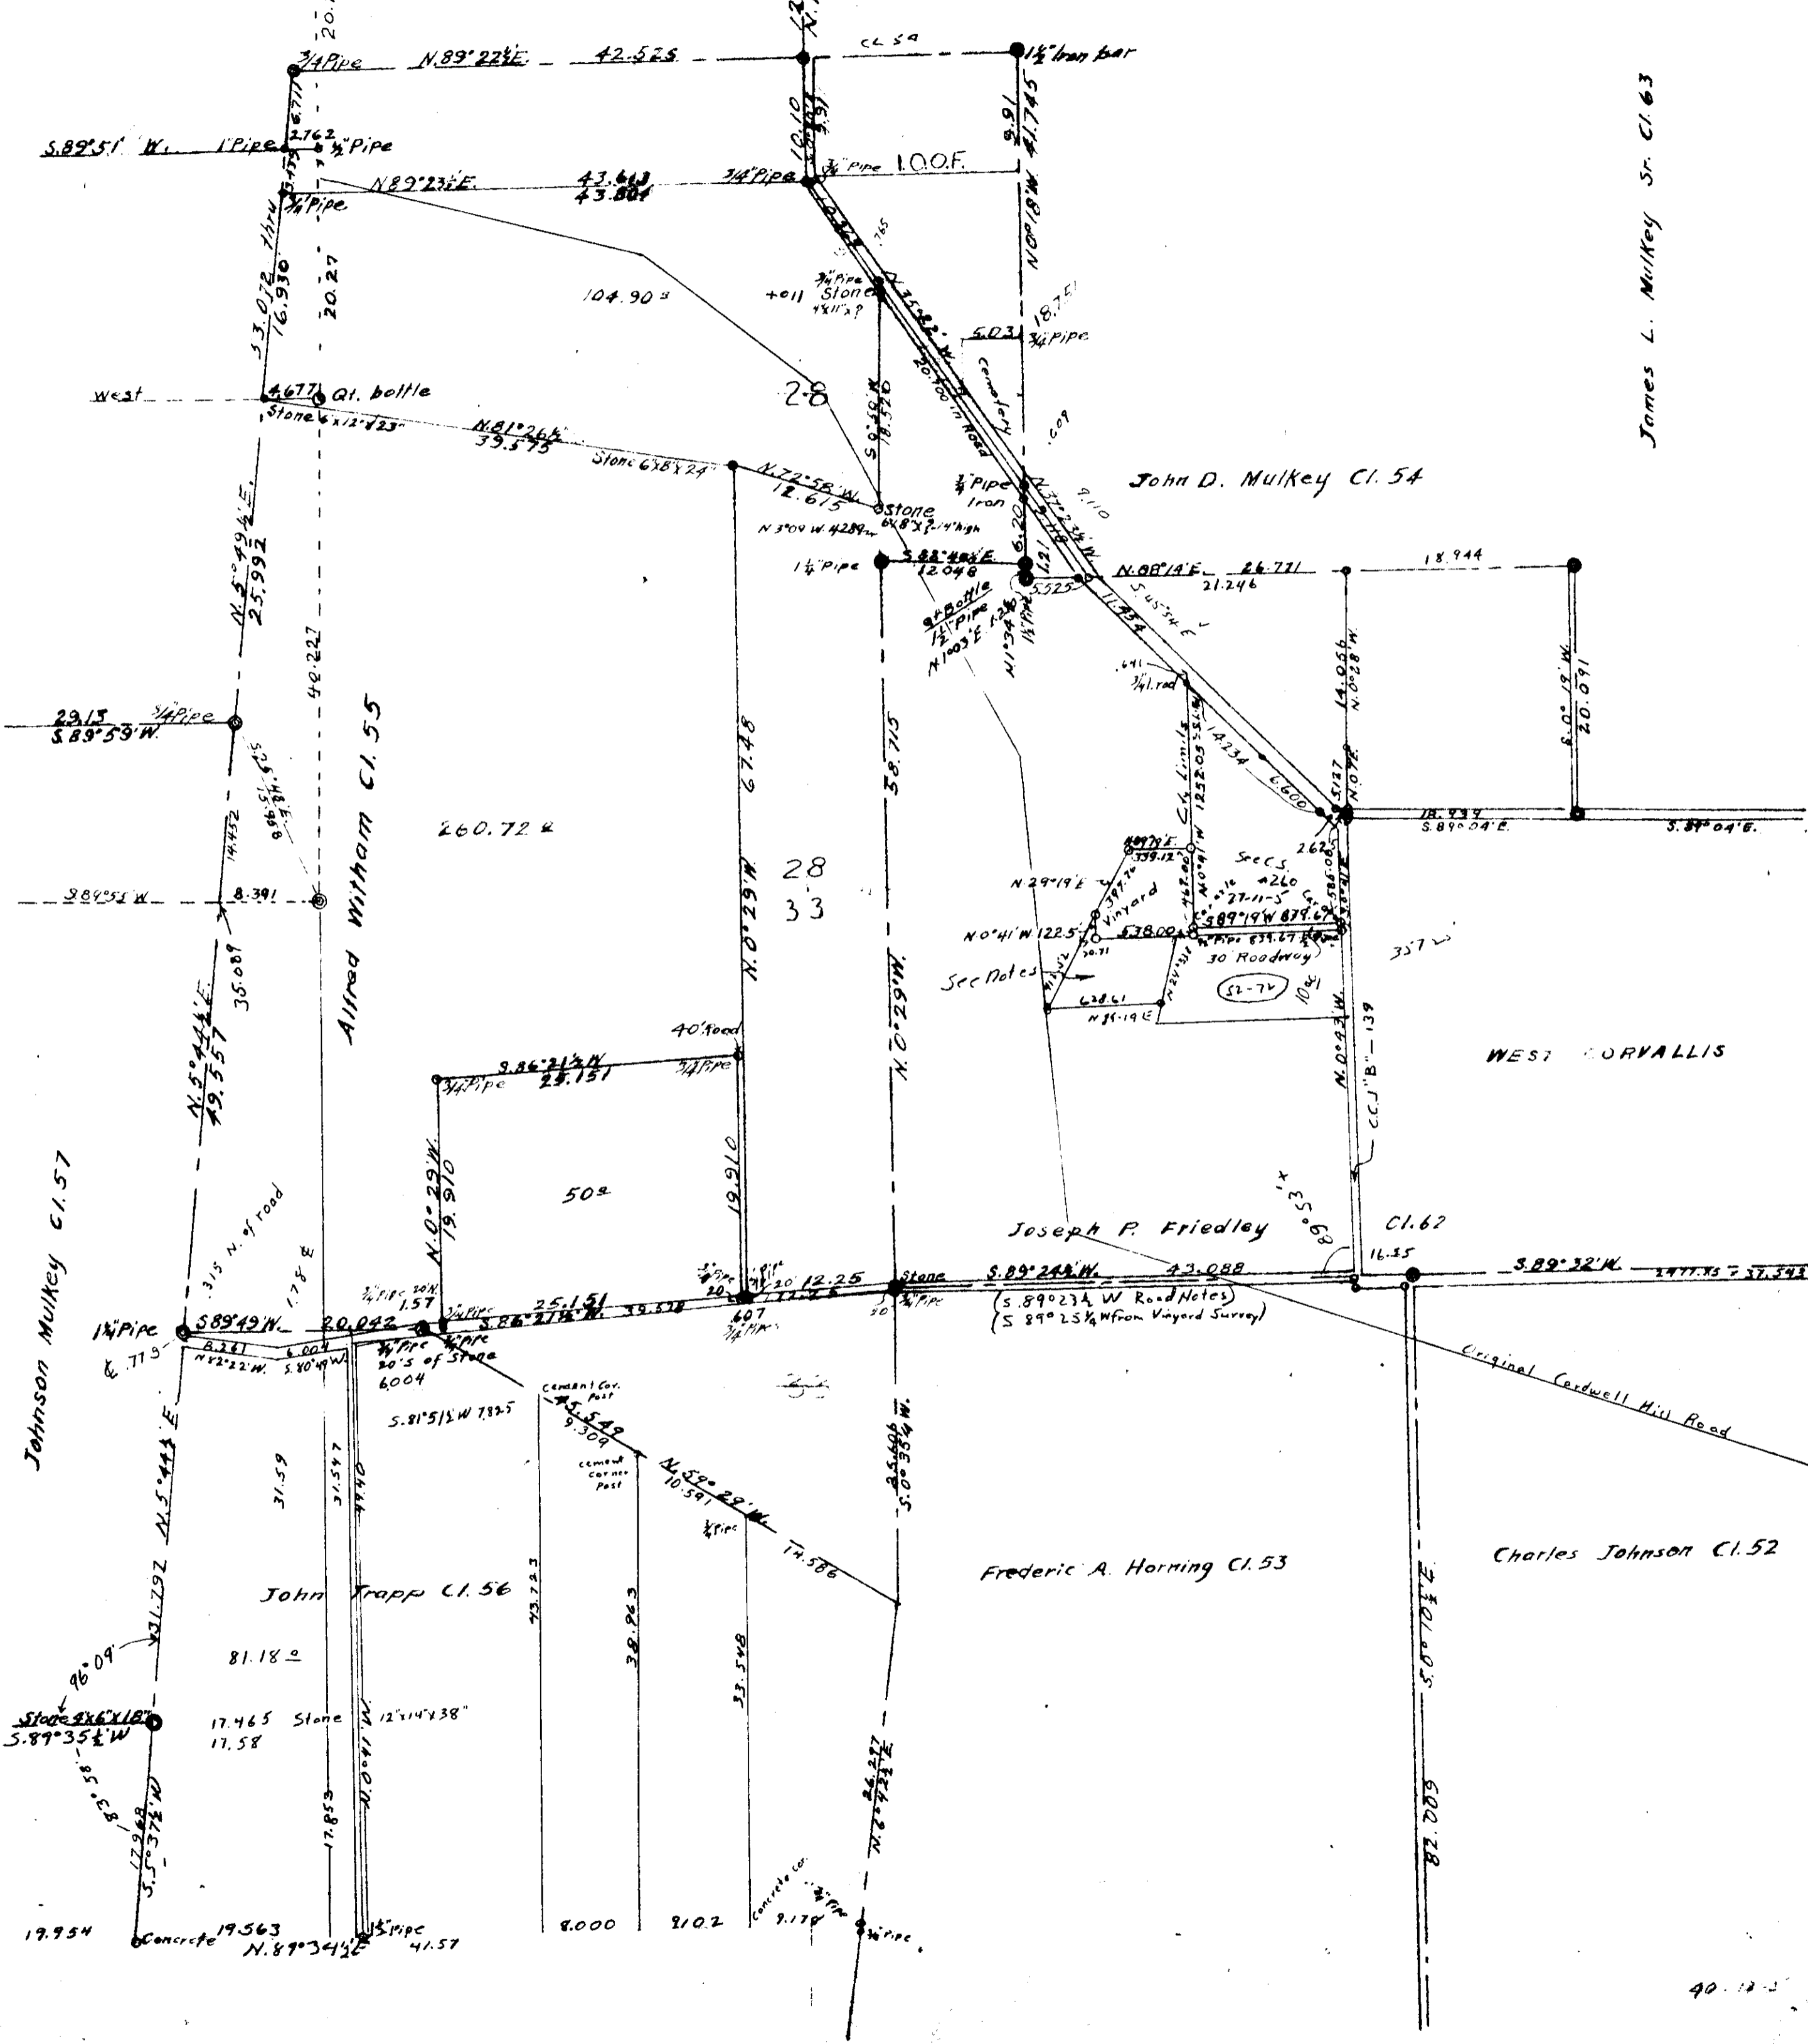

Johnson Mulkey Cl. 57

Alfred Witham Cl. 55

John Trapp Cl. 56

Frederic A. Horming Cl. 53

Joseph P. Friedley Cl. 62

John D. Mulkey Cl. 54

WEST CORVALLIS

Charles Johnson Cl. 52

Original Cardwell Hill Road