

11 - 5
34, 35, 26 & 27
Tinkham Tracts
1" = 100'


00031

C.S. 129

GRANT ST.

Toyot Bird Changed to Buchanan St

KINGS ROAD

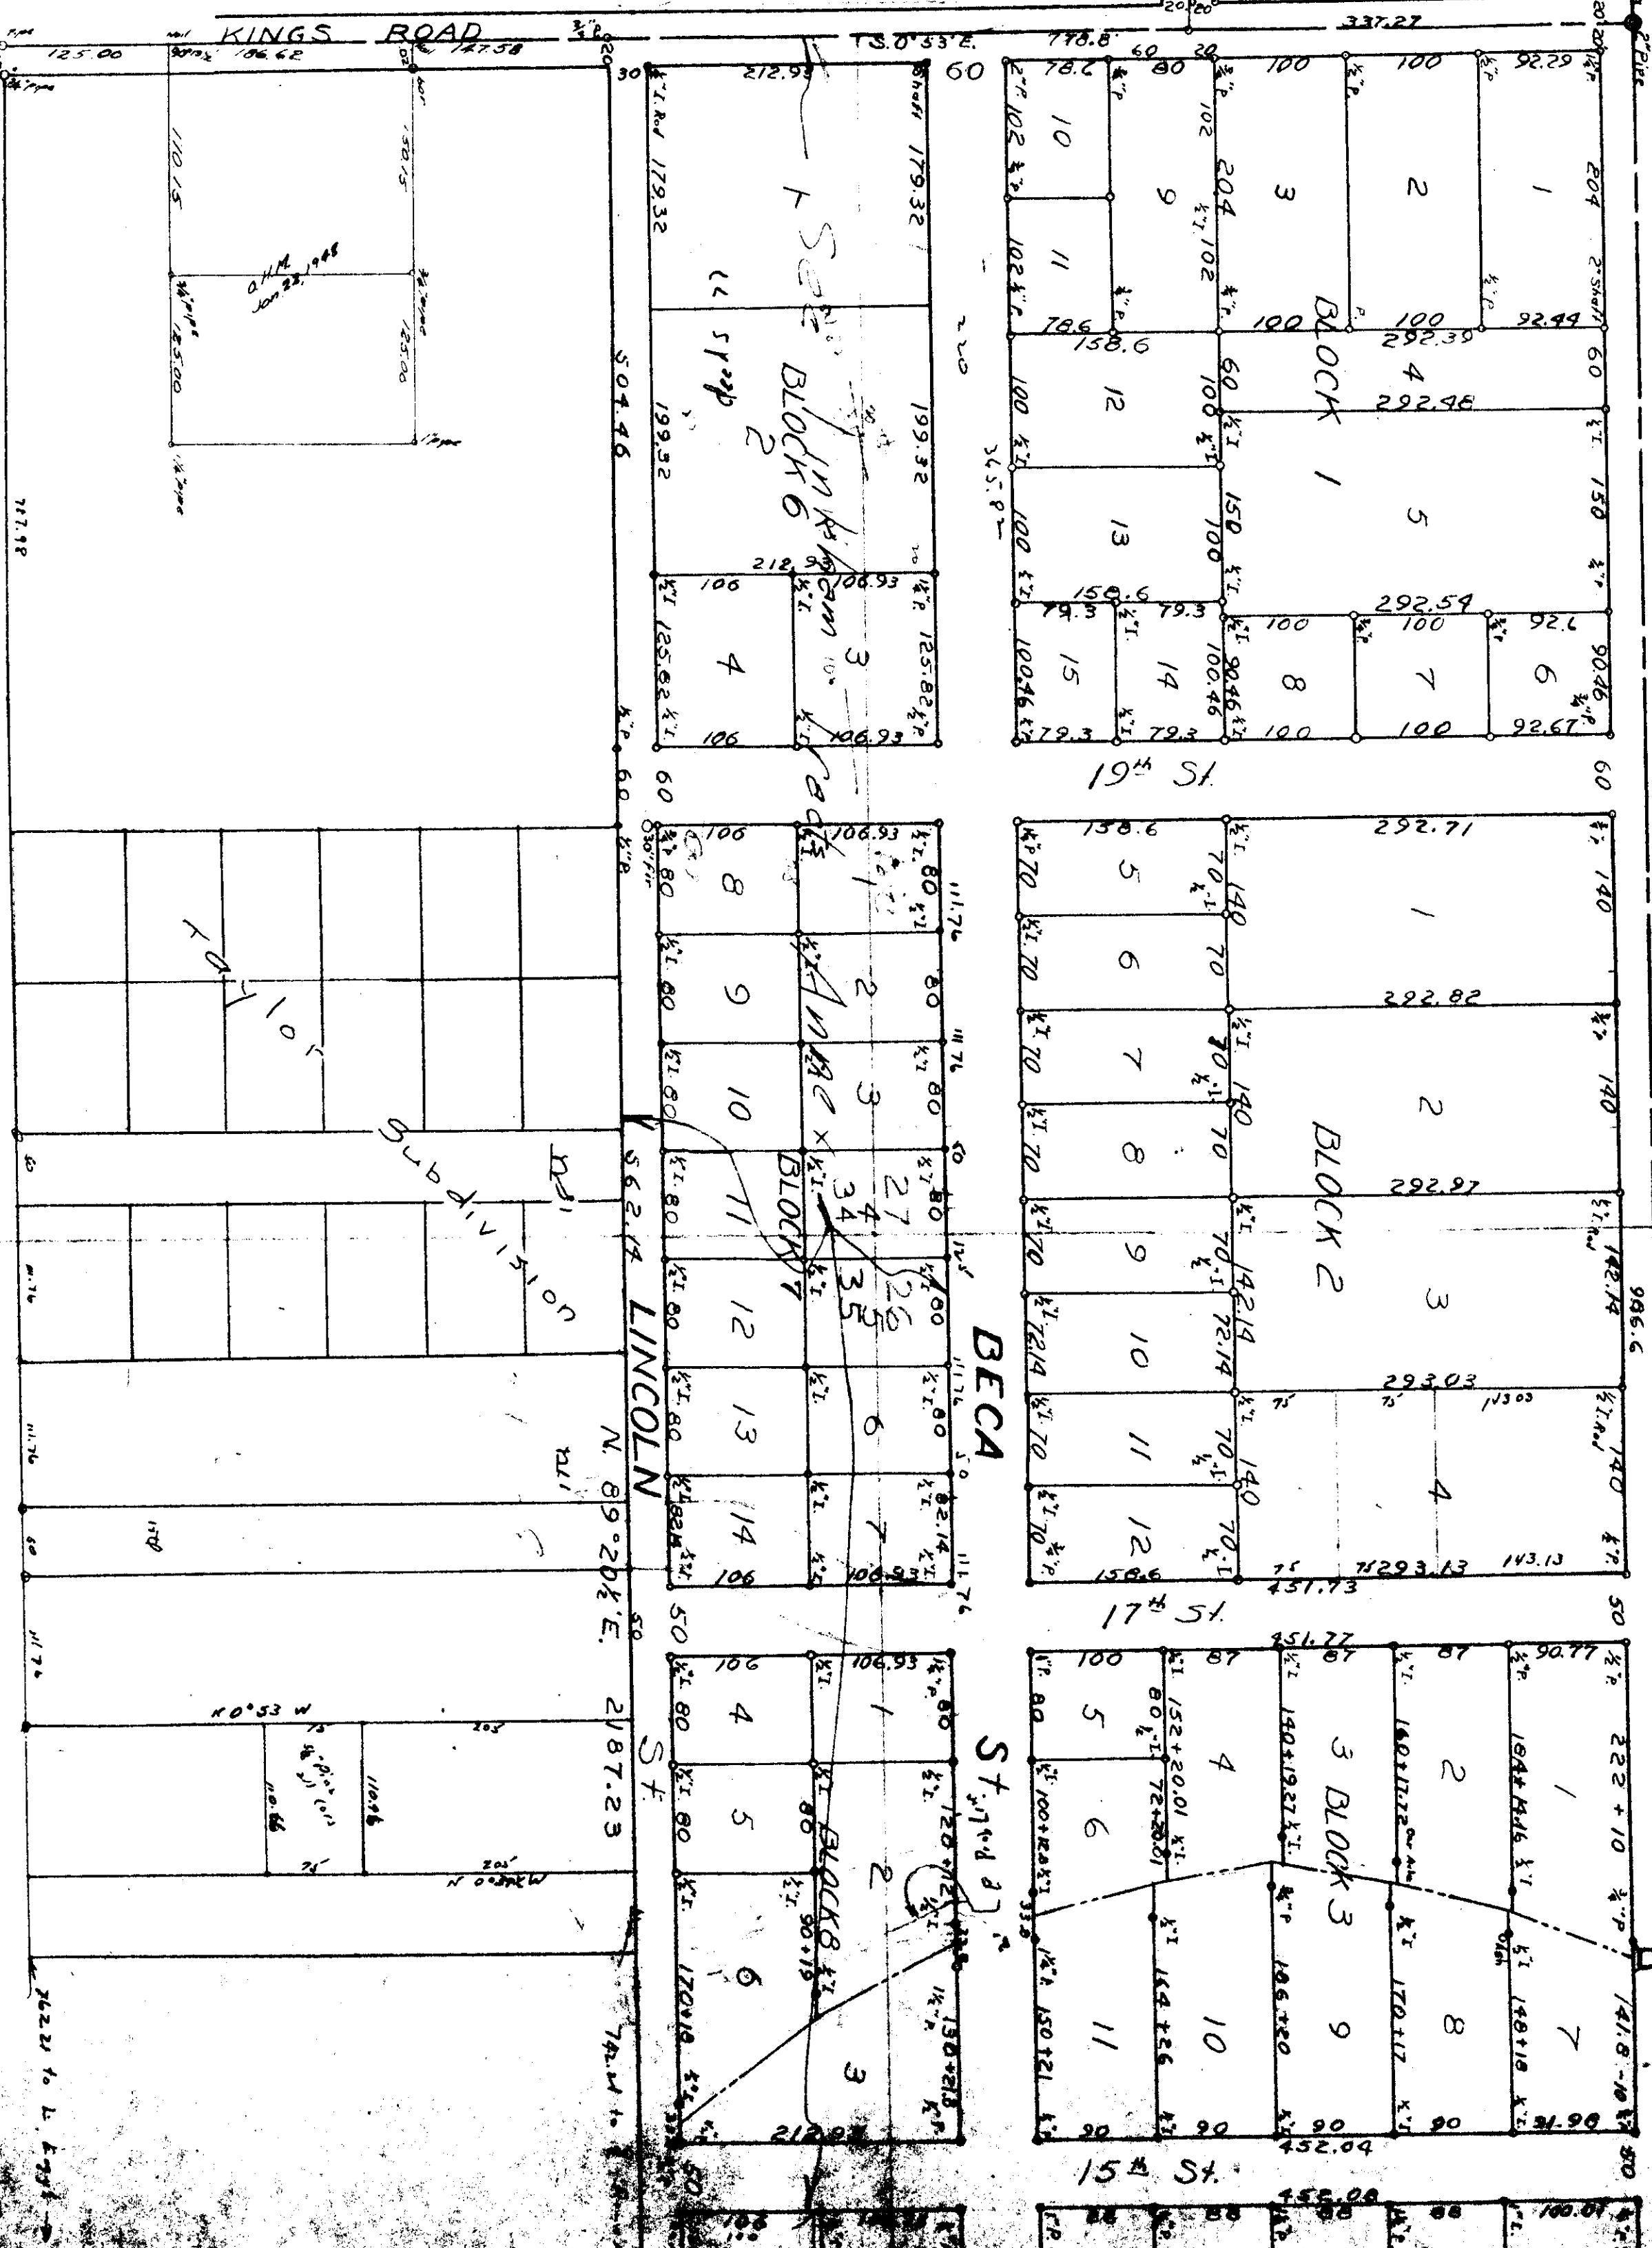

See BLOCK 6
16 strip

See BLOCK 1

See BLOCK 2

See BLOCK 3

See BLOCK 8

Subdivision

10°53 W
110.96
110.96
110.96

ST. 174.3

8.89°18' W. 2190.45