


11-7  
5,6

00002

C.S. 286

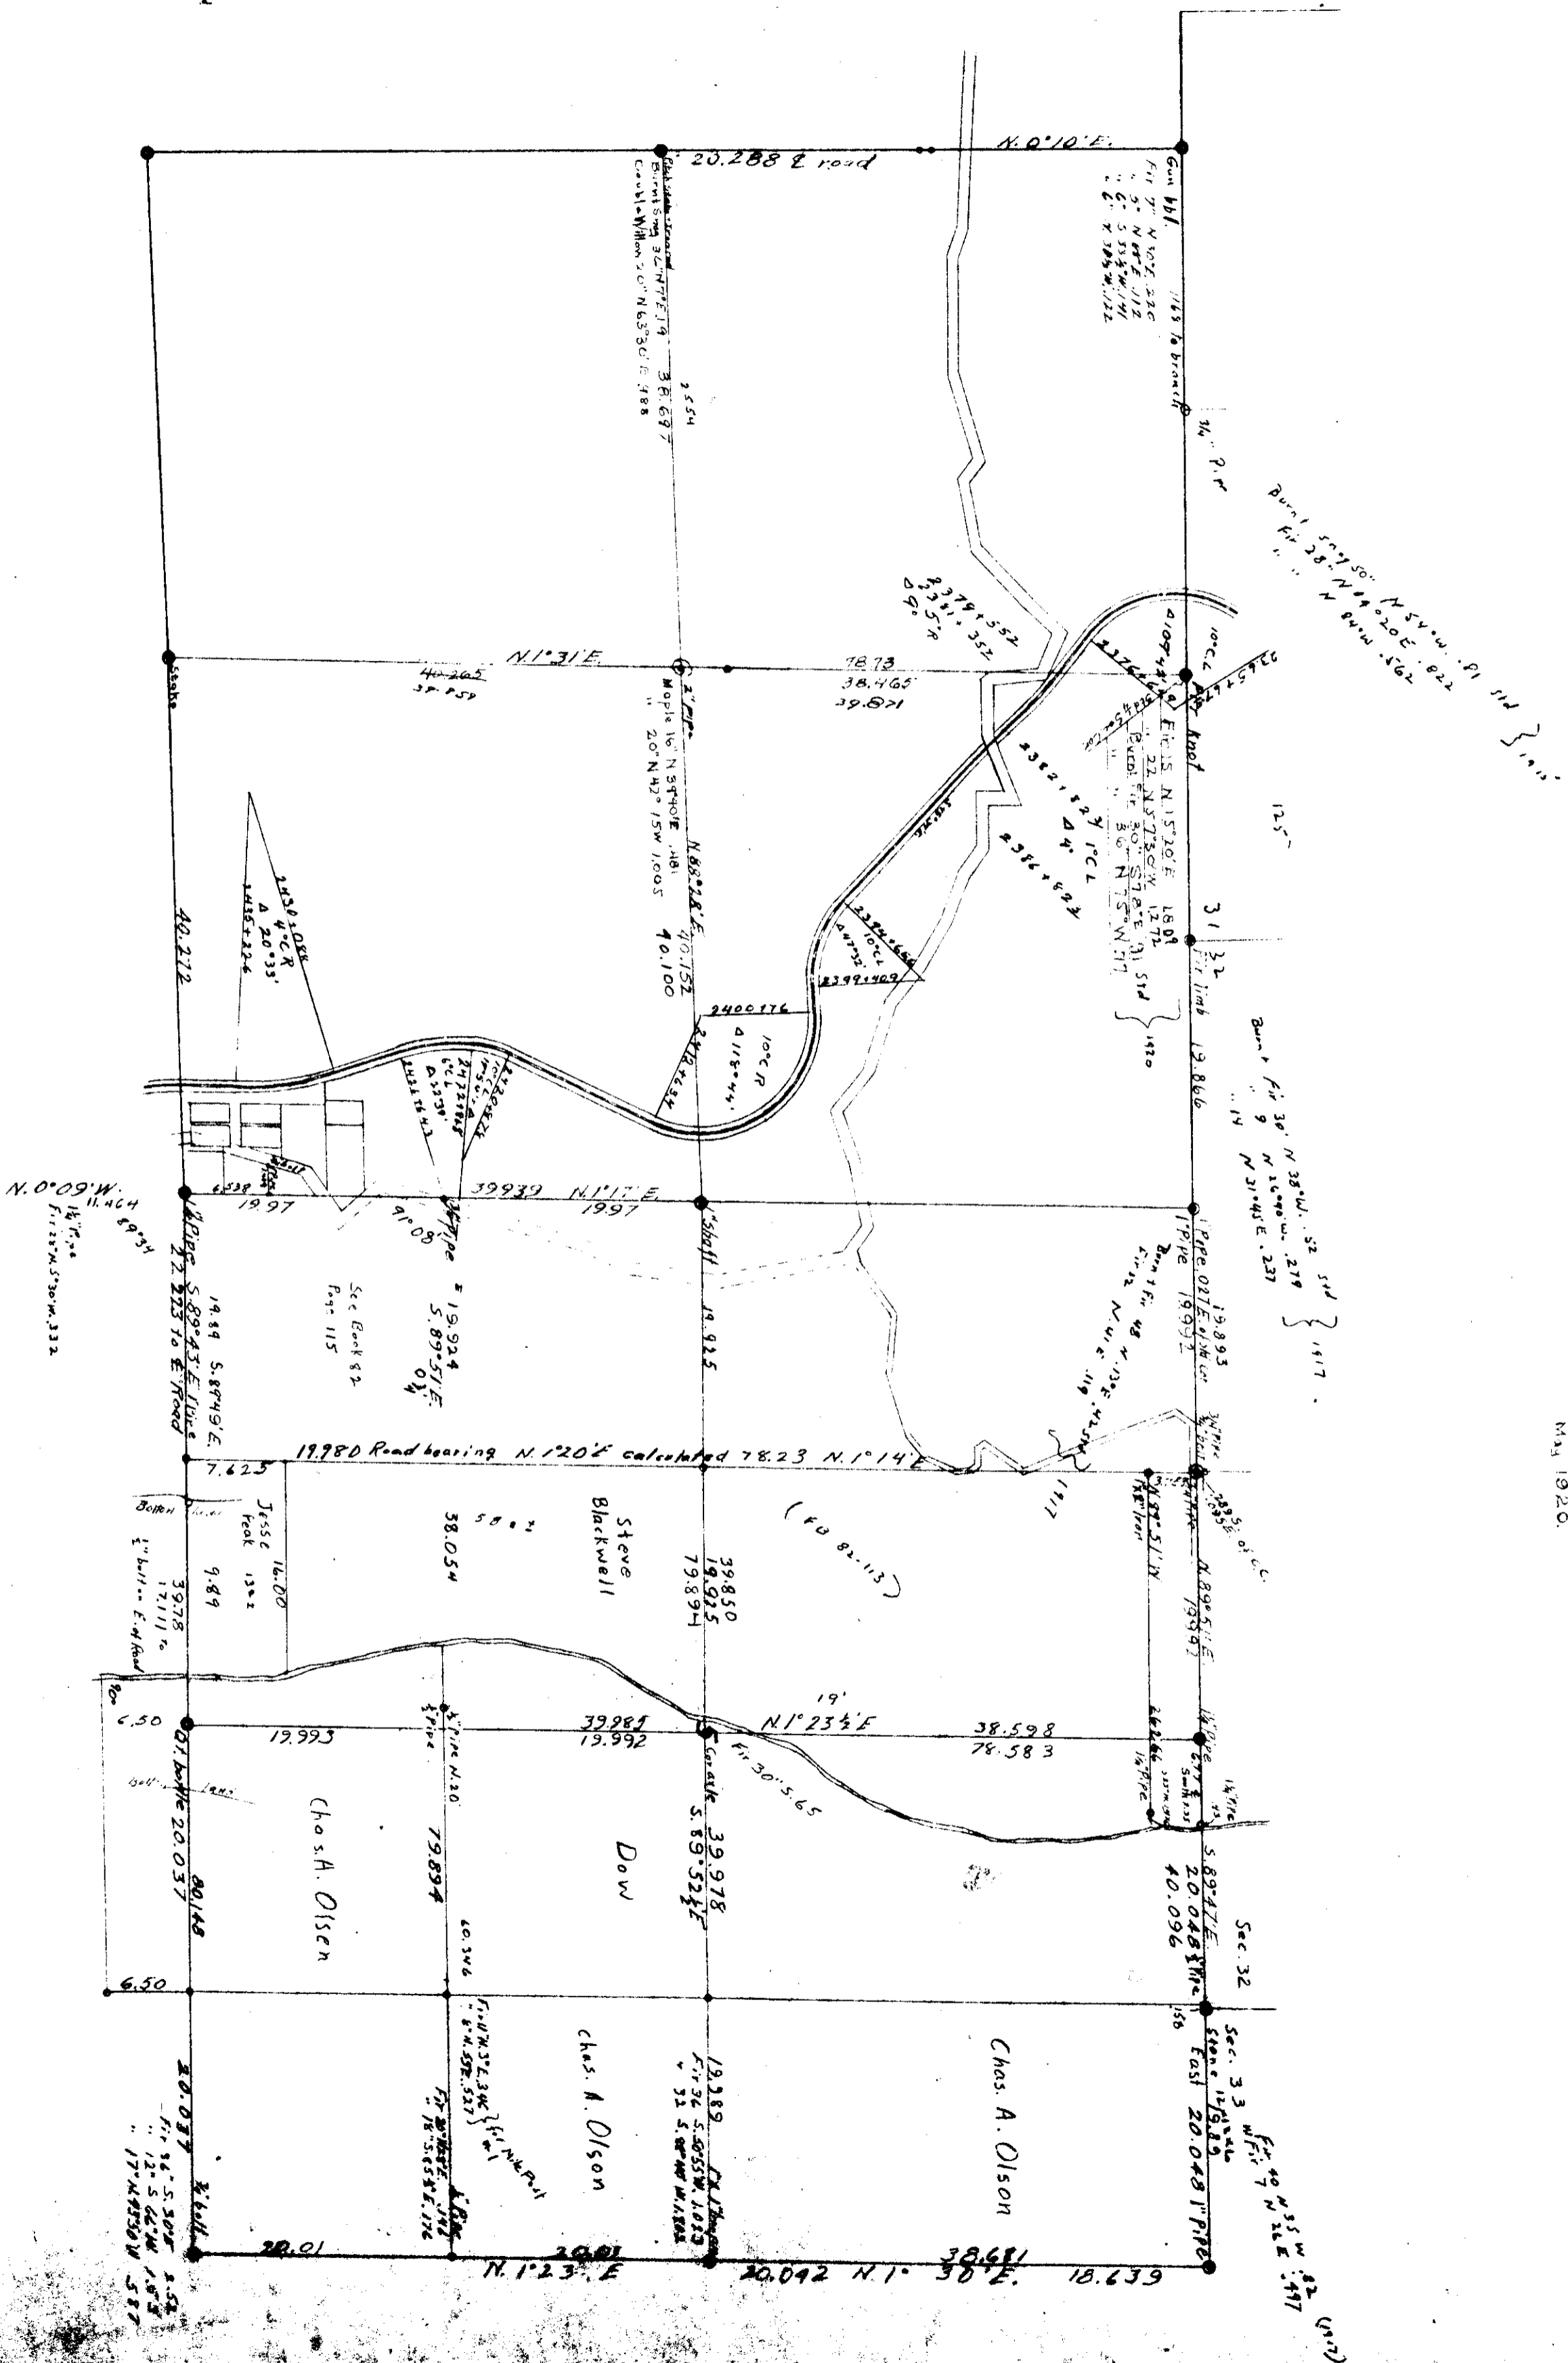

Scale 1" = 100 Chs.

W.C. Galloway

May 1920.

COUNTY SURVEY 286.  
Section 6 T18 R7W WM