

11-7  
19, 20

00010


C.S. 87

# COUNTY SURVEY #87

Secs. 19, 20 T. 115R7W.W.M.

Scale 1" = 10 chs.

W.C. Galloway CS  
Sec. 20 by  
F. Meron Wilkes.

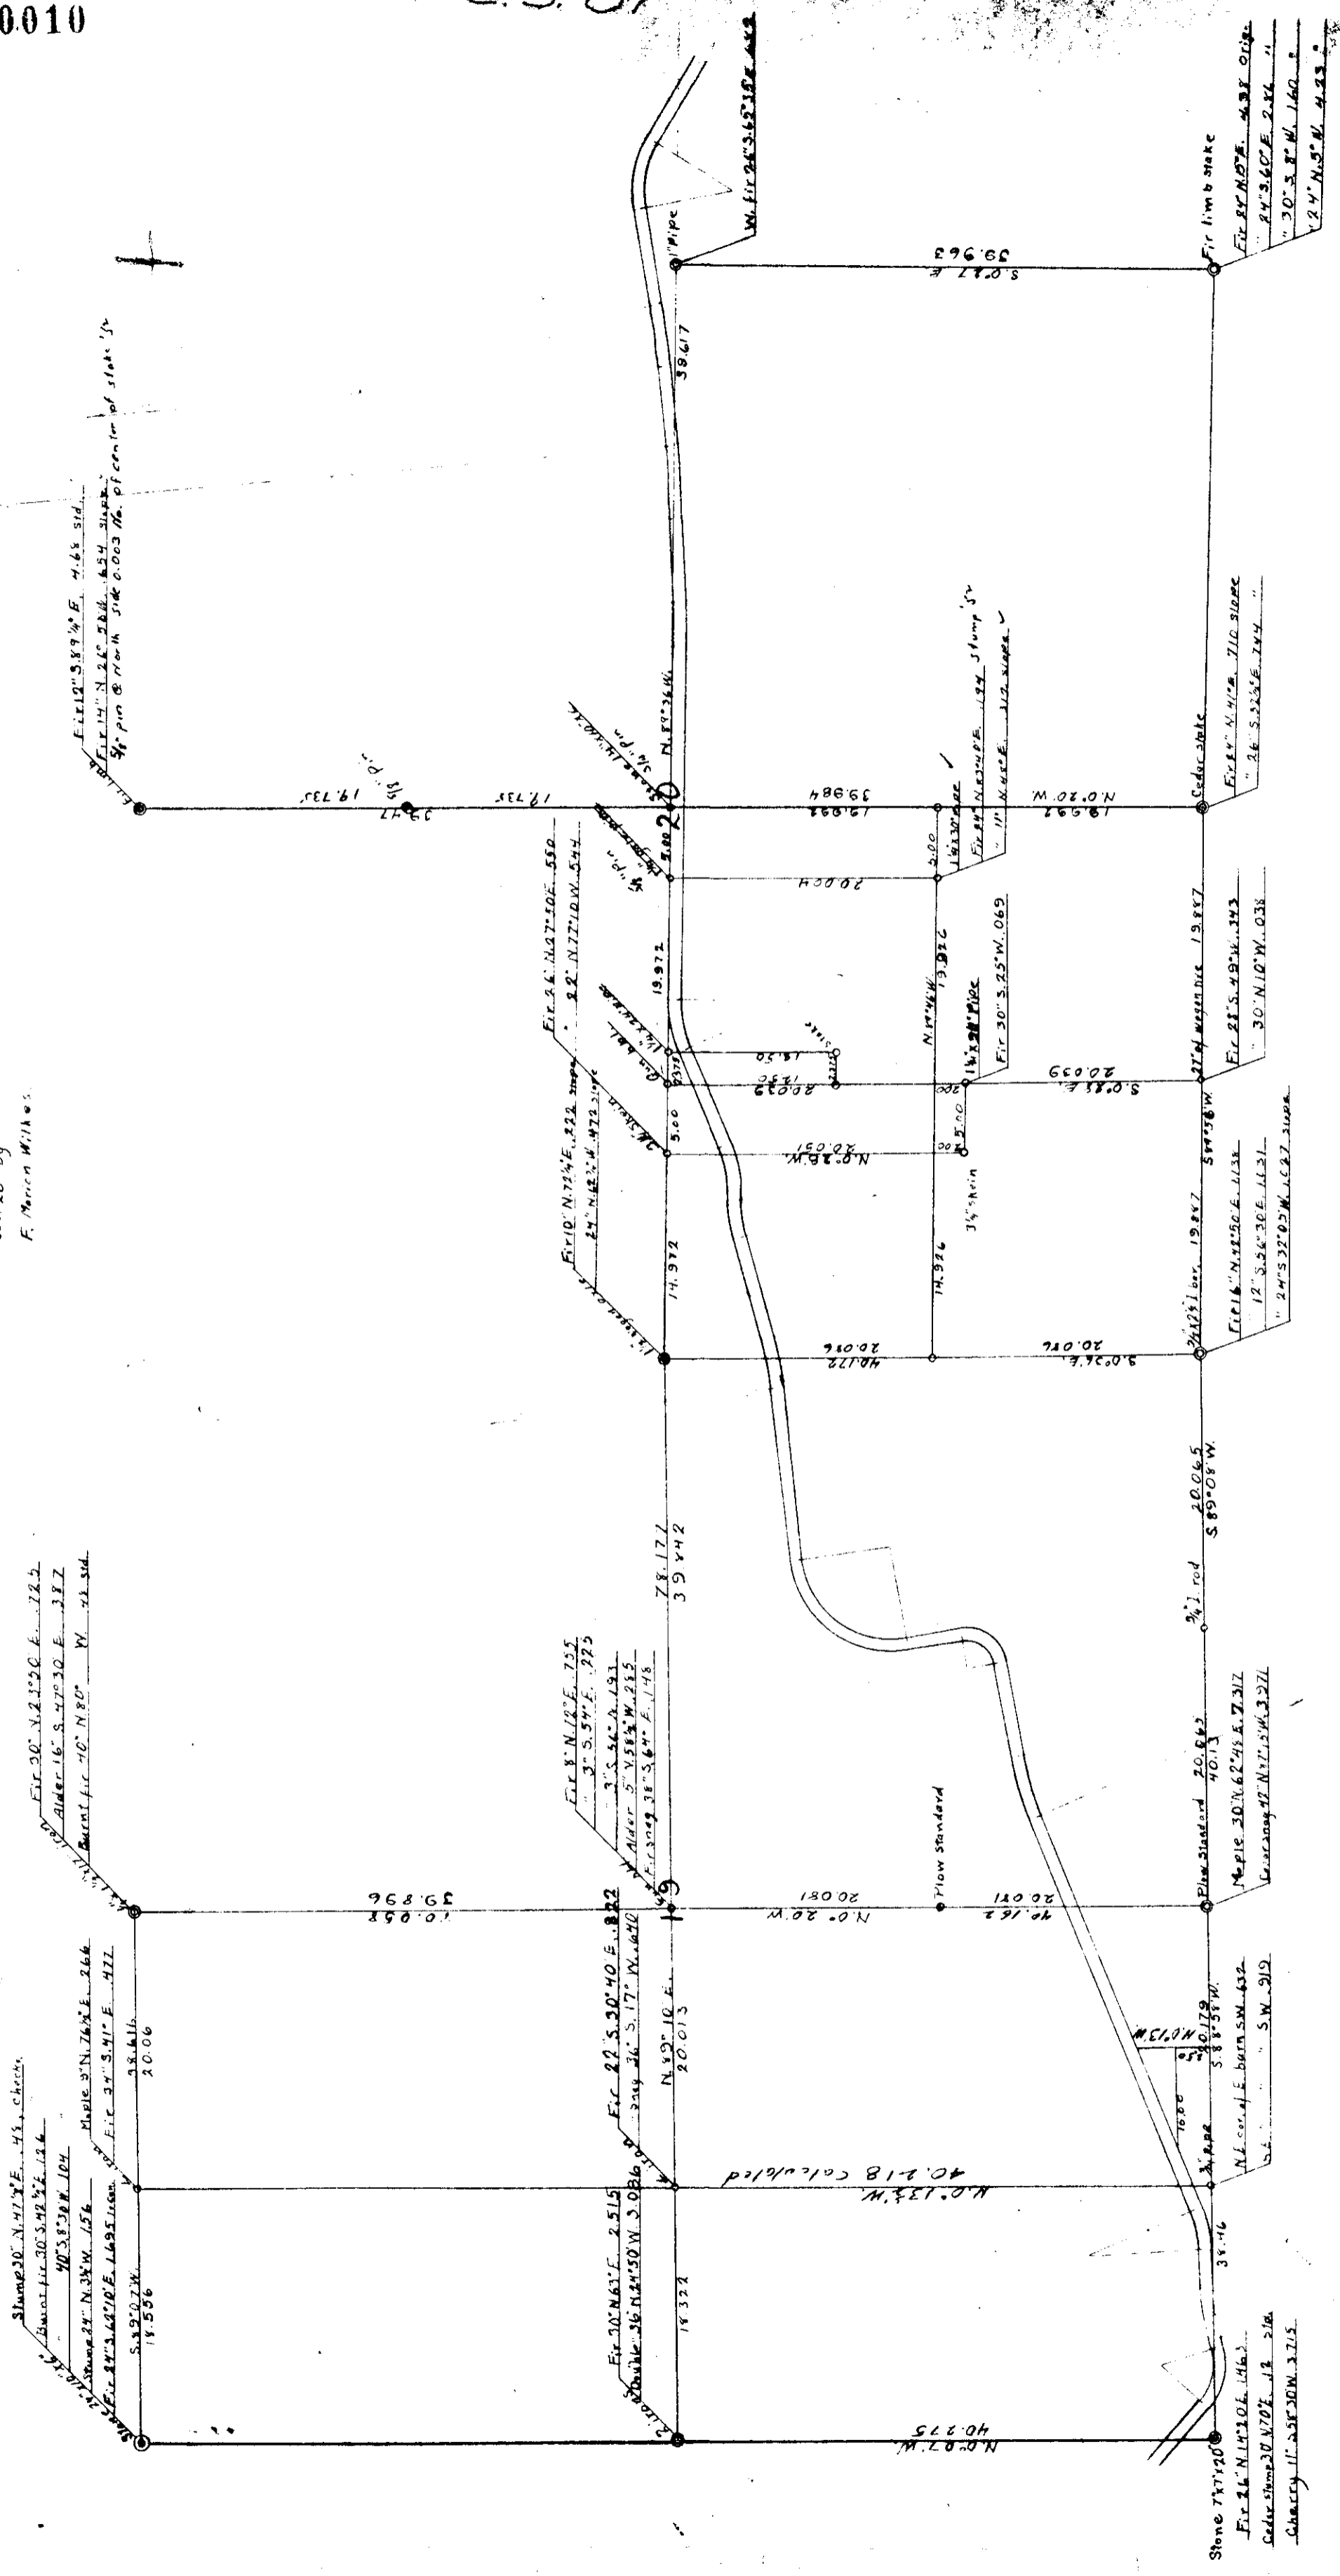

11-7  
19+20