


12-5
182 00003 (12-5 on back)
2

CS 285

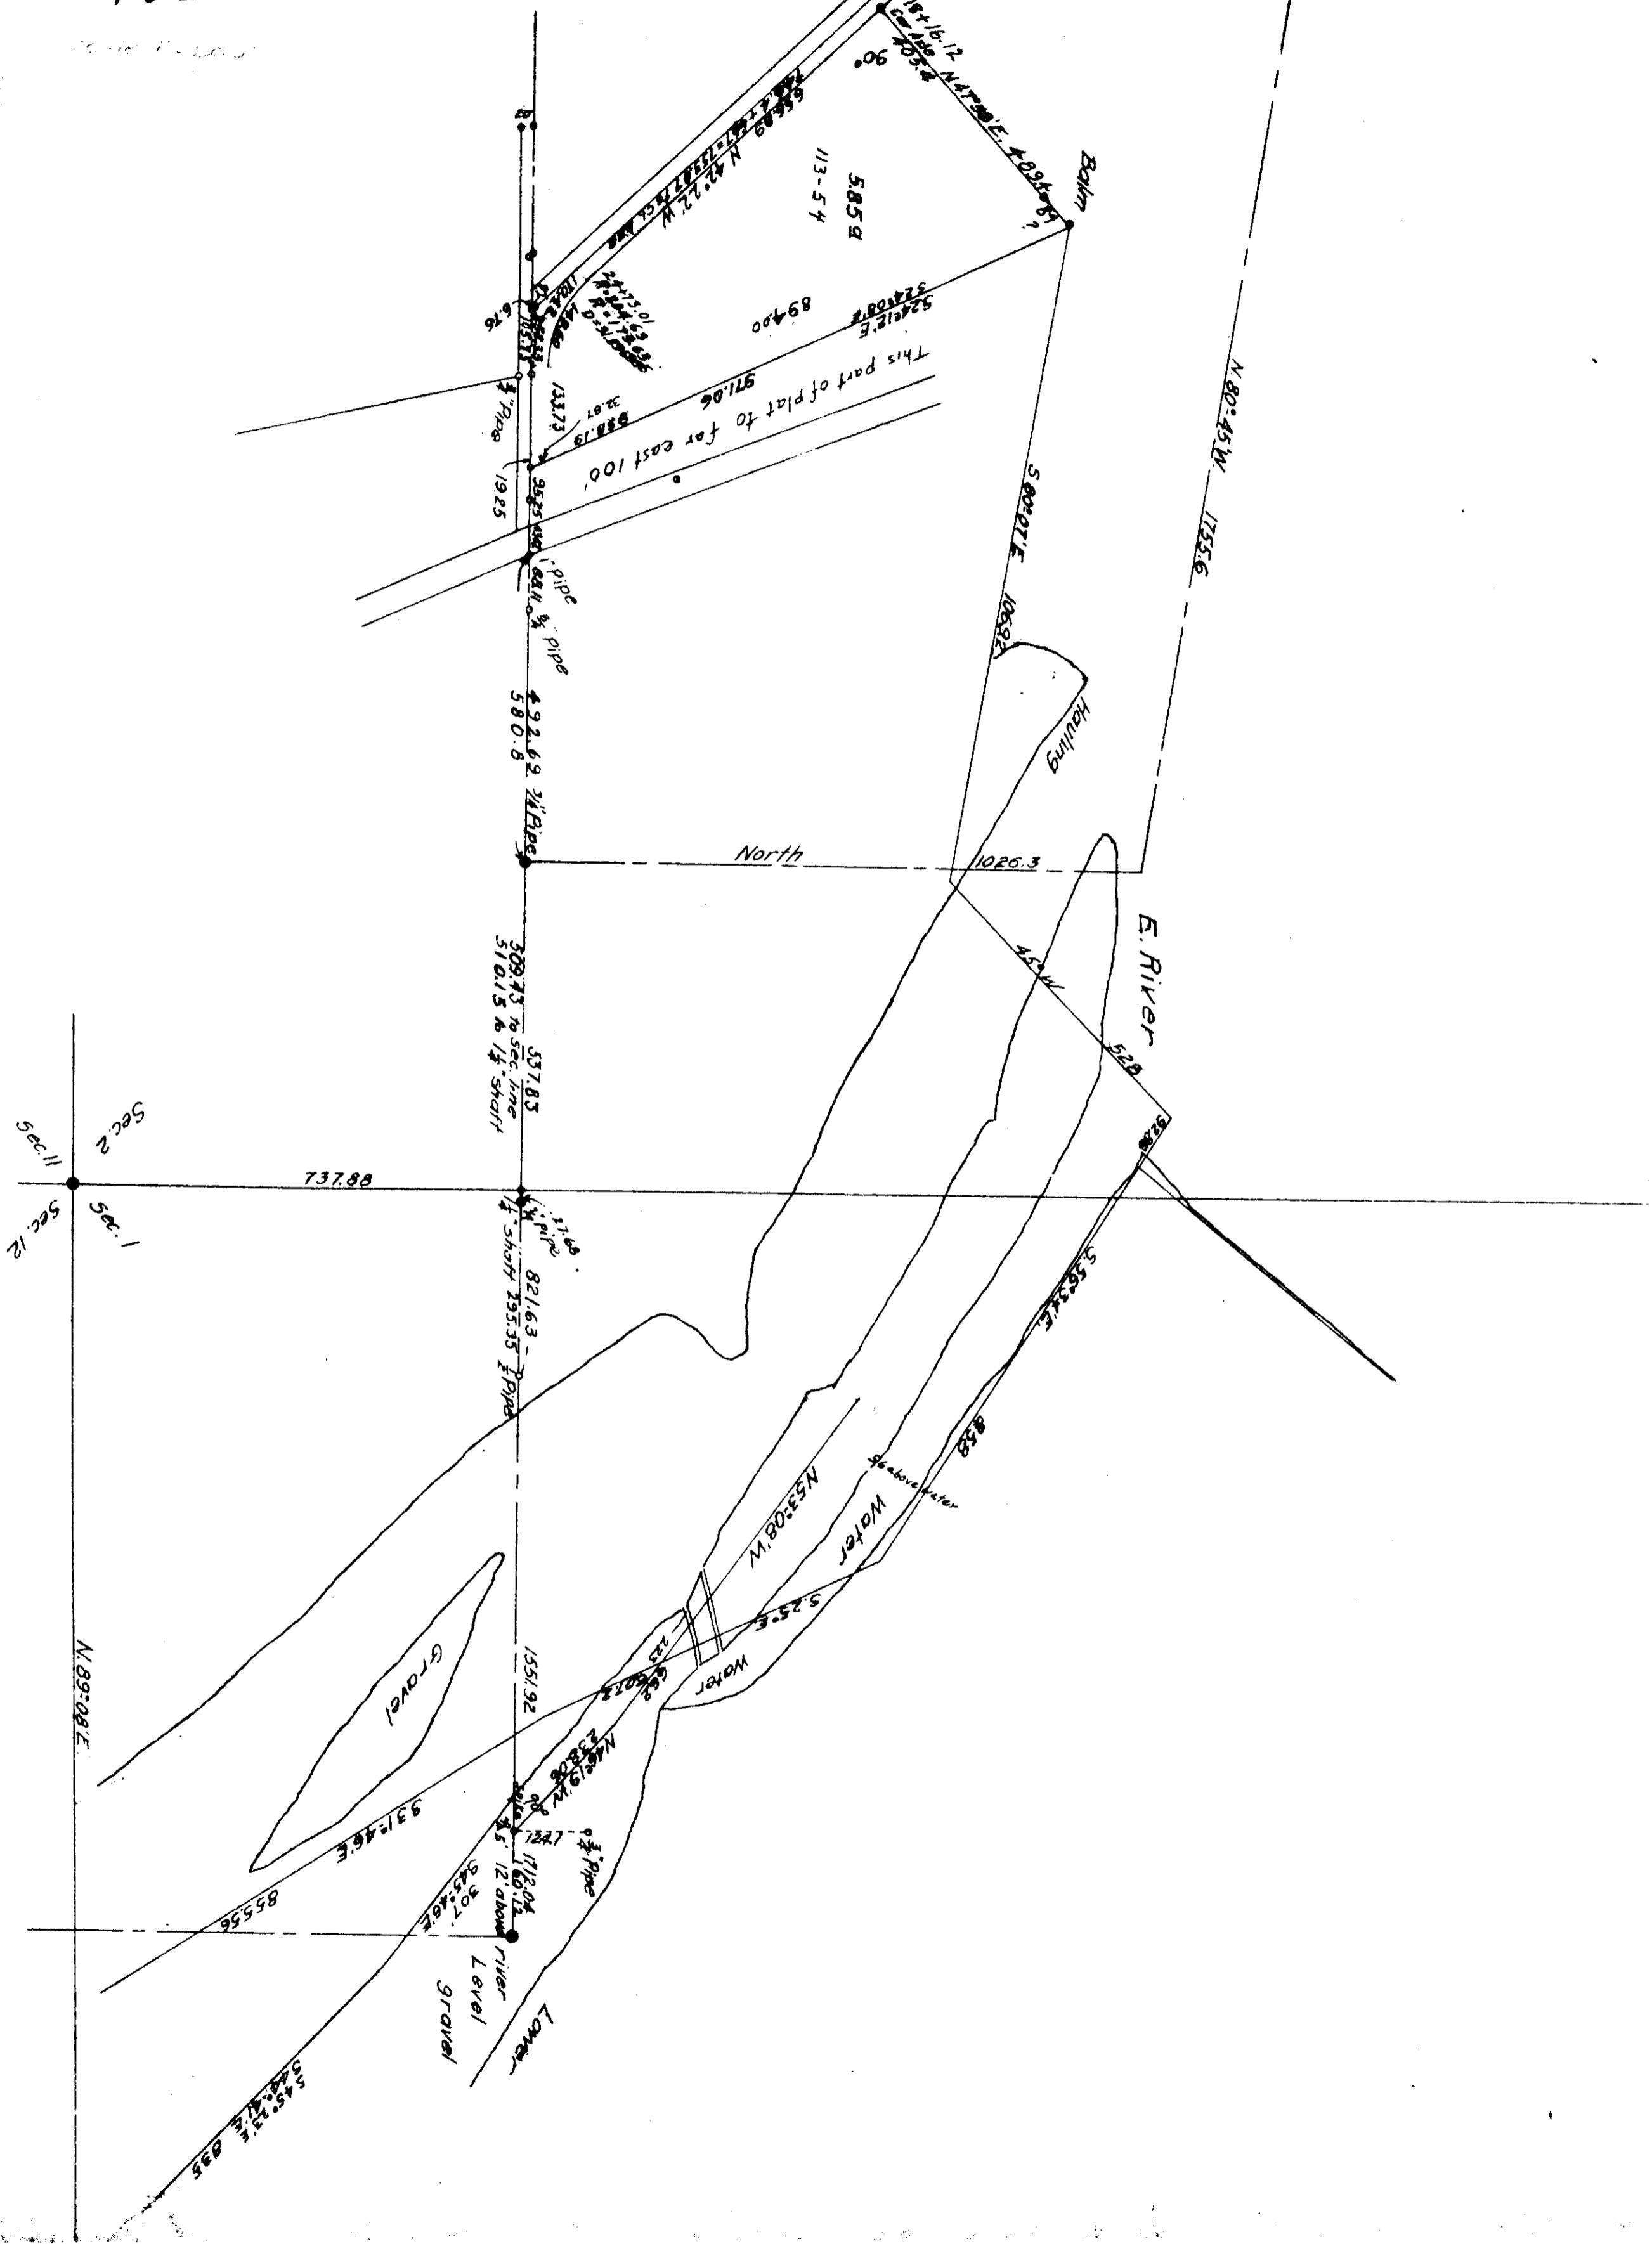

County Survey No 285
Secs 1 & 2 T12S.R5W.W.M.

Scale: 1"=200'
Sept. 22, 1945
W. C. Dalloway CS