


12-5  
8  
00025

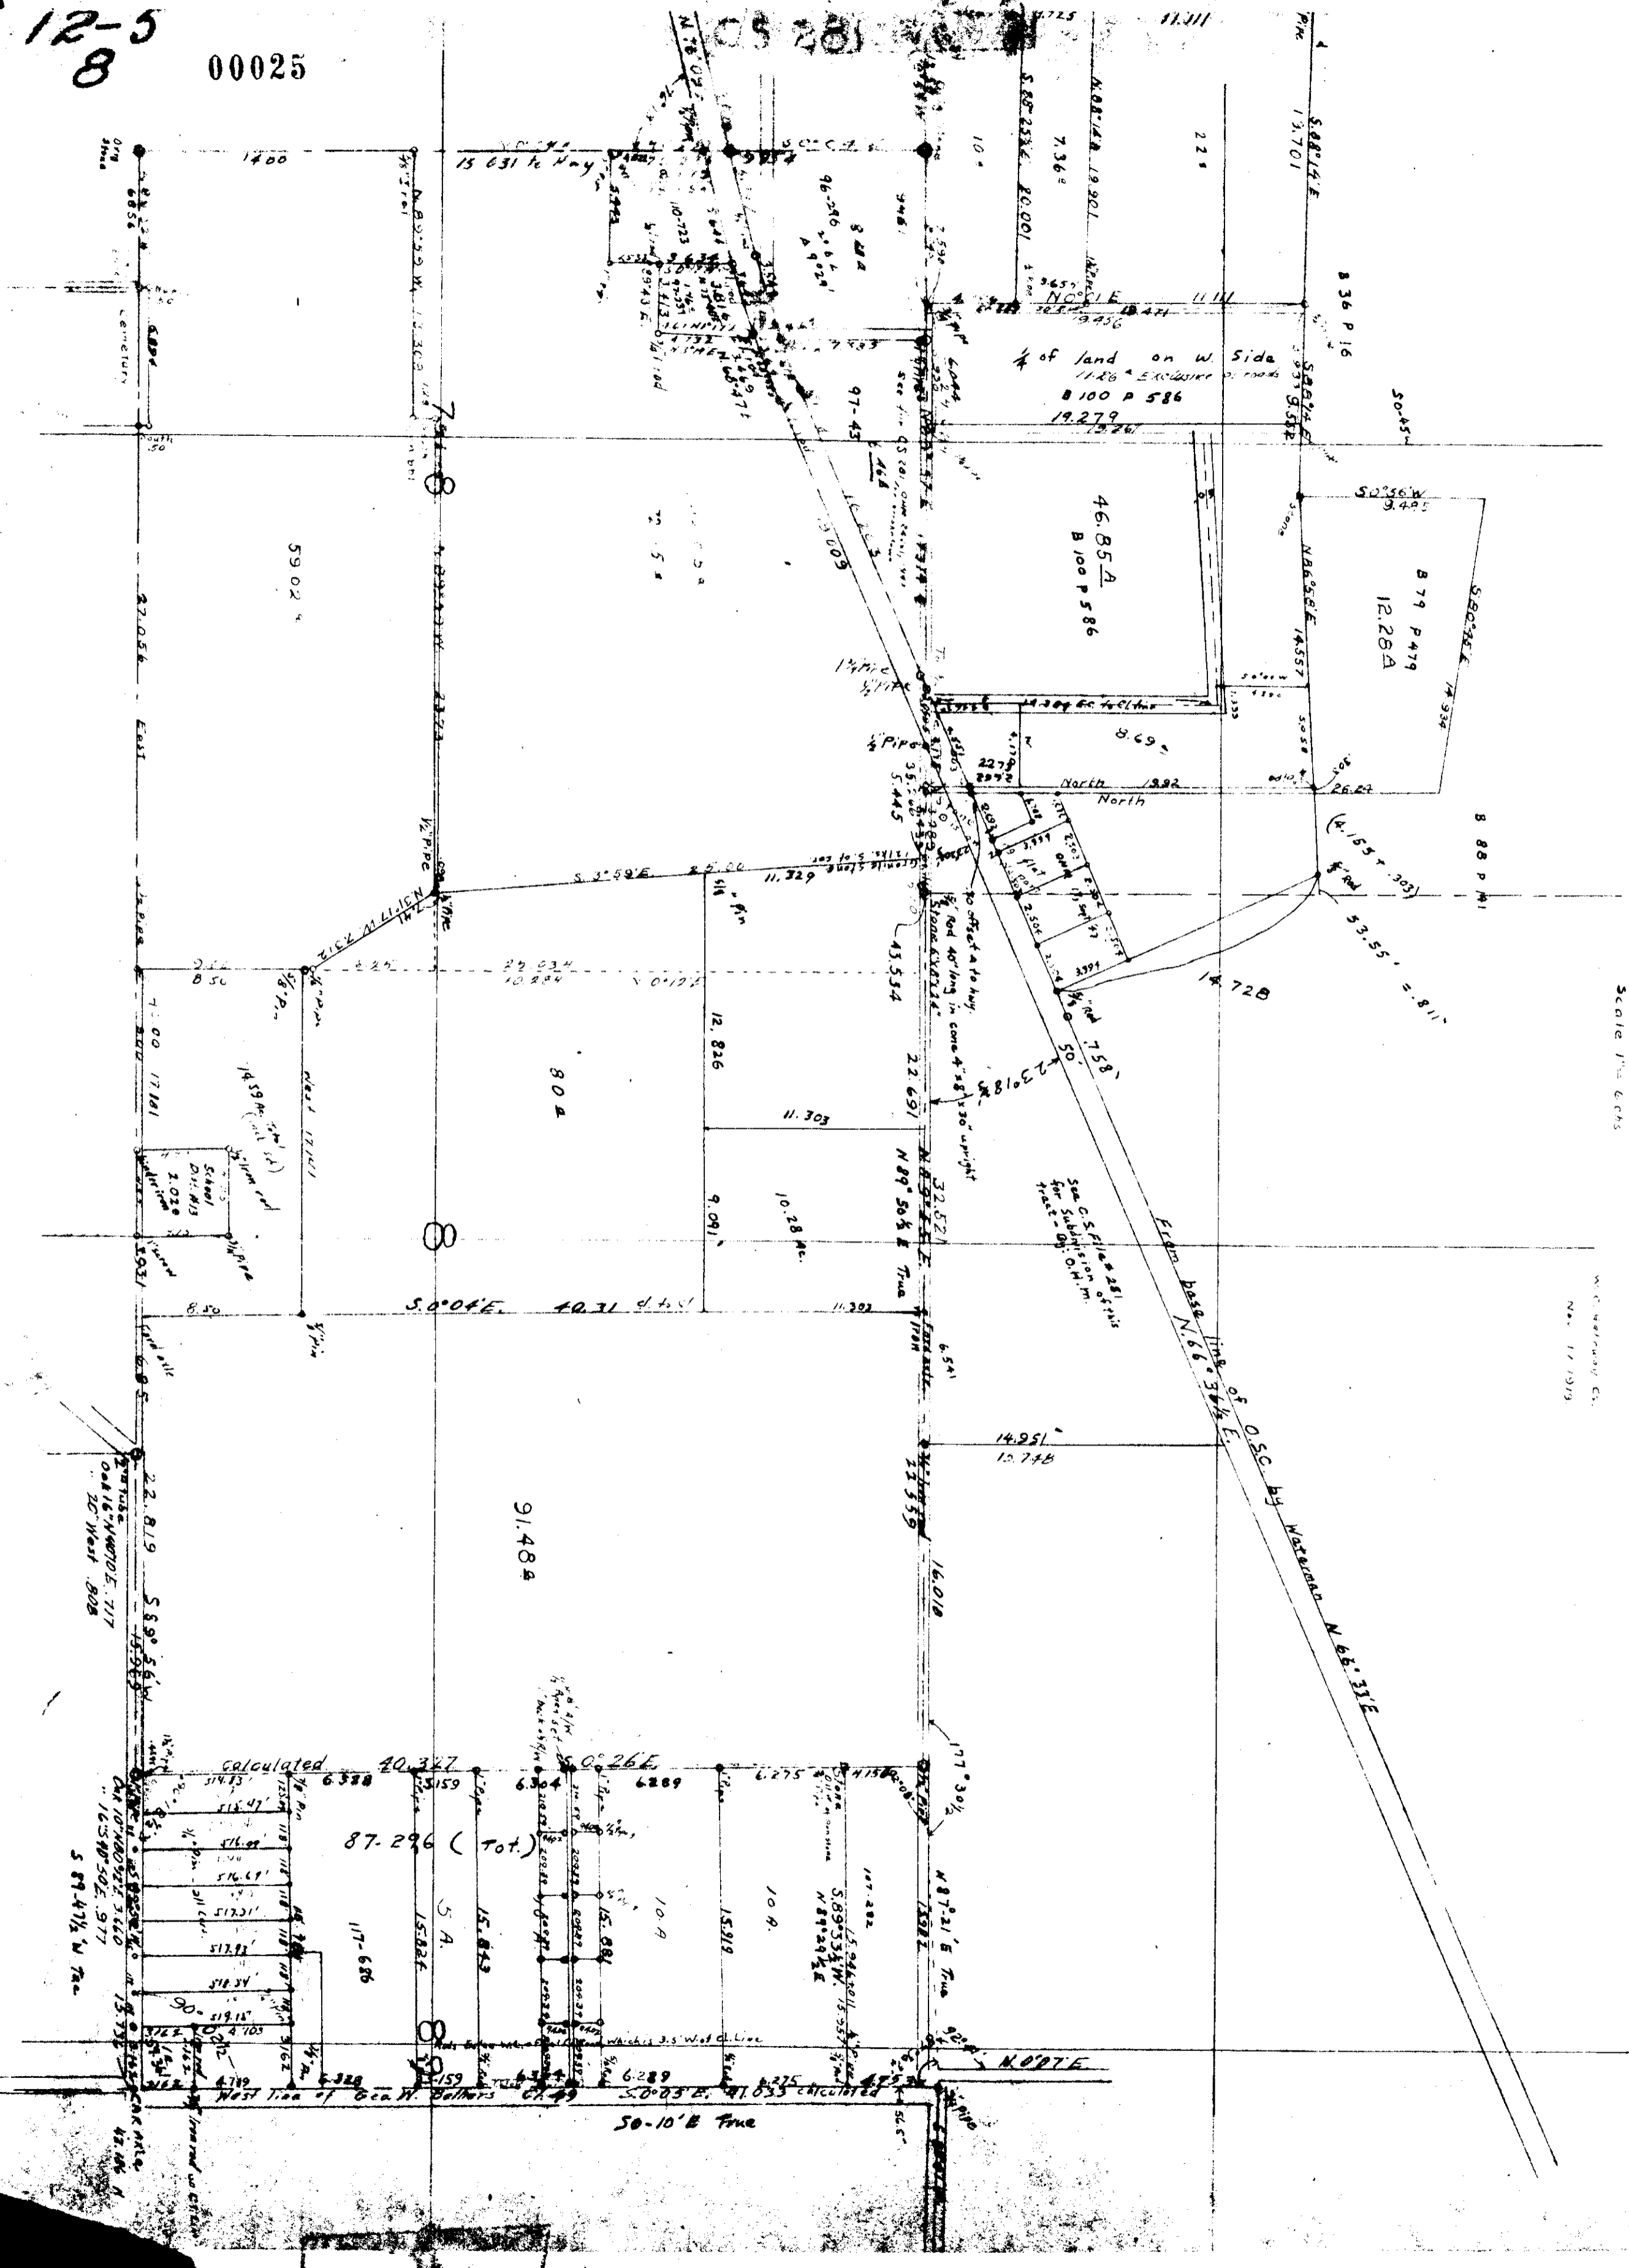

COUNTY SURVEY #281 of CS #257  
 Silas Newcomb DL.C. # 50  
 Sec 8 T. 12 S. R. 5 W. W. 11 Mer.  
 Scale 1 in. = 40 ft.  
 NOV. 17, 1919