


12-5 00027
9

C.S. 264
Scale 1" = 60 ft.

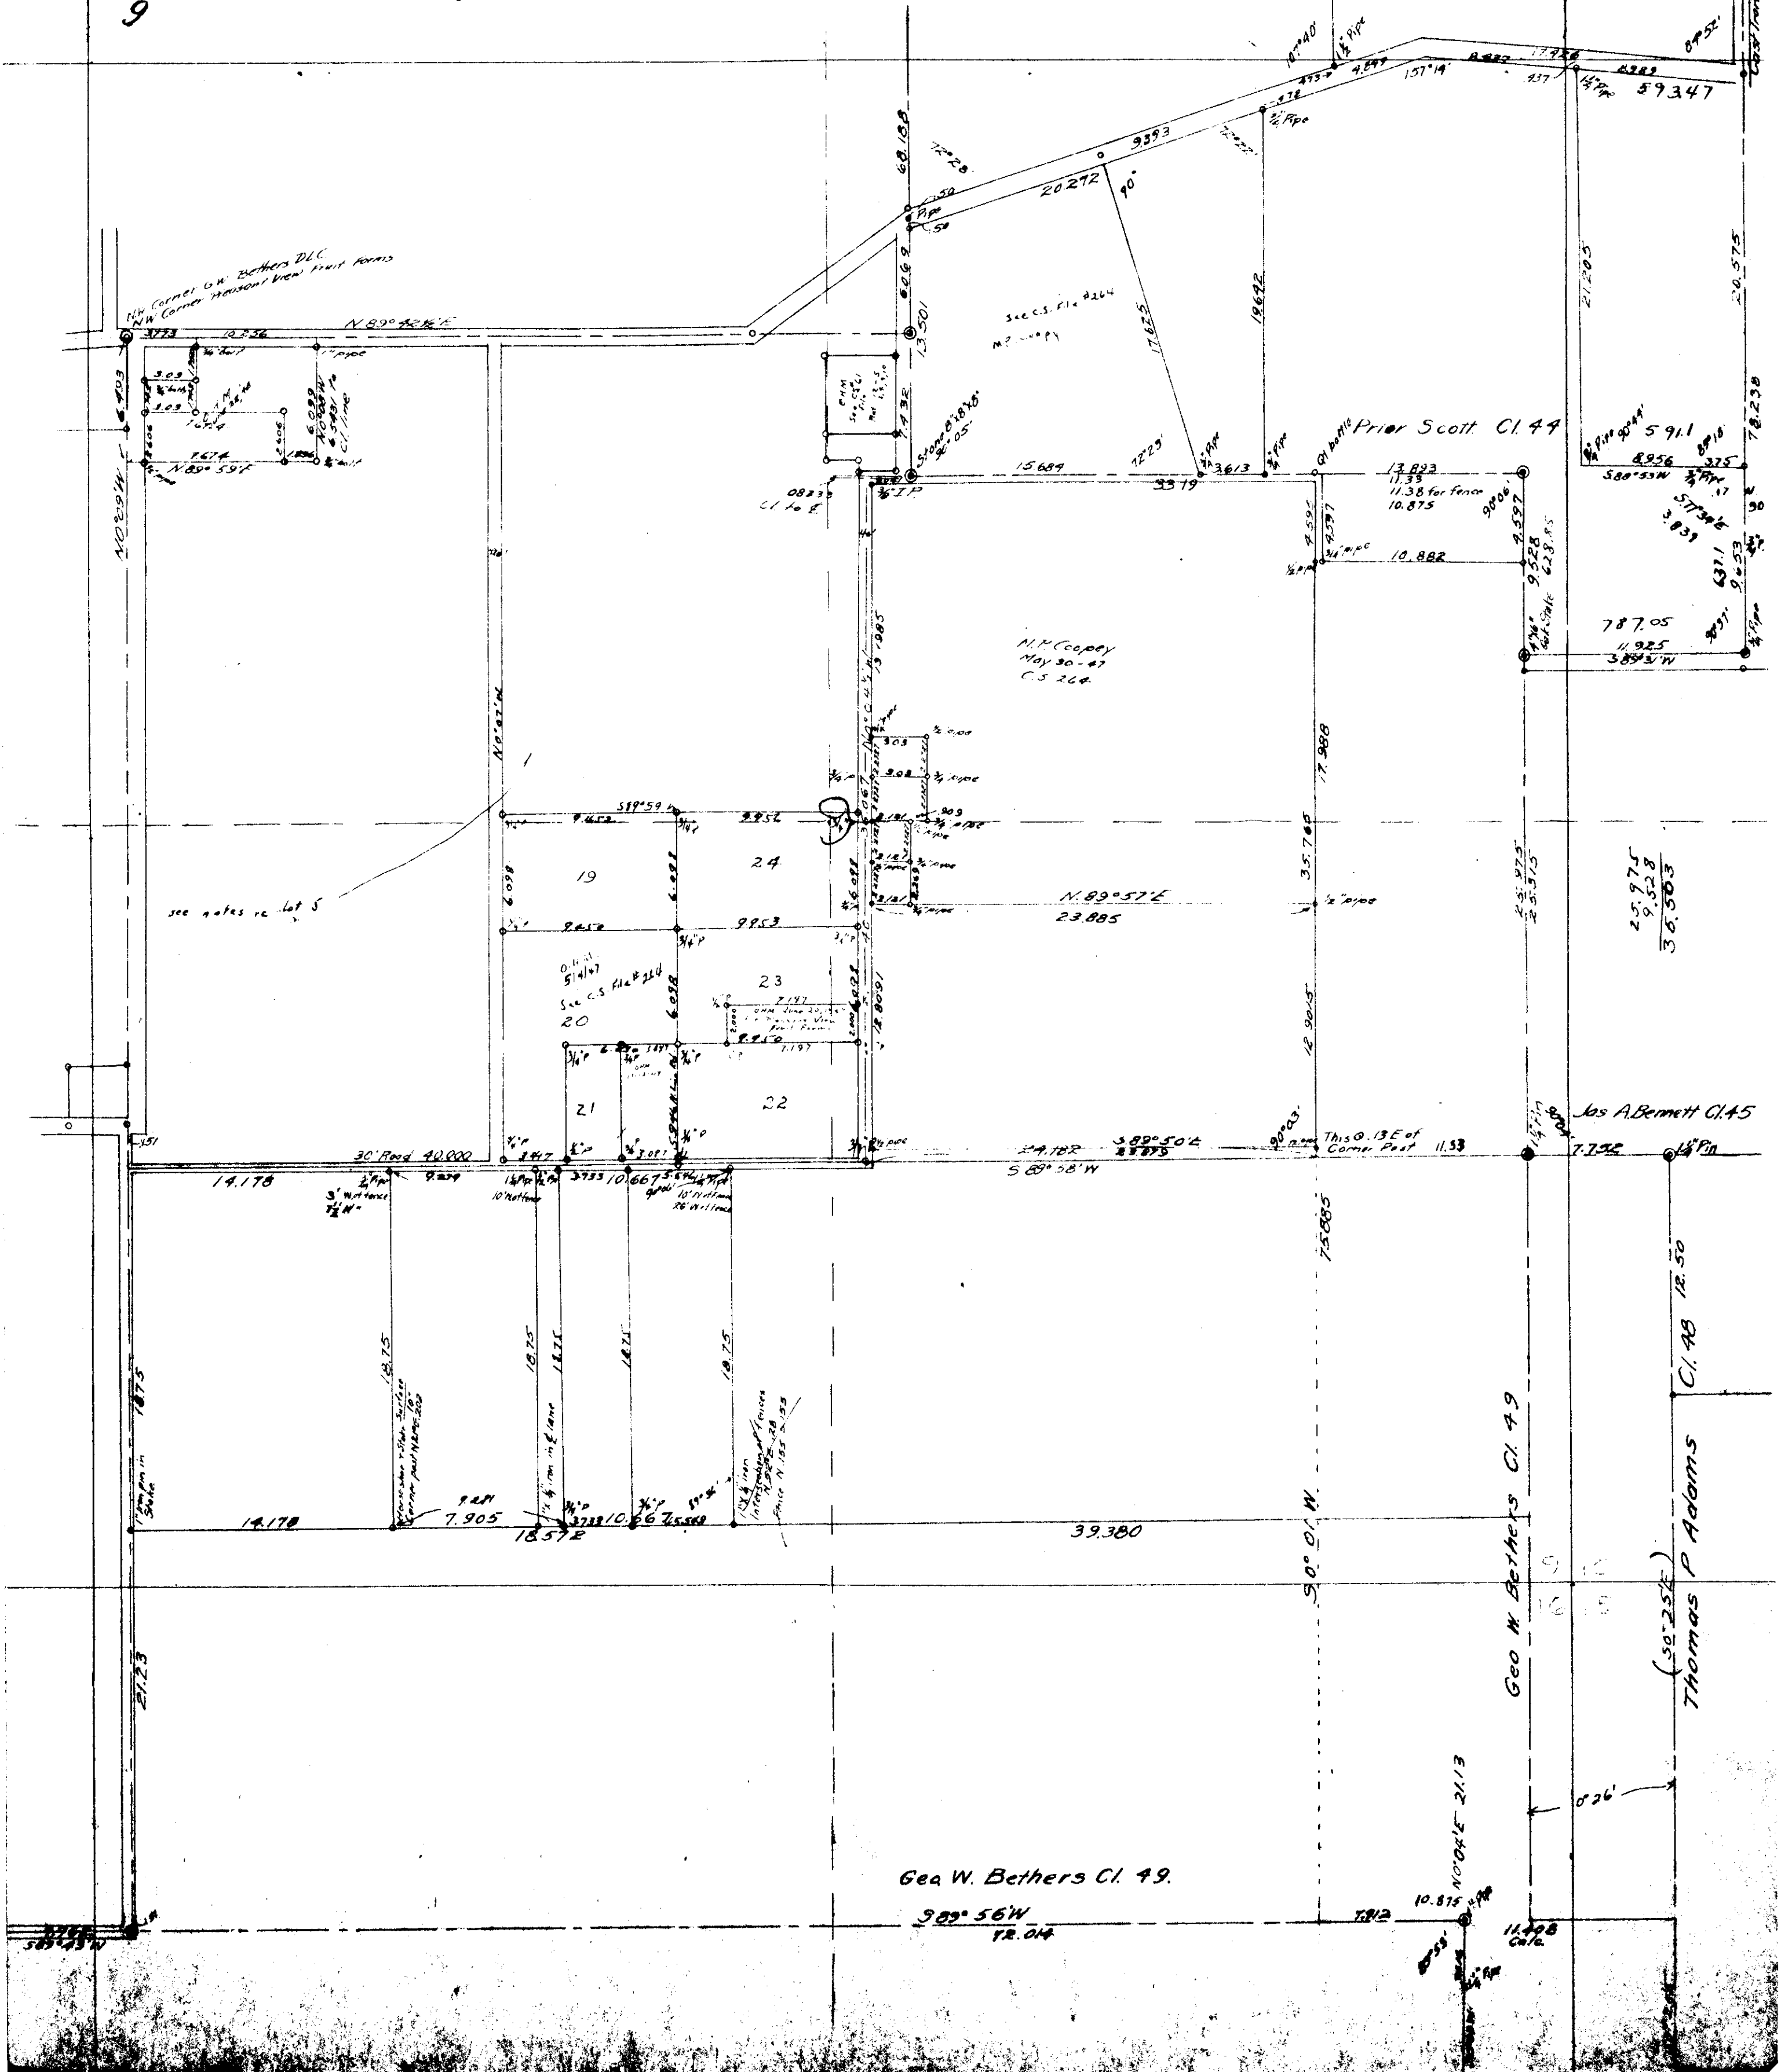

NW Corner Geo. Bethers D.L.C.
NW Corner Watson's D.L.C. Fruit Farms

see notes re Lot 5

N.M. Copey
May 30-47
C.S. 264

Jas. A. Bennett Cl. 45

Geo M. Bethers Cl. 49

Thomas P Adams
Cl. 48
(50' x 25')

Geo W. Bethers Cl. 49
S 89° 56' W
12.04

59.347

787.05
11.925
389' 3/4 W

25.975
9.528
36.503

12.50

50' 0" W

N 0° 0' E 21.13

10.815

11.428
Calc.

N 89° 56' E

N 89° 57' E
23.885

S 89° 50' E
8.875

S 89° 58' W

39.380

This 0.13 E of
Corner Post 11.33

75.665

50' 0" W

12.04

12.04

