


320.11 20,100 00031

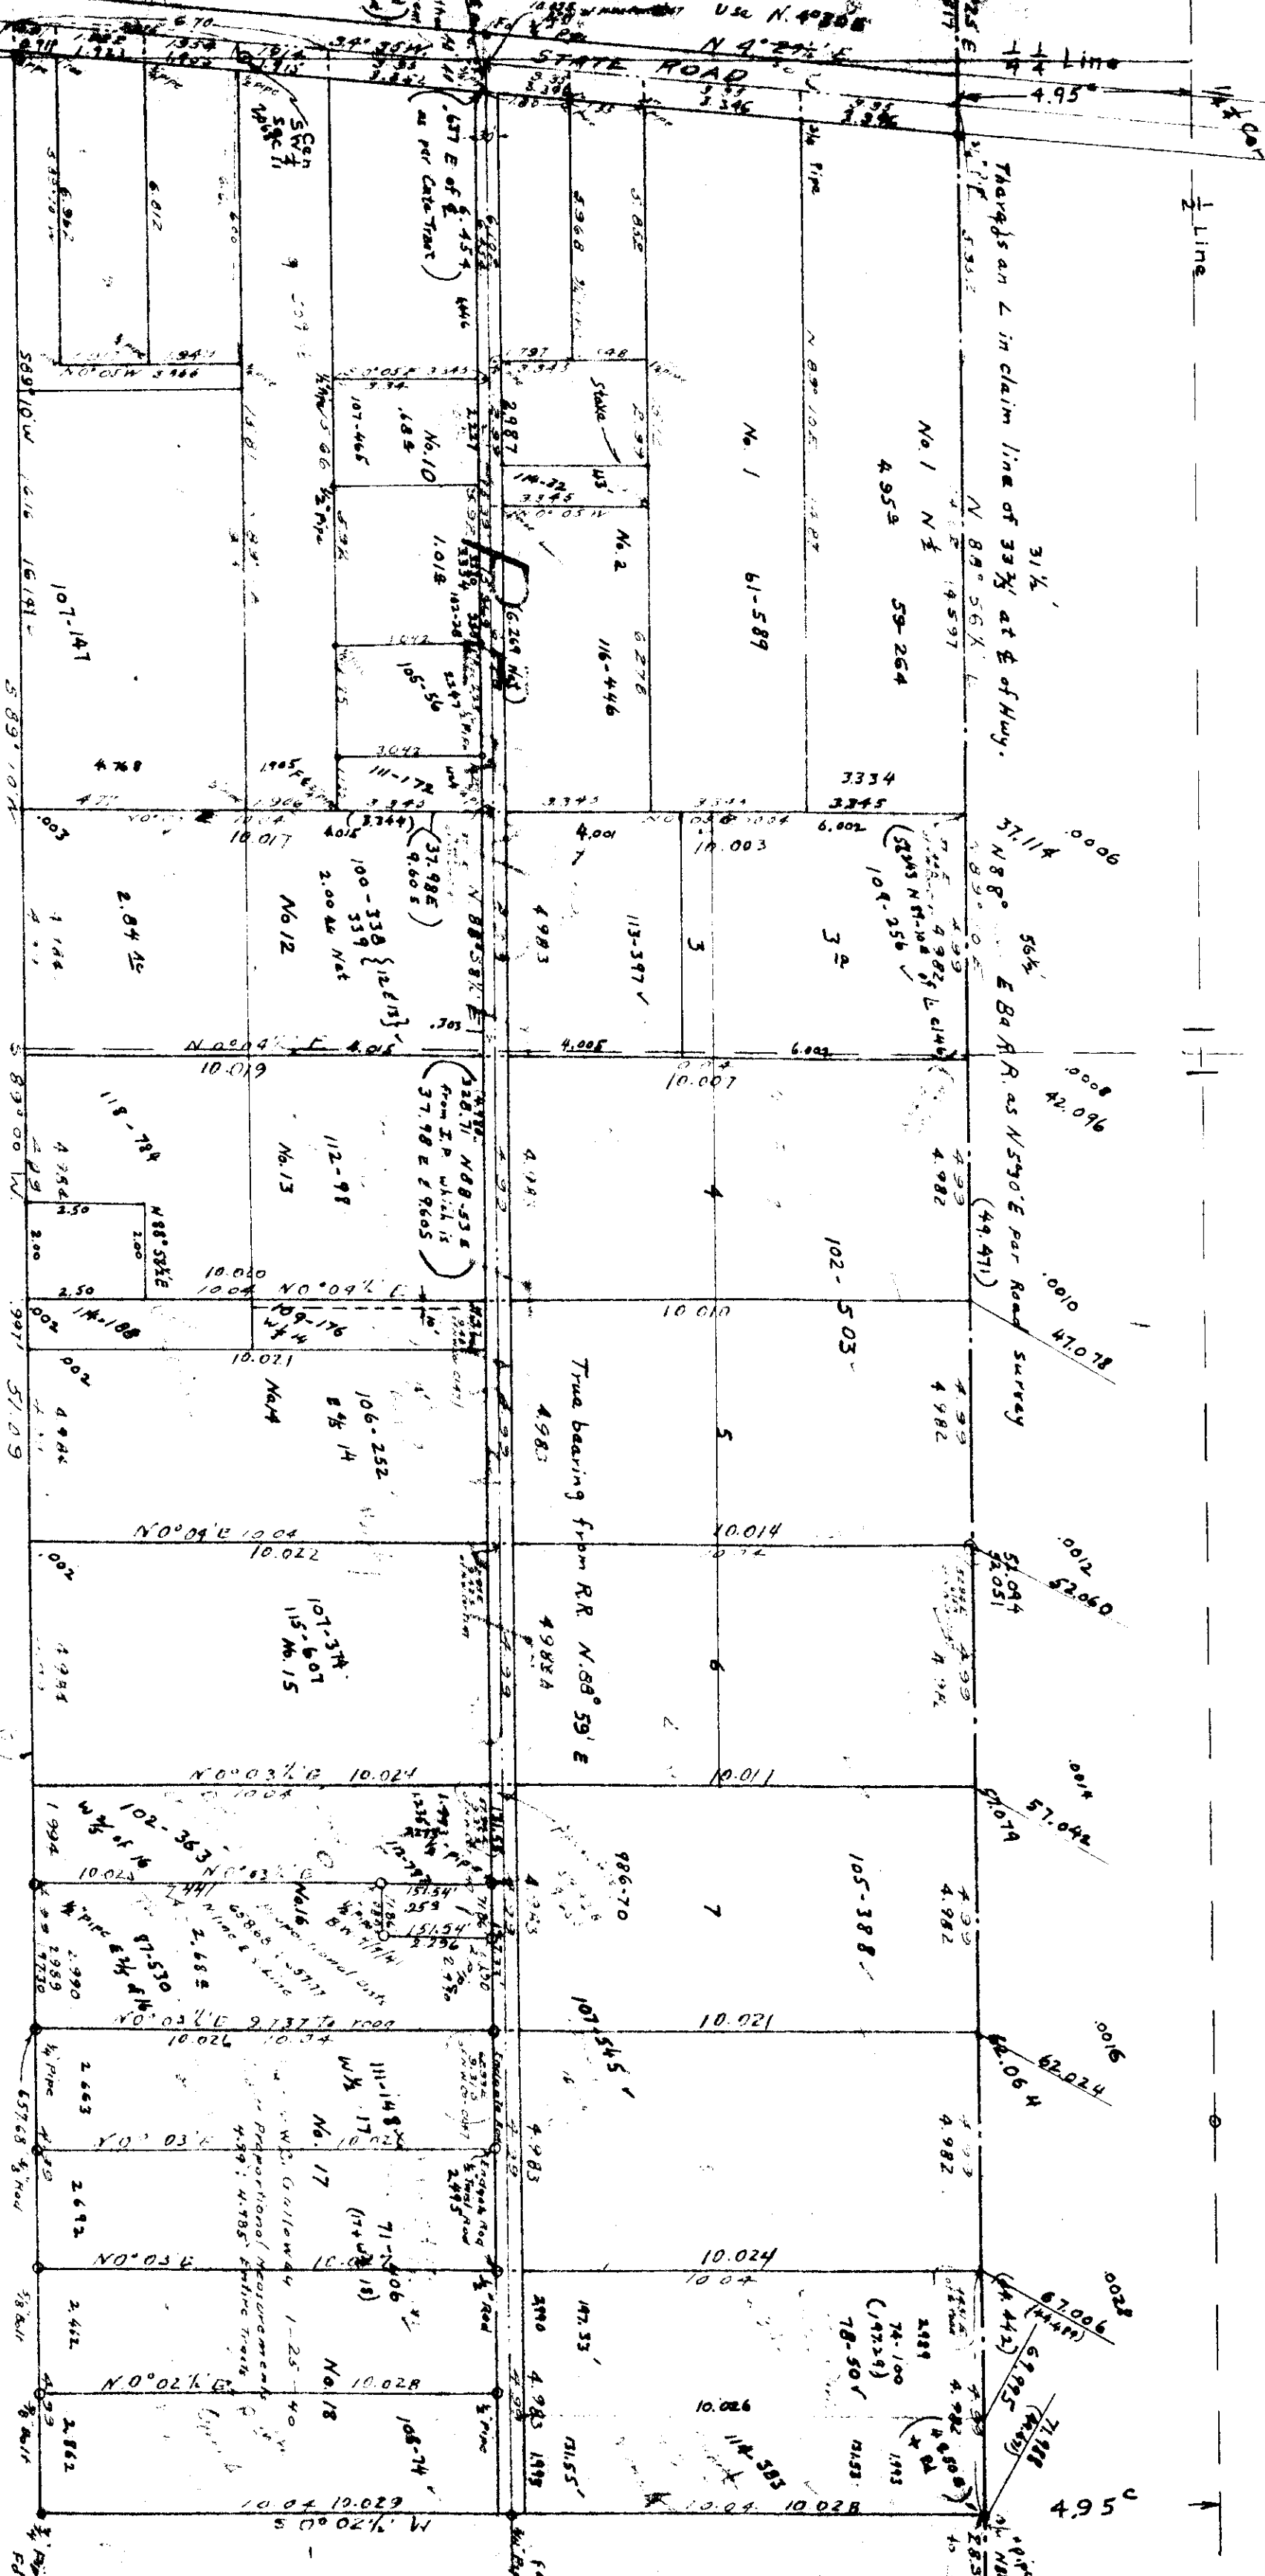

(648 E of R as per Case Tracts)

NOTE: offsets on pines along Hwy. in Br. 28 p. 27

(100-602 City Prop.)