


# COUNTY SURVEY 75

## CATE TRACTS

Scale 1" = 100'

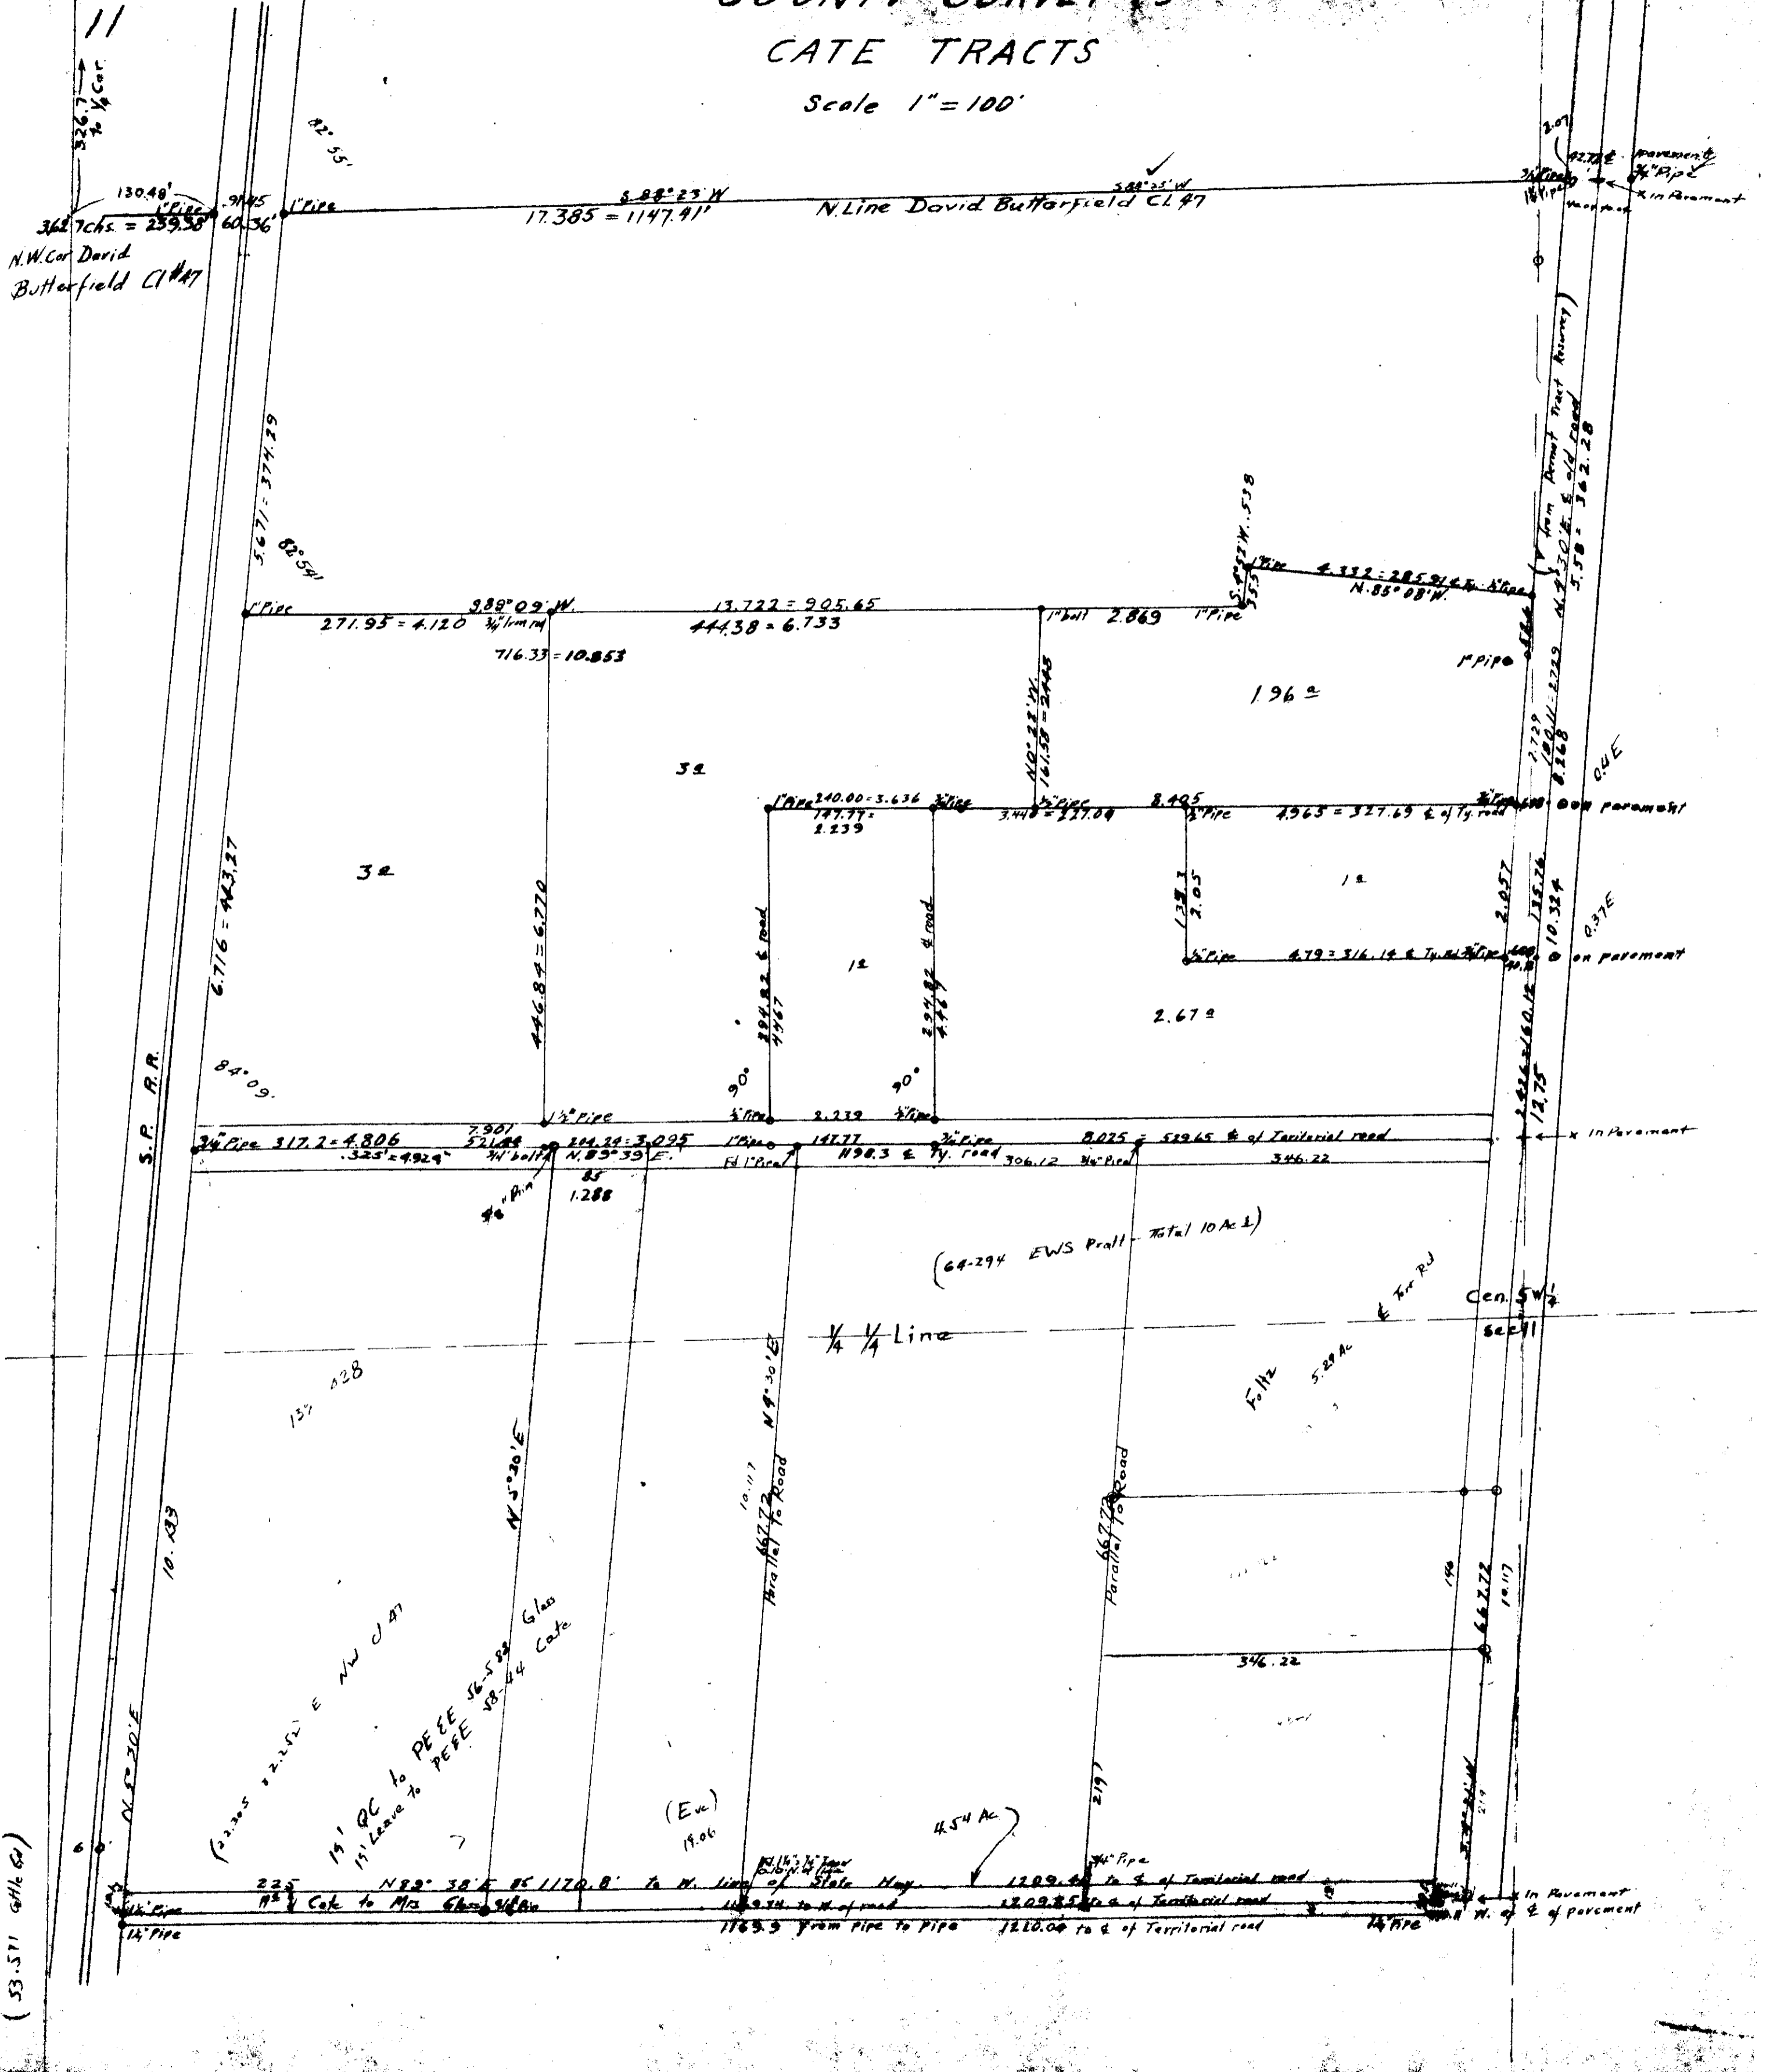

(53.571 6/16/64)