

12-5


12-5-00048

C.S. 285

Scale 1" = 200'

2

5.66
 1.51
 .42
 3.00
 11.69
 11.64 average

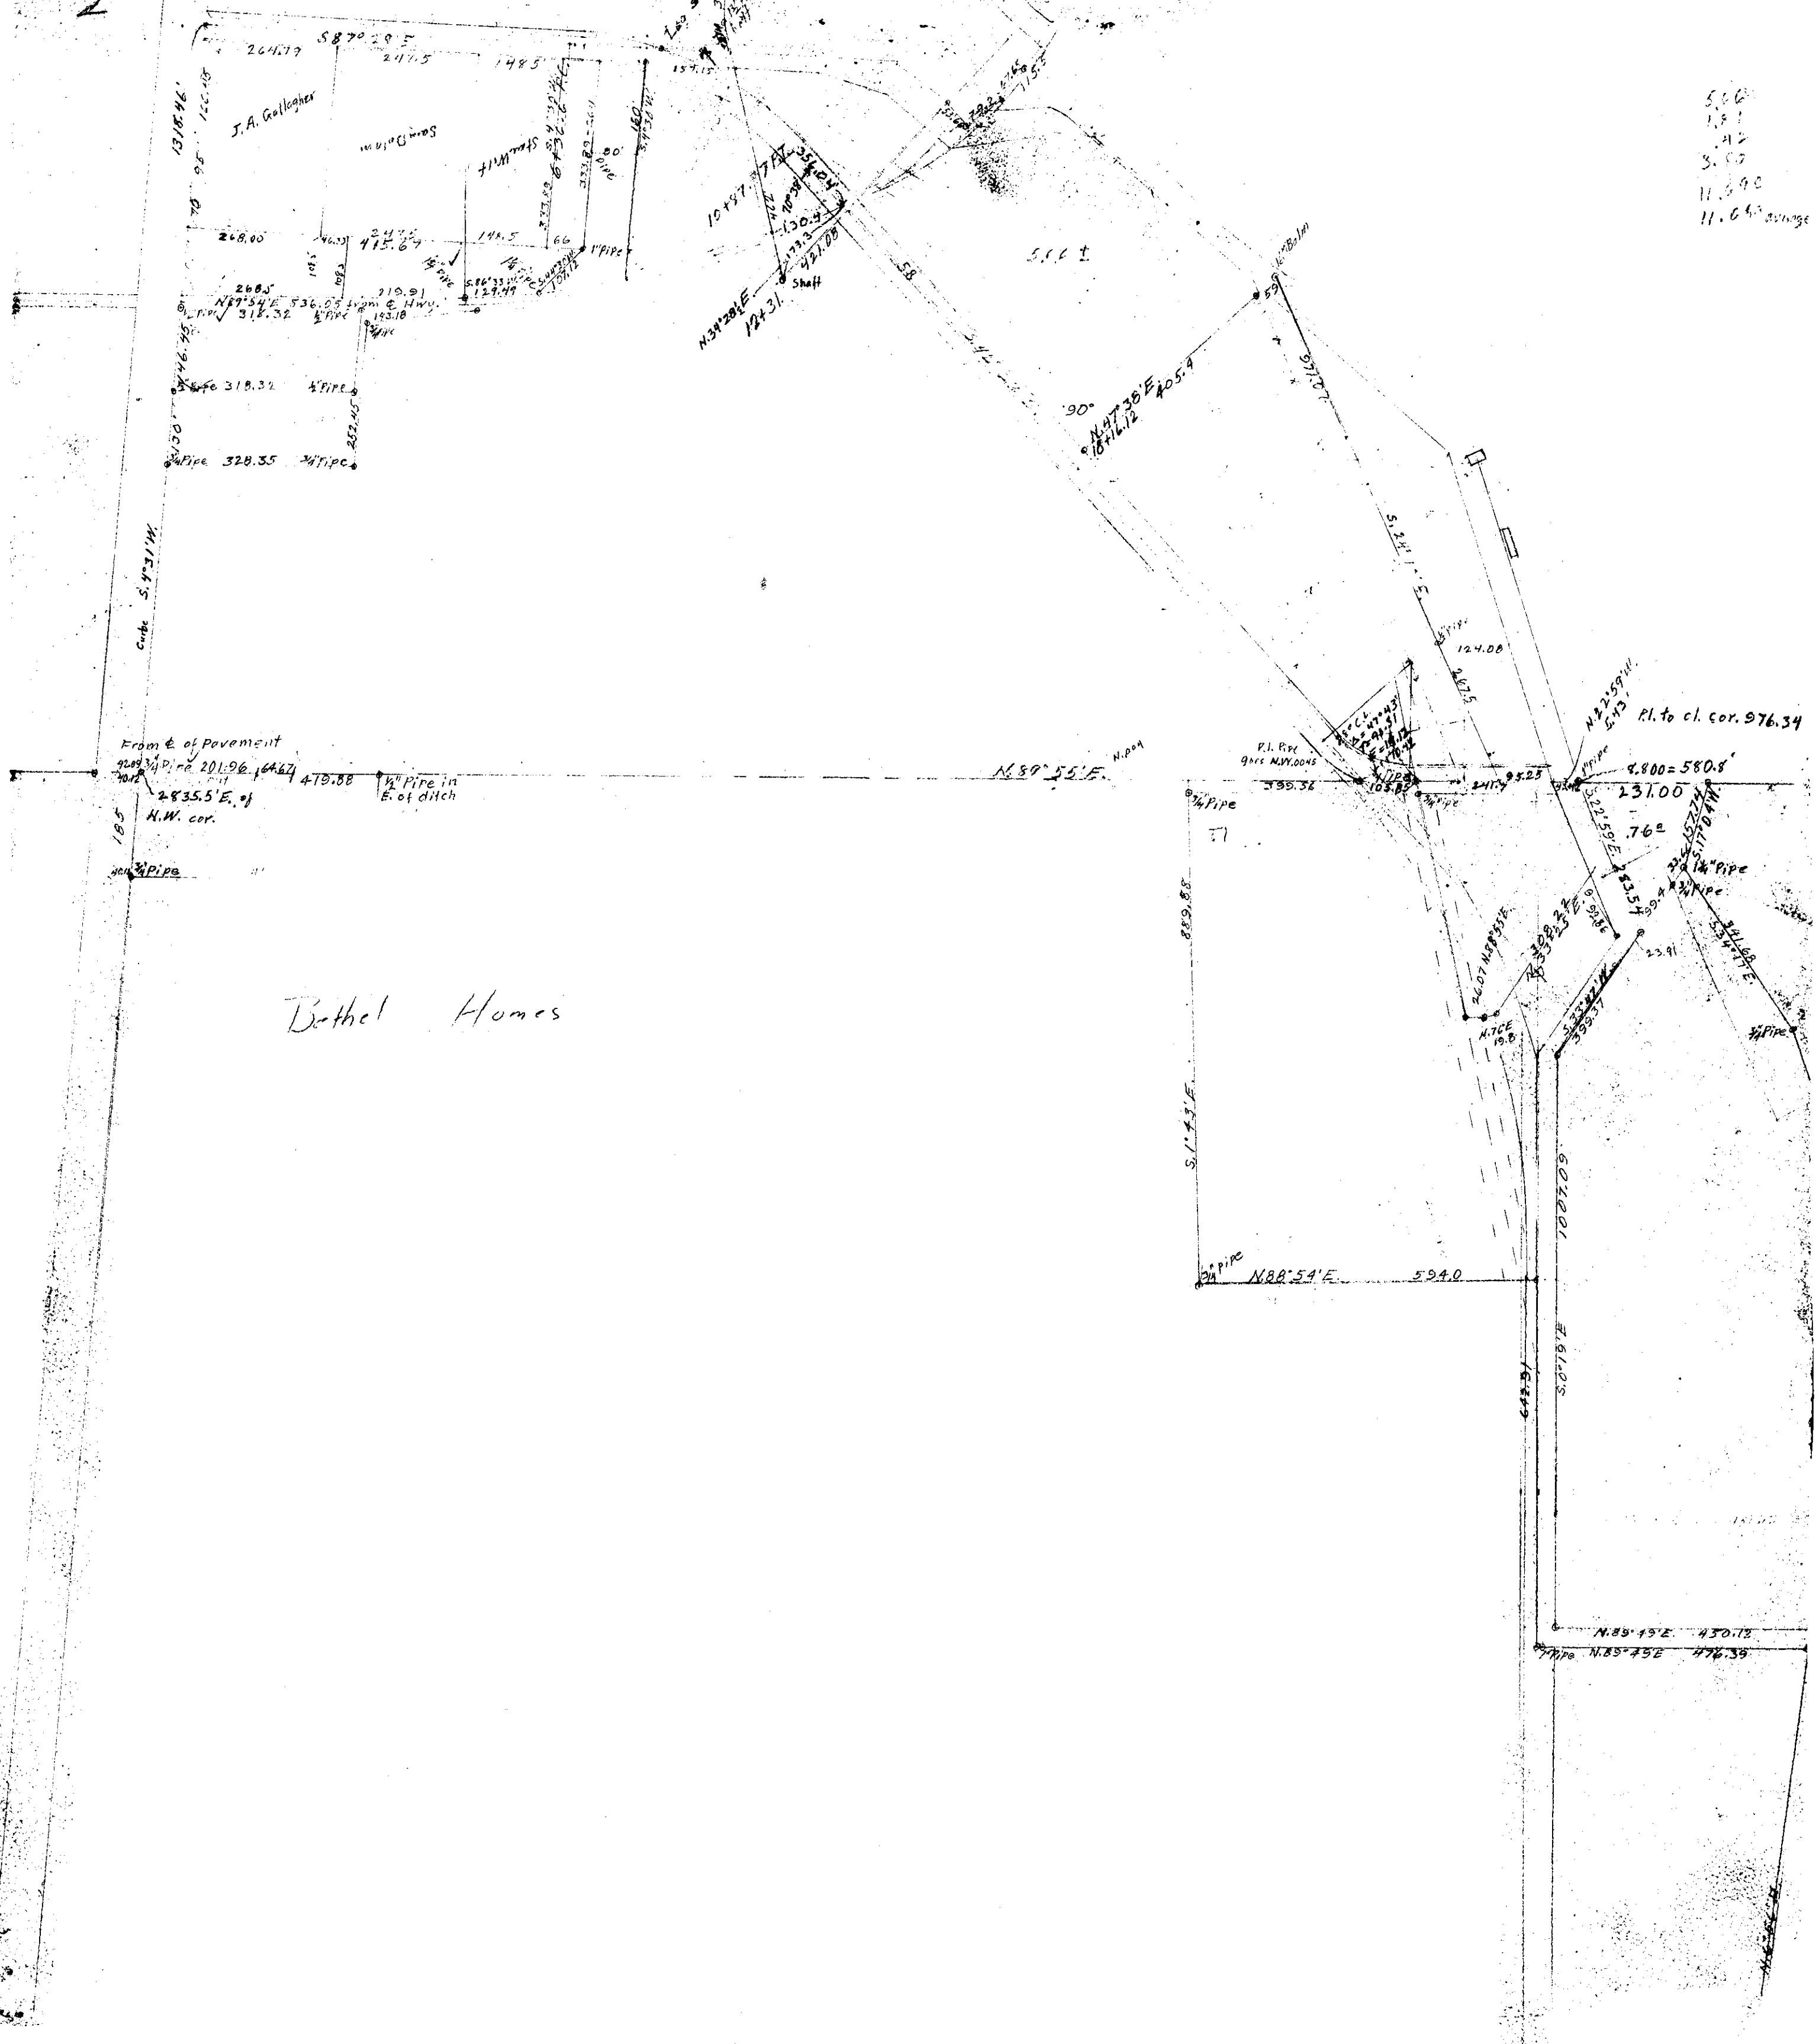

Bethel Homes