

N 60° E 4.5 6

COUNTY SURVEY NO. 144

Alford Henson Cl 67  
7123 R 6 W Will Mar  
1" = 6 chs.

M.C. Galloway  
June 1920


PRELL  
E 1/2  
B 142

Alfred Henson Cl 67

14

Stone 14x12x18  
Oak 18" N 9° E 187  
Fir 48" N 27° W 215

23.608

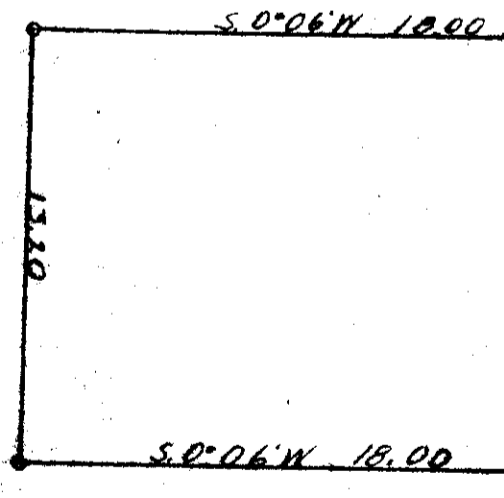

9.193

147  
11.511  
2096  
N 77° W 147.6  
N 77° W 147.6  
N 77° W 147.6

N 0° 08' E 61